


GRANVILLE COUNTY, NC


MAY 16, 2001

ZONED AR-40 WS-IV GW

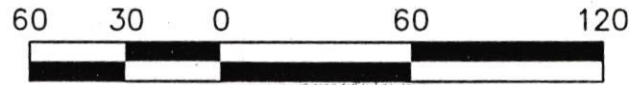

SCALE 1"=60'

Scale 1"=60'

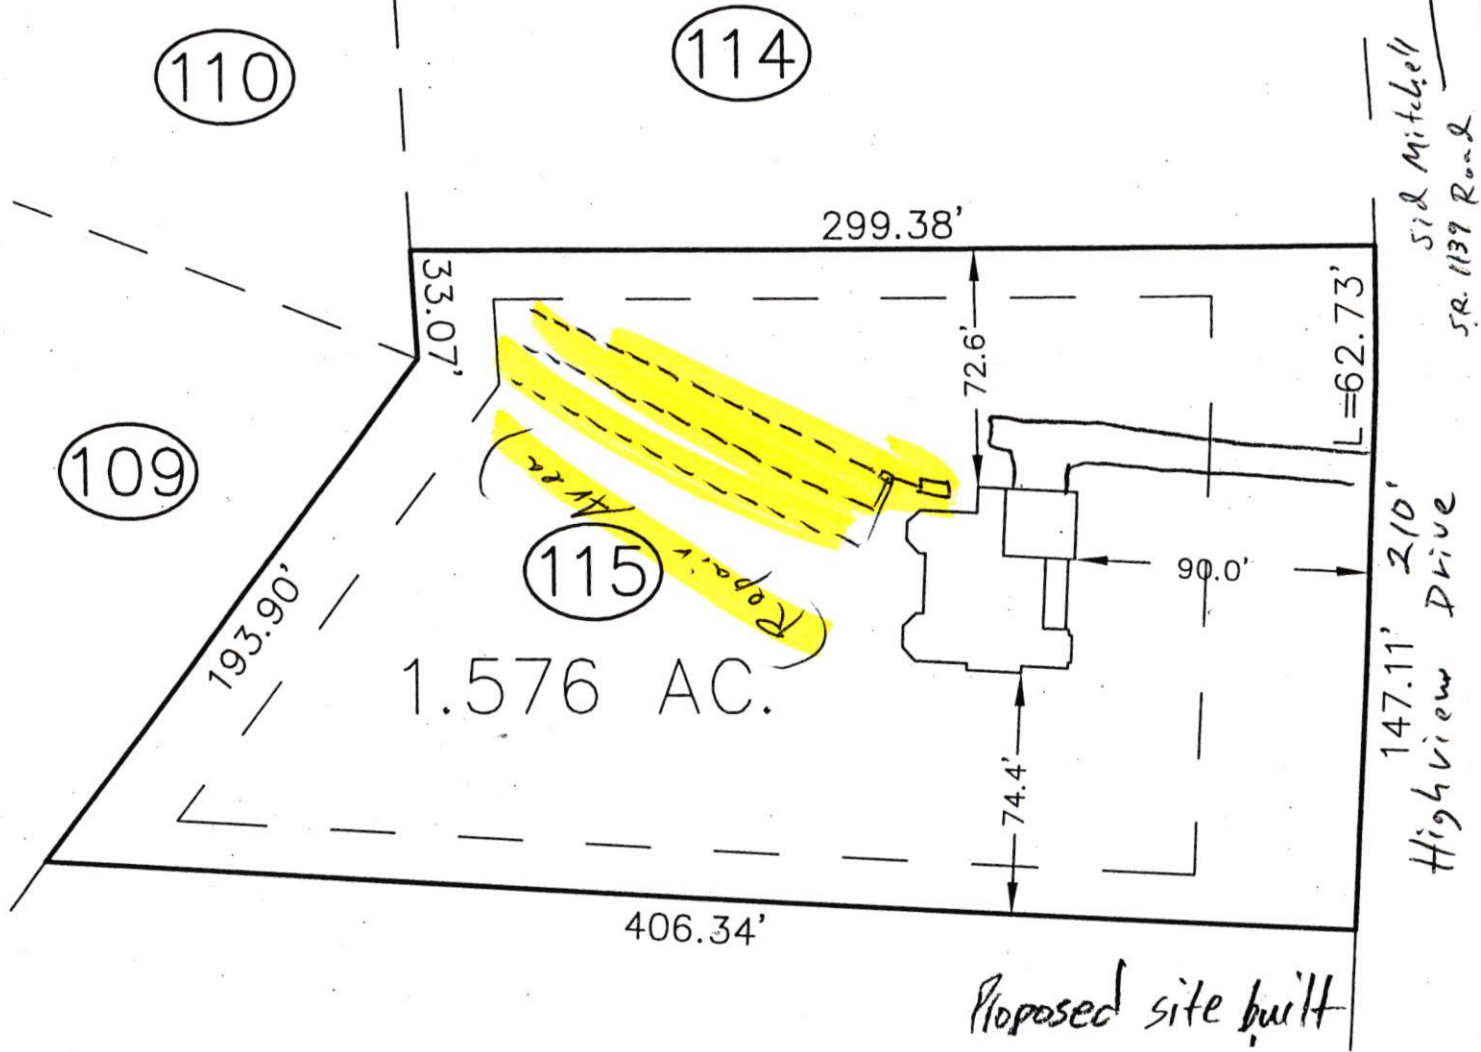

Large Layout on Back


File

PERMIT NUMBER 3044

**GRANVILLE - VANCE DISTRICT HEALTH DEPARTMENT
IMPROVEMENT AND OPERATION PERMITS**

COUNTY:	TAX NO. <u>183300</u> <u>321557</u>	TYPE OF ESTABLISHMENT			*THIS PERMIT SHALL BE ACCOMPANIED BY A LAYOUT SHOWN ON A PLAT, INCLUDING SYSTEM REQUIREMENTS.
<u>Granville</u>	SER NO. <u>1139</u>	RESIDENCE ☒ BUSINESS ☐ OTHER ☐	NUMBER OF BEDROOMS: <u>3</u>	NUMBER OF OCCUPANTS:	
OWNER: <u>John McDaniel</u>					
APPLICANT: <u>Elliott-Stroud LLC</u>		WATER SUPPLY			
APPLICANT'S ADDRESS: <u>25 Summit Ridge Ct.</u> <u>Youngsville, NC 27596</u>		PUBLIC ☐	WELL ☒	OTHER ☐	*THE IMPROVEMENTS PERMIT MUST BE ATTACHED TO A CONSTRUCTION AUTHORIZATION BEFORE OBTAINING BUILDING PERMIT OR OTHER CONSTRUCTION PERMITS AND BEFORE A WASTEWATER SYSTEM IS INSTALLED.
PROPERTY ADDRESS/LOCATION: <u>Highview Drive off</u> <u>Side Mitchell Rd.</u>		TYPE OF WASTEWATER SYSTEM			
		DESCRIPTION	INITIAL ☒ INSTALLATION	REPAIR	
SUBDIVISION: <u>Woodcroft</u>		DESIGN FLOW:	<u>360 gal/day</u>		
LOT NUMBER: <u>115</u>		LTAR:	<u>.35</u>		
REFERENCE SKETCH (SEE PLAT FOR DETAILS) See sketch on back. Dig trenches, 18"-24" deep level on contour. Stay at least 5' from house, 10' from property line + 100' from any well. Do not install or call for inspection in rain.		ABSORPTION AREA:	<u>1056 sq. ft.</u>		
		TRENCH WIDTH:	<u>3'</u>		
		TRENCH SPACING:	<u>9' on center</u>		
		TOTAL TRENCH LENGTH:	<u>350 ft.</u>		
		NUMBER OF TRENCHES:	<u>3-5</u>		
		GRAVEL DEPTH:	<u>12"</u>		
		TANK SIZE:	<u>1000 gal.</u>		
		CONDITIONS:			*THIS IMPROVEMENT PERMIT IS SUBJECT TO REVOCATION IF THE INTENDED USE CHANGE FROM THOSE SHOWN ON THE IMPROVEMENT PERMIT. CHANGES SHALL REQUIRE HEALTH DEPARTMENT APPROVAL.
IMPROVEMENT PERMIT			DATE:		
FOR: <u>John McDaniel/Elliott-Stroud, LLC</u> ISSUED BY: <u>M.E. Young, R.S.</u>			<u>6-8-01</u>		
OPERATION PERMIT			DATE:		
SYSTEM INSTALLED BY: <u>Triangle Pump & Tank</u> ISSUED BY: <u>David Cumber</u>			<u>11-21-01</u>		

NOTE: Make sketch of installation showing location of house, septic tanks, privies, water supplies on adjacent property, etc. Write in measurements in order that installations may be located at later date.

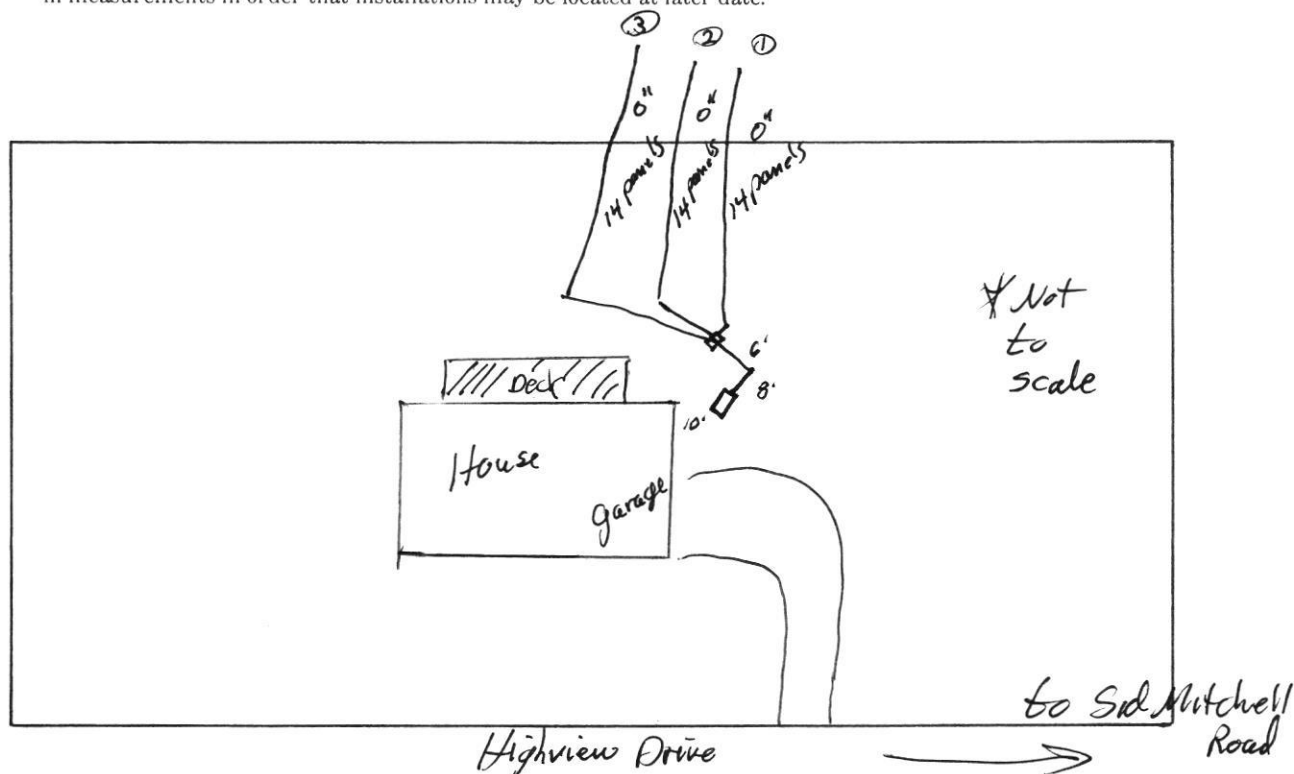

GRANVILLE-VANCE HEALTH DEPARTMENT—Sewage Disposal Record

Owner or Contractor John McDaniel Date 6-8-01 S.R. No. 1139
Location/Address Highview Drive
Subdivision/Mobile Home Park Name Woodcroft Lot Size 1.576 AC
Permit No. # 3044 Lot No. 115

New System ☒ Repair _____
House ☒ Mobile Home _____ Business _____
No. Bedrooms 3 No. People _____ No. Toilets _____
Water Supply: Private ☒ Approved _____
Semi-Public _____ Unapproved _____
Public _____ None _____

Nitrification System:

Tank Size 1000 gal.
Distribution Box yes No. Lines _____
Nitrification Field _____ Sq. Ft.
Lines: 1 2 3 4 5 6
Width 3' 3' 3' _____
Length 14 ponds 14 ponds 14 ponds _____
Grade 0" 0" 0" _____
Stone Depth Chamber System _____

Layout to be followed by installer:

* Sketch on back

Improvements Permit By M. E. Yount Installer Triangle Pump + Tank
Certificate of Completion By David Cumbee Date of Inspection 11-21-01

* Construction must comply with all other applicable state and local regulations, but the permit is not a guarantee that the system will not malfunction and the Granville-Vance Health District will not be held responsible for a malfunctioning system.