

OWNER Brandywine Homes LLC PERMIT # 443051 DATE 7-3-25
CONTRACTOR Trueworks WEATHER CONDITIONS Slightly rainy
SOIL WETNESS 1 inch wet

SEPTIC AND PUMP TANK INSPECTION

SEPTIC TANK	INITIAL	DATE
Manufacturer <u>DB</u>	<u>WTB</u>	<u>7/3/25</u>
Date of Manufacture <u>5/6/25</u>		
Stamp <u>STB 502</u>		
Capacity <u>1000</u>		
Tee <u>/</u>		
Baffle <u>/</u>		
Sealant <u>/</u>		

PUMP TANK		
Manufacture		
Date of Manufacture		
Stamp		
Capacity		
Sealant		
Manhole		
Draw Down Test		

MECHANICAL INSPECTION

PUMP		
Manufacturer and Model #		
Control Panel		
Alarm		
Electrical Connection		

NITRIFICATION/DISTRIBUTION AND DRAINFIELD INSPECTION

DISTRIBUTION BOX <u>(Solid)</u>		
Level		
Equal Distribution		
Other		

DISTRIBUTION MANIFOLD		
Pipe Size		
Gate Valves		
Other		

OTHER DISTRIBUTION
Type _____

NITRIFICATION LINES	LINE 1	LINE 2	LINE 3	LINE 4	LINE 5	LINE 6
Trench Width	<u>3</u>					
Trench Length	<u>305'</u>					
Trench Grade	<u>/</u>					
Stone Depth	<u>222' - 1"</u>					

COMMENTS: E2 flow
N-G + POLY

Granville - Vance District Health Department
Environmental Health

Final Sketch


Pin _____

Cedar Knolls 17

Subdivision - Section - Lot

Physical Address: 3922 Cedar Knolls Dr.

System design and details as installed.

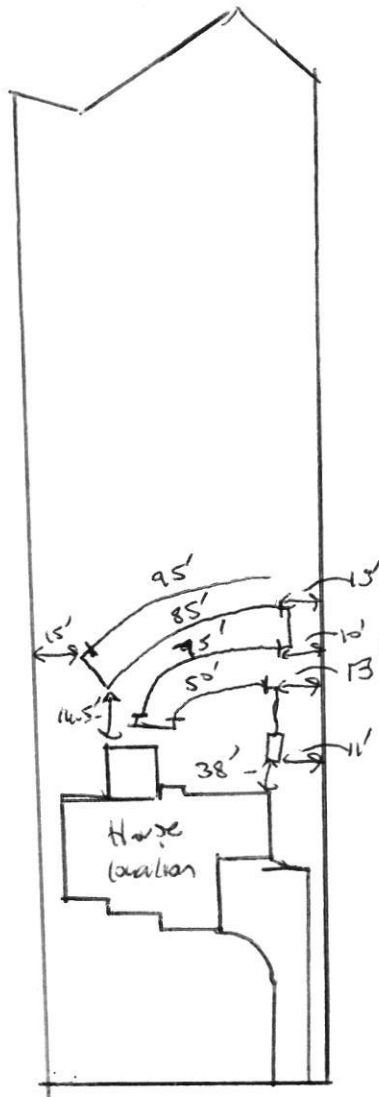

* 305'
total

Cedar Knolls Dr.

Authorized Signature

SEWAGE DISPOSAL SYSTEM INSTALLATION REVIEW

7-3-25

Date: