


Well

Driveway

House

40'  
Ellis  
1000 gal.

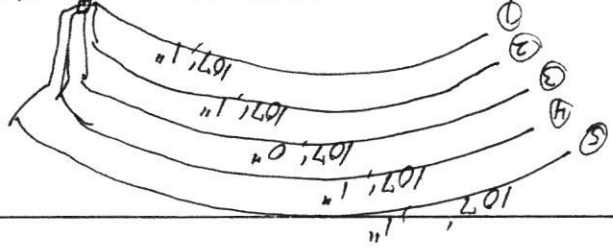

NOTE: Make sketch of installation showing location of house, septic tanks, privies, water supplies on adjacent property, etc. Write in measurements in order that installations may be located at later date.

Roberts Chapel Road  
← To Rangel.

# GRANVILLE-VANCE HEALTH DEPARTMENT—Sewage Disposal Record

Owner or Contractor Mike Arrington Date 12-15-03 S.R. No. 1123

Location/Address Roberts Chapel Road

Subdivision/Mobile Home Park Name \_\_\_\_\_ Lot Size 14.87 Acres

Permit No. # 4049 Lot No. \_\_\_\_\_

New System ☒ Repair \_\_\_\_\_

House ☒ Mobile Home \_\_\_\_\_ Business \_\_\_\_\_

No. Bedrooms 4 No. People 2 No. Toilets \_\_\_\_\_

Water Supply: Private ☒ Approved \_\_\_\_\_

Semi-Public \_\_\_\_\_ Unapproved \_\_\_\_\_

Public \_\_\_\_\_ None \_\_\_\_\_

Nitrification System:

Tank Size 1000 gal.

Distribution Box yes No. Lines 5

Nitrification Field 1600 Sq. Ft.

Lines: 1 2 3 4 5 6

Width 3' 3' 3' 3' 3' \_\_\_\_\_

Length 107' 107' 107' 107' 107' \_\_\_\_\_

Grade 1" 1" 0" 1" 1" \_\_\_\_\_

Stone Depth 12" 12" 12" 12" 12" \_\_\_\_\_

Layout to be followed by installer:

\* sketch on back

next to 1086 Roberts

Chapel Rd

Improvements Permit By David Cumbee Installer Cole's Backhoe Service

Certificate of Completion By David Cumbee Date of Inspection 5-21-04

\* Construction must comply with all other applicable state and local regulations, but the permit is not a guarantee that the system will not malfunction and the Granville-Vance Health District will not be held responsible for a malfunctioning system.