

252. 478. 3599

Franklin County Health Department
Division of Environmental Health
107 Industrial Drive-Suite C
Louisburg, North Carolina 27549

PAGE 1 OF 2

Phone: 919-496-8100

SEPTIC PERMIT

Fax: 919-496-8136

Permit Number: 5137

Type: I

PIN:

2831-47-6617

Date:

9/15/2009

Applicant: WILLIAM POTTER
110 BLACKBERRY CREEK DR
WILLOW SPRINGS, NC 27592

Owner: EMMA PARTIN
2000 RALPH STEPHENS RD
HOLLY SPRINGS, NC 27540

Telephone: (919) 946-3258

Telephone:

Subdivision: LAKE ROYALE

Lot Number: 672C

Size: 0.140

Physical Address/ Location /Directions 128 CREEK DR

Description: LifeTime _____ 5 Year X

TYPE FACIL Comper # EMPLOY - # BEDRMS - GPD 240 LTAR 49/d
TYPE WAT Com TYPE SYS I TYPE REP N/A BSMT N BST FX N/A
SIZE TANK 900 SIZE CHB - SIZE NITR 3x150 MTD 24'

COMMENTS: 150' Emulation / Accepted - 1 Massive Rock may be encountered during installation

Septic Contractors are responsible for notifying the health department for final inspections, between 8:00-9:00 AM on the day of completion, Monday - Friday. Any request for final inspections received afterwards will be scheduled the same day, if possible, or the next workday. Have permit number and owner/applicant's name ready when making the call.

Actions of representatives of state or local agencies engaged in the evaluation and determination of measures required to effect the compliance with the provisions of this permit shall in no way be taken as a guarantee that wastewater disposal systems permitted and approved will function in a satisfactory manner for any given period of time, or that such employees assume any liability for damages, consequential or direct which are caused, or may be caused, by a malfunction of this wastewater treatment and disposal system.

Proper precautions must be taken to assure the proper functioning of the system after it has been covered. Do not run any heavy equipment over the system, as soft earth will allow damage to the tank and lines. Pipe all roof drains away from the septic system site to prevent flooding of the lines from surface water. Terrace the ground to prevent excessive drainage from higher areas adjacent to the system. Do not construct driveways over any part of the septic system unless proper provisions were made when the septic system was constructed. Only grass, not trees or shrubbery, should be cultivated over the lines. All plumbing fixtures should be carefully inspected periodically and any problems repaired immediately. All septic tanks should be pumped off by a permitted pump operator on a regular schedule, not to exceed every five years.

The improvement permit and construction authorization is a site approval, for the future installation of a wastewater treatment and disposal system. Changes in ownership of the site do not affect the validity of this permit. However, any alteration of the site or soil conditions, changes in the location of the proposed facility, changes to the wastewater flow and/or characteristics, or submittal of false information with the application or misrepresentation of the property lines may subject this permit to suspension or revocation.

FOR THIS TO BE A VALID CONSTRUCTION AUTHORIZATION, A LAYOUT SHEET MUST BE ATTACHED
IMPROVEMENT PERMIT DATE 9/16/09 EHS [Signature]
CONSTRUCTION AUTHORIZATION DATE 9/16/09 EHS [Signature]
Visit www.franklincountyenvironmentalhealth.com for permit information and tracking.

Franklin County Health Department


Name: POTTER

Permit Number

5137

CONTRACTOR DB & Sons TANK MANU DB 1000 MANU DATE 1-19-10WELL INSTALLED YES _____ NO X SYSTEM CODE ED203T-W-GSEPTIC SYSTEM LAYOUT
(SKETCH SYSTEM LAYOUT HERE)

Permit not to scale

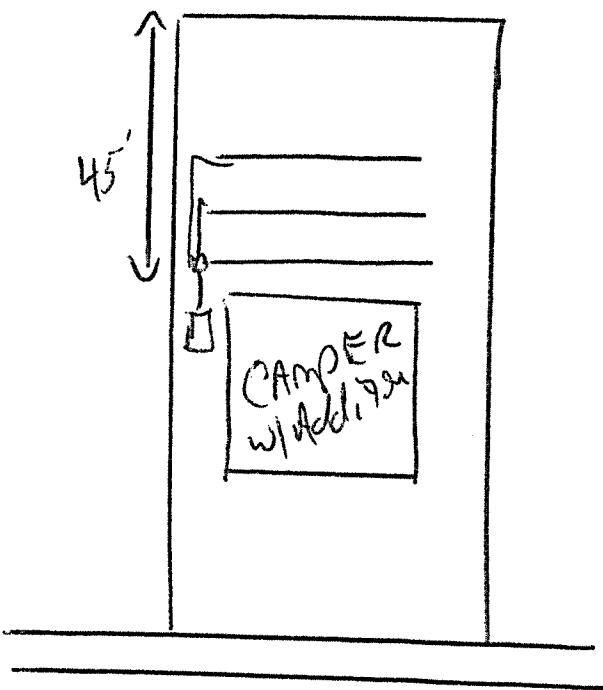

SEPTIC SYSTEM AS-BUILT

(IF DIFFERENT FROM INITIAL LAYOUT)

ON REVERSE

OPERATIONS PERMIT

DATE

4-19-10

EHS

ENVIRONMENT HEALTH APPLICATION (496-8100)

Permit #: **26364**Permit Type: **SEPTIC PERMIT**Date Issued: **09/15/2009**Project Address: **128 CREEK DR, LOUISBURG NC 27549**Location: **128 CREEK DR**Size #: **0.140**Subdivision: **LAKE ROYALE**Lot #: **672C**Applicant: **POTTER WILLIAM**
110 BLACKBERRY CREEK DR
WILLOW SPRINGS NC 27592Phone: **919.946.3258**Owner Name: **PARTIN EMMA R**

Phone:

Owners Address: **2000 RALPH STEPHENS RD****HOLLY SPRINGS NC 27540**Tax record: **22243**Pin #: **2831-47-6617**Parcel #: **LR0702 0672C**Zoned: **A R**Setbacks Front: **30**Rear: **5**Side: **5**Proposed Use: **CAMPER LOT**# of bedrooms: **2**# of people: **2**Township: **CYPRESS**Public Water/Sewer: **TESI (LK ROY)**

ST Road #:

Desc:

Fees Due: **\$325.00**Date Paid: **09/15/2009***** Please complete all sections below***

☐ Yes ☒ No Does this site contain any previously identified jurisdictional wetlands?
☐ Yes ☒ No Is any wastewater, other than domestic, going to be generated?
☐ Yes ☒ No Is the site subject to approval by any other public agency?

*If the answer to any of the above is "yes", applicant must submit supporting documentation.

Please indicate desired system type(s). Systems can be ranked in order of preference.

☐ Conventional ☐ Accepted ☐ Modified Conventional ☐ Alternative
☐ Other ☒ No Preference

Call Environmental Health (919.496.8100) between 8:00 - 9:00 am Monday - Friday in order to schedule an appointment with an environmental health specialist for your lot evaluation. This application for an improvement permit/construction authorization and well permit does not constitute approval for zoning, septic or building permits. It will be necessary to meet all guidelines for zoning, septic and building permits prior to construction. The permit is valid for either 60 months or without expiration, depending upon documentation submitted. (complete site plan=60 months---complete surveyed plat=without expiration.)

Please contact the Environmental Health Department at 919.496.8100 or visit their website at www.franklincountyenvironmentalhealth.com to determine the status of your application prior to contacting the Planning & Inspections Department.

I hereby certify that I am the owner, or authorized by the owner to act as his/her legal representation. Furthermore, as legal representative (if applicable) I have advised the owner of my intention to apply for this wastewater treatment and disposal system and drinking water and well system permit.

I also certify that all of the statements made in this application and any attached documents are true, complete, and correct, to the best of my knowledge and belief, and are made in good faith. If information in this application for these improvements is falsified, changed or site is altered, then improvement permits and authorization to construct these improvements shall become invalid. Authorized county representatives are granted right of entry to make these evaluations or inspections, and to release information upon public request.

X William S. Potter William S. Potter
Print & Signature of Owner or Owner's Legal Representative

09/15/2009

Franklin County DRC Permit RESIDENTIAL

Zoning Permit #: 14810



ADDRESS: 128 CREEK DR

PARCEL NO.: 2831-47-6617

ZONING: A R

SUBDIVISION: LAKE ROYALE

LOT: 672C

ISSUED TO: POTTER WILLIAM

110 BLACKBERRY CREEK DR

WILLOW SPRINGS, NC 27592

PHONE NUMBER: 919-946-3258

SETBACK: FRONT: 30

RIGHT: 5

LEFT: 5

REAR: 5

COUNTY WATER: TESI

FLOODPLAIN: NO

MISC FEE:

PERMIT TYPE: ZONING PERMIT

TYPE OF CONSTRUCTION: CAMPER LOT - NEW SEPTIC

PERMIT DATE: 09/15/2009

WATERSHED NO

TOWNSHIP CYP

EXPIRE DATE: 03/15/2010

It is hereby certified that the above use as shown on the plats and plans submitted with this application conforms with all applicable provisions of the Franklin County Zoning Ordinance. The issuance of this application does not allow the violation of Franklin County Zoning Ordinance or other governing regulations. The applicant is responsible for obtaining a building permit (if required) prior to commencing work on the proposed improvement. A final zoning inspection must be scheduled by the applicant.

NOTES:

I hereby certify that all information I have provided to the Planning Department is true and accurate.

APPLICANTS SIGNATURE:

[Signature]

UTILITY COMPANY: PROGRESS ENERGY WAKE ELECTRIC OTHER

NUMBER OF STORIES: 1 _____ 1 1/2 _____ 2 _____ 2 1/2 _____

SQUARE FOOTAGE: HEATED _____ UNHEATED _____ TOTAL _____

BASEMENT: YES _____ NO _____

FIREPLACE: NO _____ MASONRY _____ MANUFACTURED _____

PLAN SETS: MODULAR _____ STICKBUILT _____

NAME OF:

ELECTRICIAN: _____ MECHANICAL: _____

PLUMBING: _____

COST OF CONSTRUCTION: _____

NO MORE THAN 2 STRUCTURAL DEVIATIONS OR PLANS MUST BE REDRAWN

DEPARTMENTAL USE ONLY

	INITIALS (IN)	DATE	INITIALS (OUT)	DATE
ZONING	<i>TWD</i>	<i>9-15-09</i>	_____	_____
INITIAL PERMITTING	_____	_____	_____	_____
ADDRESSING	_____	_____	_____	_____
PLAN REVIEW	_____	_____	_____	_____
FIRE REVIEW	_____	_____	_____	_____
SEPTIC/SEWER	_____	_____	_____	_____
FINAL PERMITTING	_____	_____	_____	_____

Lot C672 / Creek Dr

