

TIME RECEIVED
May 26, 2017 at 11:05:05 AM EDT

REMOTE CSID
9196030106

DURATION
73

PAGES
2

STATUS
Received

05-26-17;10:04AM;From:GV Environmental Health To:919196534920 ;9196030106

1/ 2

PERMIT NUMBER 07733

GRANVILLE-VANCE DISTRICT HEALTH DEPARTMENT *Zoning # 18122*
IMPROVEMENT AND OPERATION PERMITS

COUNTY:	TAX NO.	TYPE OF ESTABLISHMENTS			*THIS PERMIT SHALL BE ACCOMPANIED BY A LAYOUT SHOWN ON A PLAT, INCLUDING SYSTEM REQUIREMENTS.
Granville	182500307981	RESIDENCE ☒	NUMBER OF BEDROOMS:	NUMBER OF OCCUPANTS:	
	SR. NO.	BUSINESS ☐	7	8 may	
	OWNER: Pinnacle Builders	OTHER ☐			
APPLICANT'S ADDRESS:		WATER SUPPLY	WELL PUBLIC ☒	OTHER ☐	*THIS IMPROVEMENT PERMIT IS SUBJECT TO REVOCATION IF THE INTENDED USES CHANGE FROM THOSE SHOWN ON THE IMPROVEMENT PERMIT. CHANGES SHALL REQUIRE HEALTH DEPARTMENT APPROVAL.
210 Barnhill Ln. Wake Forest 27587		TYPE OF WASTEWATER SYSTEM	INITIAL INSTALLATION	REPAIR	
PROPERTY ADDRESS/LOCATION:		DESIGN FLOW:	450 gpd		
Drogs Valley Ln.		LTAR:	285 gpd/ft ²		
SUBDIVISION:		ABSORPTION AREA:	1659 ft ² → 1263 ft ²		
@ Smith Creek phase 3-B		TRENCH WIDTH:	3'		
LOT NUMBER: 100		TRENCH DEPTH:	*22"		
REFERENCE SKETCH (SEE PLAT FOR DETAILS)		TRENCH SPACING:	9' O.C.		
* Call Health Dept. prior to installation 919 693-2688 for backhoe pit eval. to verify trench depth		TOTAL TRENCH LENGTH:	415'		
- Follow top chart		NUMBER OF TRENCHES:	6		
- avoid repair area with supply line		GRAVEL DEPTH:	As per status		
		TANK SIZE:	1200 g.p.		PERMIT VALID FOR 5 YEARS YES ☒ NO ☐
		PUMP/TANK SIZE:	1200 g.p.		NO EXPIRATION YES ☐ NO ☒
		DISTRIBUTION DEVICE:	Pressure manifold		

IMPROVEMENT PERMIT

DATE:

FOR:

ISSUED BY:

Pinnacle Builders
David Clark

2-28-14

CONSTRUCTION AUTHORIZATION FOR IMPROVEMENT PERMIT# 7733

Unless otherwise indicated, the same conditions above apply regarding system type, layout, location and installation requirements.
(The wastewater system cannot be installed until authorization is signed)

Comments:

Install in dry conditions

Date:

2-28-14

Environmental Health Specialist:

David Clark

Construction Authorization Addendum

☐ Yes ☒ No

OPERATION PERMIT

DATE:

6-5-14

SYSTEM INSTALLED BY:

ISSUED BY:

L. P. Wells
David Clark

PERFORMANCE, MONITORING, MAINTENANCE AND OPERATION
AS REQUIRED BY RULE .1961

Granville - Vance District Health Department
Environmental Health
Well Construction Permit

01195

Owner/Applicant: Pinnacle Builders Date: 2-28-14
 Address or Location of Property: Bragg Valley Ln.


Subdivision & Lot #: The Preserve Ph 2-Lot 100 Septic Permit #: 7733
 Zoning Permit #: 18122 Environmental Health Specialist: David P. Carter

This well permit is to locate and site the area that a private groundwater well may be established on the property listed above by the Environmental Health Specialists of Granville County. If one does not locate the well in the approved area and complete the well as specified by the 15A NCAC .02C rules, then permits may be revoked. At completion of drilling of the well, grout must be witnessed by EHS and a well log turned into Environmental Health.

Minimum Setbacks: (these are the main setbacks, but not all required setbacks)

Setback from property lines – 10 ft Setback from septic tank and drain field, including repair area – 100 ft
 Setback from structural foundations – 25 ft Setback from ponds, lakes or other bodies of water – 50 ft

Site Sketch:

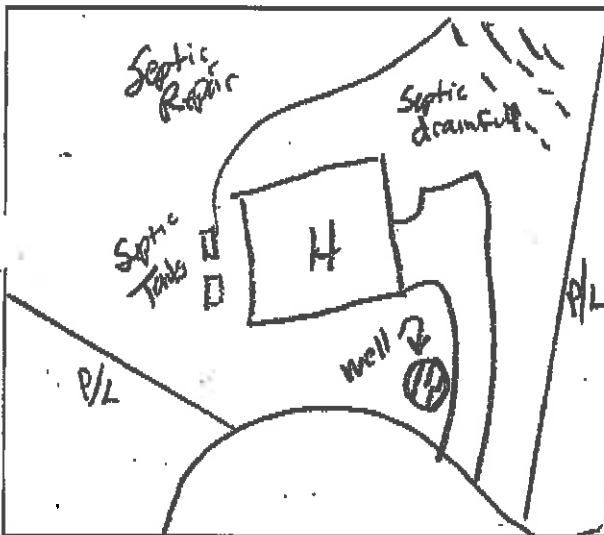

Conditions: Call 919-693-2688
w/ questions

Authorized Agent: David P. Carter
 Date: 2-28-14

1 Well Grout: (Circle or write in)
 Witnessed: Yes or No EHS Agent: David Carter
 Date: 5-16-14 Annular Space Open: Yes or No
 Over reamed: Yes or No No Depth Grouted: 420'
 Method: Pump X Poured Pressure
 Well Log received: Yes or No (EHS to Attach to Permit)
 Driller Name: Stephens Cert. #
 Depth: 485' Casing Depth: 77' GPM: 4

2 Well Final: (Place a check mark when finalized)
 Seal Present and Intact: ✓ Air Vent: ✓
 Hose Spigot: ✓ Electrical Box: ✓
 Pump Installer Tag: ✓ Well Installer Tag: ✓
 All holes sealed: ✓ 12" above grade: ✓
 Comments: 10 bags Hole Plug Portland cap

3 Well Completion Permit: David P. Carter EHS
 Date Completed: 6-10-14

4 Water Samples Taken: Date: 6-10-14
 EHS: DE Results:
 Retest: Results:

As Built Drawing:

