

FRANKLIN COUNTY HEALTH DEPARTMENT

PERMIT NUMBER: 16743C CONST IMPROVE PERMIT		DATE: 20020815	2802-16-3335 2802 16 3439	SIZE: 0.700A
APPLICANT: HOMEBOYS HOUSING CENTER 2495 US HWY 1-158 N HENDERSON NC 27536		OWNER: VENTURES OF		
TELEPHONE: 252-430-1042				
COMMENT: MH		DESCRIPTION: 5 YEAR ☒		LIFETIME: ☐
LOCATION / DIRECTIONS: GREENBRIAR # 12 13 ROUGH LANE				
FEE: 225.00		SIGNATURE OR OWNER OR AUTHORIZED AGENT:		

THE ABOVE SIGNATURE INDICATES THAT I HAVE READ, UNDERSTAND, AND AGREE WITH ALL PROVISIONS AND INFORMATION AS OUTLINED ON THE BACK SIDE OF THIS FORM


TOPO <u>PS</u>	TEXTURE <u>PS</u>	STRUCTURE <u>PS</u>	DEPTH <u>PS</u>
R. HOR <u>PS</u>	SOIL. WET <u>PS</u>	AVAIL. SP <u>PS</u>	OTHER <u>PS</u>
MINRL <u>PS</u>	OVERALL <u>PS</u>	LTAR <u>0.35</u>	
#BEDRMS <u>4</u>	GPD <u>480</u>	DISPOSAL <u>3'x40'</u>	TYPE. SYS <u>CONV.</u>
SZ. TANK <u>1000gal</u>	SZ. CHAMB	NITRIFI <u>3'x40'</u>	TYPE. WAT <u>FRV</u>
SITE. LOC	MAX TRENCH DEP <u>28"</u>	TYP. FAC <u>SFD</u>	

REMARKS: *DRAWING Not to Scale

CONTRACTOR: _____

TANK MANUF: _____

MANUF DATE: _____

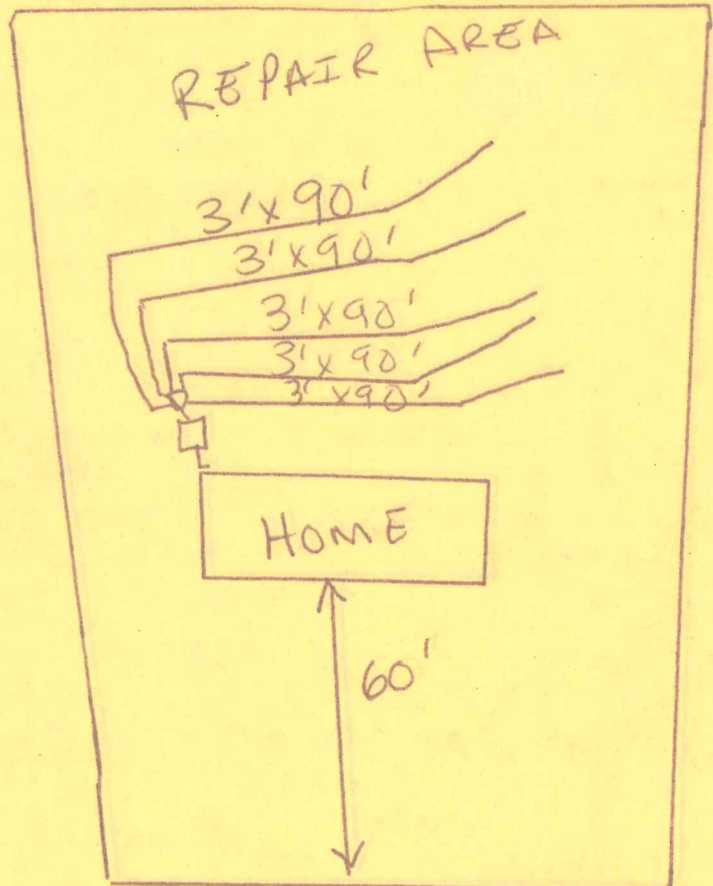

IMPROVEMENT PERMIT DATE: 8/15/02

ROUGH LANE
ENV HEALTH SPEC: Andy Smith