


FRANKLIN COUNTY HEALTH DEPARTMENT

919 336 8178

PERMIT NUMBER:	DATE:		
4841 IMPROVEMENTS PERMIT	12.05.95	5211-29	SIZE: 92A
APPLICANT: HAYWOOD MARGARET D 209 SELKIRK PLACE DURHAM NC 27707 TELEPHONE: 489-3189		OWNER: HAYWOOD MARGARET D 209 SELKIRK PLACE DURHAM NC 27707	
COMMENT: SFD		CONTRACTOR: GARFIELD MALLS	
LOCATION / DIRECTIONS: COLONY RIDGE #29			
FEE: 100.00 1045		SIGNATURE OF OWNER OR AUTHORIZED AGENT:	
THE ABOVE SIGNATURE INDICATES THAT I HAVE READ, UNDERSTAND, AND AGREE WITH ALL PROVISIONS AND INFORMATION AS OUTLINED ON THE BACK SIDE OF THIS FORM			

#BEDRMS 3 DISPOSAL OTHER TYPE. SYS C
SZ. TANK SZ. CHAMB NITRIFI OPER. REQ
SITE. LOC

REMARKS: *Sanitary System 34" Max Ø * Stay 10' from
Property lines, 5' from Building foundation and
100' from any Well

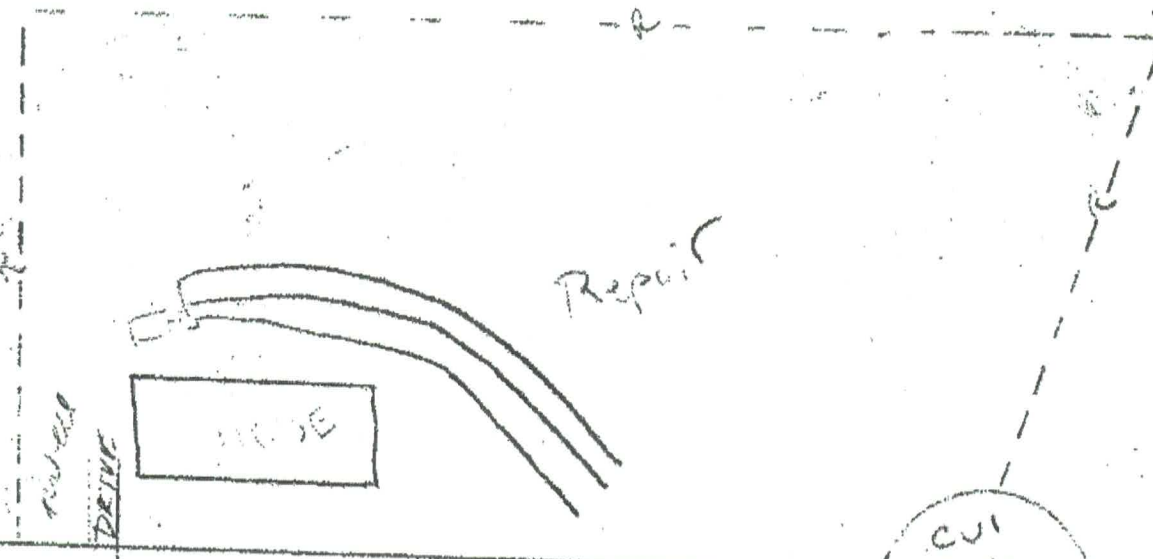

DATE ISSUED 12/19/95
DATE APPROVED 9-26-97

EH SPECIALIST

EH SPECIALIST