



OPERATION PERMIT

Franklin County Health Department
107 Industrial Drive
Louisburg, NC 27549
Phone:

For Office Use Only

*CDP File Number 411635 - 1
County ID Number: _____
Evaluated For: NEW

Property Owner: ICG Homes
Owner Address: 4020 Wake Forest Road
Suite 306
City: Raleigh
State/Zip: NC/ 27609
Phone #: _____
Address: 25 Chestnut Oak drive
Youngsville, NC 27596
Road #: _____
Township: _____
Subdivision: _____
Phase : NEW Lot: _____

Structure: SINGLE FAMILY
of Bedrooms: 4
of People: 5
Water Supply: PUBLIC
Saprolite System?: ☐ Yes ☒ No
Pump Required?: ☐ Yes ☒ No
Design Flow: 480
System Classification/Description: TYPE III G. OTHER
NON-CONV. TRENCH SYSTEMS

Installer: DBS

Certification #:

Specific System EZFLOW EZ 1203H-GEO

Installed:

Septic Tank Date: 11/21/2024

STB: 502

Pump Tank Date: _____

PT:

Comments:

This system has been installed in compliance with applicable NC General Statutes, Rules for Sewage Treatment and Disposal, and all conditions of the Improvement Permit and Construction Authorization.

PERMIT CONDITIONS:

- I. Performance: System shall perform in accordance with Rule .1301.
- II. Monitoring: As required by Rule .1301.
- III. Maintenance: Ground absorption sewage treatment and disposal systems shall be checked, and the contents of the septic tank removed, periodically from all compartments, to ensure proper operation of the system. The contents shall be pumped whenever the solids level is found to be more than 1/3 of the liquid depth in any compartment.

Other:

Subsurface Operator Required: ☐ Yes ☒ No

If yes, see attached sheet for additional operation conditions, maintenance and reporting.

Operation:

Other:

Authorized State Agent: Jones, Lori

Date of Issue: 11/21/2024

Owner/Applicant: _____




- *Keep tanks and drain lines 10' from property lines.
- *Not a survey.
- *Keep supply lines >5' from property lines.
- *Some lines are flagged longer in the field than lengths indicate.
- *No grading septic area.

System:	
Repair:	
Boring:	
: 1000 Gallon	

System: Gravity to D-Box
Lines: 1-5, (450')
Accepted Status System
0.3 Soil LTAR
24" Trench Bottom

Repair: Gravity to Serial Dist.
Lines: 6-10, (450')
Accepted Status System
0.3 Soil LTAR
20" Trench Bottom

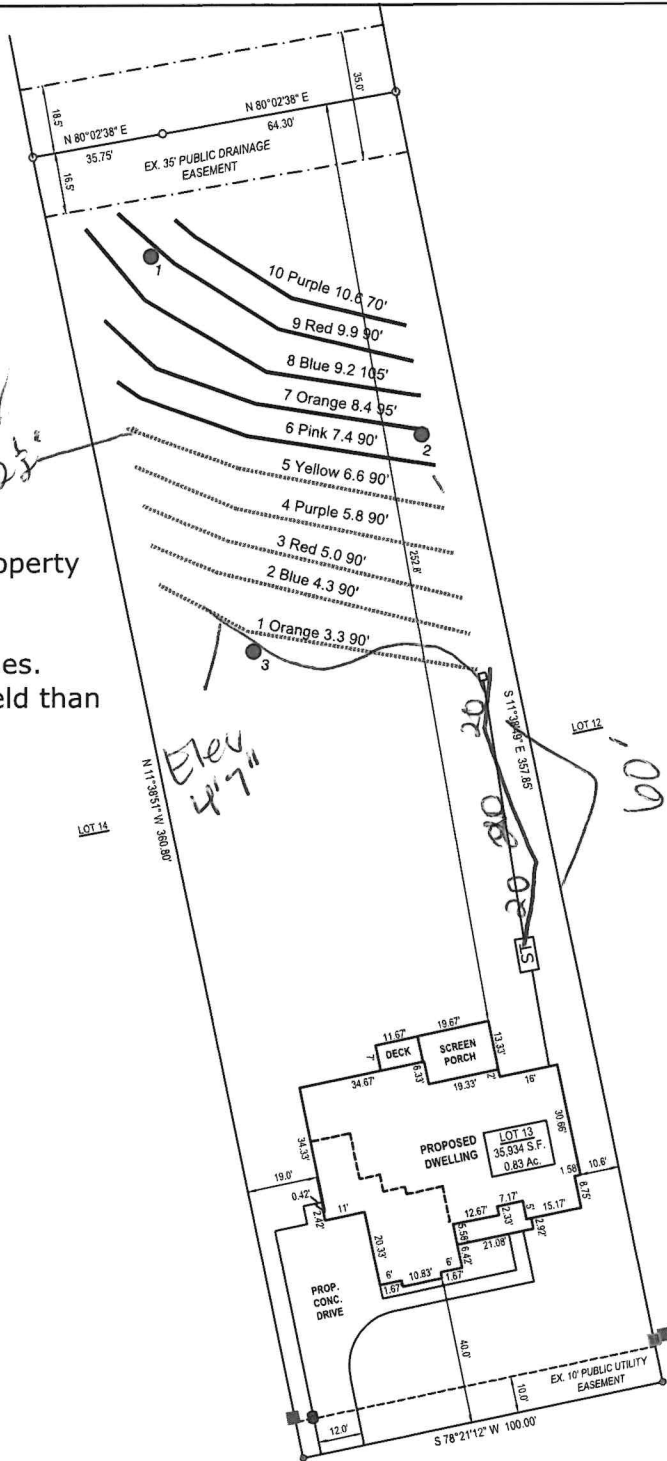

GRAPHIC SCALE
1" = 50'



Central Carolina Soil Consulting, PLLC
1900 South Main Street, Suite 110
Wake Forest, North Carolina 27587
Phone (919)569-6704 Fax (919)569-6703

4-Bedroom Septic Layout
Lot 13, Sorrell Oaks Subdivision
Franklin County, North Carolina

Job# : 4854
Drawn By : LW
Date : 08/25/2023
Revision: 02/24/2024



File# 411635 PIN# _____

Property Address: 25 Chestnut Oak Dr

Applicant Or Owner Name: ICG Homes

Environmental Health Septic/Well Permit Diagram

Building permits cannot be issued nor should construction begin without Construction Authorization issuance.

☒ Septic Improvement Permit ☒ Septic Construction Authorization (CA) ☐ CA Reissue** ☐ As Built
☐ Well Construction Authorization ☒ Additional Diagram/Specifications Attached

Diagram Date**: 4-19-24 EHS: [Signature]

****Any previously dated CA diagram is revoked and/or invalid. Confirm this is the valid diagram for the site before beginning any construction.**

Installation inspections may be scheduled the day before or the day of installation by 9am. Contact the Environmental Health office at 919 496-8100. A revisit fee may apply if installation is not ready for inspection at the time requested.

SEPTIC OPERATIONS PERMITS will be issued after installation is approved, all permit conditions are met, and any outstanding fees are paid. WELL CERTIFICATE OF COMPLETION will be issued after well head approval, all permit conditions are met, and any outstanding fees are paid.

Septic Tank 1000 Pump Tank _____ Drain field 3'x 450' Type System Acc. Max trench depth 24"

Septic Contractor DBS Septic/Pump tank dates DBS 500 PUMP FEE PAID _____
1000

Well Contractor _____ Well Head Date: _____ PUMP FINAL: _____ N/A (CIRCLE)

- IP + C.A issued under "az" rules.
- See attached packet from CCSC.

Filter

EZFlow

Dbox