

FRANKLIN COUNTY HEALTH DEPARTMENT

252-410-5007
6083


PERMIT NUMBER: 17273C CONST IMPROVE PERMIT		DATE: 20030430	2830-44-1109	SIZE: 1A
APPLICANT: EATHON JERRY 1040 PEBBLEBROOK DR LAKE FOREST NC 27587		OWNER: EATHON JERRY		
TELEPHONE: 982-1887		DESCRIPTION: 5 YEAR ☐ LIFETIME: ☐		
LOCATION/DIRECTIONS: LAKE ROYALE #3127 - SACRED FIRE RD 225.00				
SIGNATURE OF OWNER OR AUTHORIZED AGENT:		THE ABOVE SIGNATURE INDICATES THAT I HAVE READ, UNDERSTAND, AND AGREE WITH ALL PROVISIONS AND INFORMATION AS OUTLINED ON THE BACK SIDE OF THIS FORM		

TOPSOIL _____ R. HOR _____ HINRL _____ #BEDRMS _____ SZ. TANK _____ SITE LOC _____ REMARKS: _____	TEXTURE _____ SOIL. NET _____ OVERALL _____ GPD _____ SZ. CHAB _____ SAN TRENCH DEP _____	STRUCTURE _____ AVAIL. SP _____ LTAR _____ DISPOSAL _____ NITRIFI _____ TYP. FAC _____	DEPTH _____ OTHER _____ TYPE. SYS _____ TYPE. WAT _____
---	--	---	--

CONTRACTOR: DB + Sons
 TANK MANUF: DB 1000 ST3 646
 MANUF DATE: 4/1/03

42 panels
2 inch thick

*No well
 Community
 water*

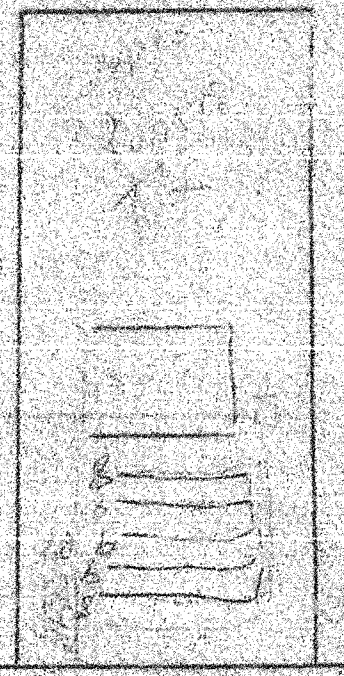

IMPROVEMENT PERMIT DATE: 5/1/03
 CONSTRUCTION AUTHORIZATION DATE: 5/1/03
 OPERATION PERMIT DATE: 8/14/03

ENV HEALTH SPEC: [Signature]
 ENV HEALTH SPEC: [Signature]
 ENV HEALTH SPEC: [Signature]