



IMPROVEMENT PERMIT

Franklin County Health Department
107 Industrial Drive
Louisburg, NC 27549
Phone:

For Office Use Only

*CDP File Number 406769 - 1
County ID Number:
Evaluated For: NEW

PERMIT VALID UNTIL: 03/01/2029

***NOTE TO INSPECTIONS DIVISION:** Building Permits cannot be issued with this Improvement Permit.

Applicant: BULMARO RODRIGUEZ
Address: 5 W MASON ST
City: FRANKLINTON
State/Zip: NC 27525
Phone #:

Property Owner: EL DORADO INVESTMENT GROUP
Address: 12801 CAMP KANATA RD
City: WAKE FOREST
State/Zip: NC. 27587
Phone #:

Property Location & Site Information

Address: 25 GERANIUM DR
YOUNGSVILLE, NC 27596
Subdivision: LILYS MEADOW Block/Phase: NEW Lot: 8

Directions

Road #: 25 GERANIUM DR
Structure: SINGLE FAMILY
of Bedrooms: 4
of People: 4
*Water Supply: N/A

System Specifications

Initial System

Usable Soil Depth: 32

Design Flow: 480

Soil Application Rate: 0.3000

*System Classification/Description:

TYPE II A. CONV SYSTEM (SINGLE-FAMILY OR 480 GPD OR LESS)

*Proposed System:
25% REDUCTION

Minimum Trench Depth: Inches

Maximum Trench Depth: 20 Inches

Septic Tank: 1000 Gallons

Pump Required ☐ Yes ☒ No ☐ May Be Required

Pump Tank: Gallons

Repair System Required: ☒ Yes ☐ No ☐ No, but has Available Space

Repair System

Usable Soil Depth: 32

Soil Application Rate: 0.300

*System Classification/Description:

TYPE II A. CONV SYSTEM (SINGLE-FAMILY OR 480 GPD OR LESS)

*Proposed System: 25% REDUCTION

Minimum Trench Depth: Inches

Maximum Trench: Depth: 20 Inches

Pump Required: ☐ Yes ☒ No ☐ May Be Required

Pump Tank: Gallons

No grading or construction activity is allowed in areas designated for system and repair without approval of Health Department.

*Site Modifications

The issuance of this permit by the Health Department in no way guarantees the issuance of other permits. The permit holder is responsible for checking with appropriate governing bodies in meeting their requirements.

*Permit Conditions

The Department and Local Health Department may impose conditions on the issuance and may revoke the permits for failure of the system to satisfy the conditions, the rules, or this article. This permit is subject to revocation if the site plan, plat, or intended use changes (NCGS 130A-335(f)). The person owning or controlling the system location, installing, operation, maintenance, monitoring, reporting, and repair (per rule .0301(fa)).

Authorized State Agent: Jones, Lori Date of Issue: 03/01/2024



Hand Drawing



Import Drawing

****Site Plan/Drawing attached.****

Total Time: (HH:MM)

 :



Construction Authorization

Franklin County Health Department
107 Industrial Drive
Louisburg, NC 27549
Phone: _____

For Office Use Only

*CDP File Number: 406769 - 1
County ID Number: _____
Evaluated For: NEW

PERMIT VALID UNTIL: 03/01/2029

☐ Open Pump System Sheet

Applicant: BULMARO RODRIGUEZ
Address: 5 W MASON ST
City: FRANKLINTON
State/Zip: NC 27525
Phone #: _____

Property Owner: EL DORADO INVESTMENT GROUP
Address: 12801 CAMP KANATA RD
City: WAKE FOREST
State/Zip: NC, 27587
Phone #: _____

Property Location & Site Information

Address/Road #: 25 GERANIUM DR Subdivision: LILYS MEADOW Phase: NEW Lot: 8
YOUNGSVILLE, NC 27596 **Directions:**
Structure: SINGLE FAMILY 25 GERANIUM DR
of Bedrooms: 4
of People: 4
*Water Supply: _____

System Specifications

Usable Soil Depth: 32 Minimum Trench Depth: _____ Inches
Design Flow: 480 Maximum Trench Depth: 20 Inches
Soil Application Rate: 0.3000 Minimum Soil Cover: _____ Inches
*System Classification/Description: TYPE II A. CONV SYSTEM (SINGLE-FAMILY OR 480 GPD OR LESS) Maximum Soil Cover: _____ Inches
*Proposed System: 25% REDUCTION *Distribution Type: GRAVITY - PARALLEL (eq. d-box)
Nitrification Field: _____ Sq. ft. Septic Tank: 1,000 Gallons
No. Drain Lines: 4 Pump Required: ☐ Yes ☒ No ☐ May Be Required
Total Trench Length: 400 ft. ☐ Inches O.C. Pump Tank: _____ Gallons
☒ Feet O.C. Grease Trap: _____ Gallons
Trench Spacing: _____ - 9 ☐ Inches
Trench Width: _____ - 3 ☒ Feet
Aggregate Depth: _____ inches Septic Tank Installer: ☐ I ☐ II ☐ III ☐ IV
Grade Level Required: ☐ I ☐ II ☐ III ☐ IV

The issuance of this permit by the Health Department in no way guarantees the issuance of other permits. The permit holder is responsible for checking with appropriate governing bodies in meeting their requirements.

*Permit Conditions:

The Authorization for Wastewater System Construction shall be valid for a period equal to the period of validity of the Improvement Permit and may be issued at the same time the Improvement Permit issued (NCGS 130A-336(b)). If the installation has not been completed during the period of validity of the Construction Permit, the information submitted in the application for a permit or Construction Authorization shall become invalid, and may be suspended or revoked (.0204(k)(1)). The person owning or controlling the system shall be responsible for assuring compliance with the laws, rules, and permit conditions regarding system location, installation, operation, maintenance, monitoring, reporting and repair (per rule .0301(a)).

Authorized State Agent: Jones, Lori Date of Issue: 03/01/2024

☒ Hand Drawing ☐ Import Drawing

****Site Plan/Drawing attached.****

Total Time : (HH:MM) _____



File #: 406769 lot # 8

Property Address: 25 Geranium Dr.

Applicant or Owner Name: Bulmaro Rodriguez

Environmental Health Septic/Well Permit Diagram

Building permits cannot be issued nor should construction begin without Construction Authorization Issuance.

☒ Septic Improvement Permit ☒ Septic Construction Authorization (CA) ☐ CA Reissue** ☐ As Built
☒ Well Construction Authorization ☐ Additional Diagram/Specifications Attached

Diagram Date**: 2-28-2024 EHS: Joe Jones

**Any previously dated CA diagram is revoked and/or invalid. Confirm this is the valid diagram for the site before beginning any construction.

Installation/grouting inspections may be scheduled the day before, or, the day of installation until 9am by contacting the Environmental Health office at 919 496 8100. A revisit fee may apply if installation is not ready for inspection at the time requested. Septic Operations Permits will be issued after installation is approved, all permits conditions are met, and any outstanding fees are paid. Well Certificate of Completion will be issued after well head approval, all permit conditions are met, and any outstanding fees are paid.

Septic Tank 1000 Pump Tank na Drainfield 3'x400' Type System Gravity Max Trench Depth 20"

Septic Contractor _____ Septic/Pump tank dates _____ Pump fee? NO YES pd date: _____

Well Contractor _____ Well Head date: _____ (If pump) Final Complete Date: _____


Bedrooms: 4

If Repair: na

Acreage: .84
Parcel ID: 048831

*Drawing not to scale (if large acreage, may be portion)

(If not as built, indicate changes on front or back of sheet.)


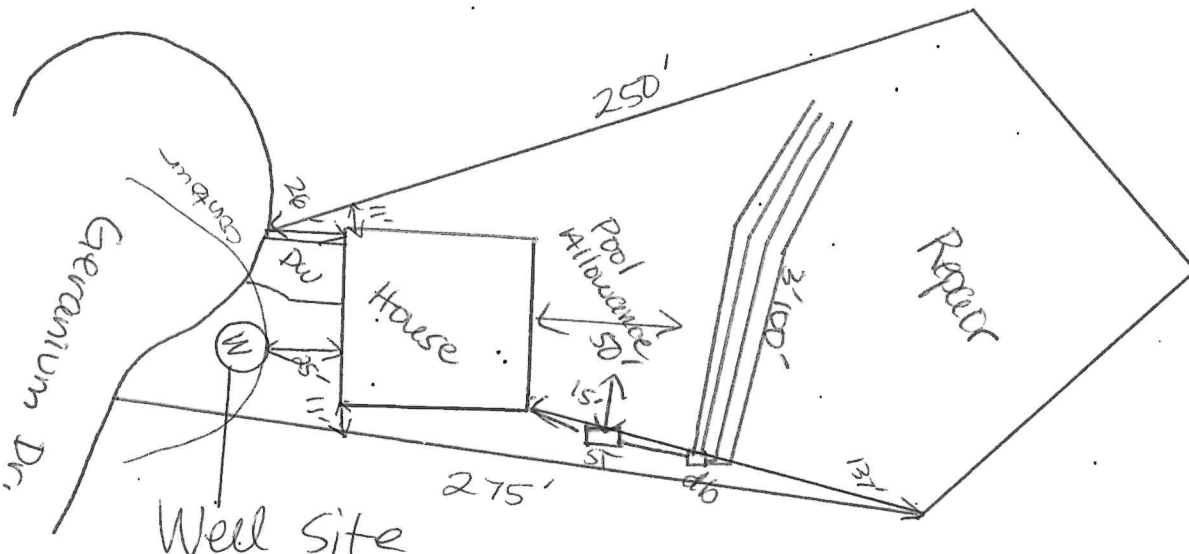


SITE DATA

TOTAL AREA =
(TO BE SUBDIVIDED)
LESS R/W =
LESS OPEN SPACE =
NET AREA =
TOTAL LOTS =
AVERAGE LOT SIZE =
TOTAL ROAD LENGTH
PROPOSED USE -

18.0 AC.
1.7 AC.
3.6 AC.
12.7 AC.
15
0.85 AC.
1393'
RESIDENTIAL SINGLE
FAMILY SUBDIVISION

PRELIMINARY FOR REVIEW PURPOSES ONLY

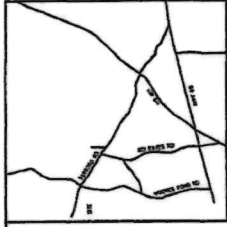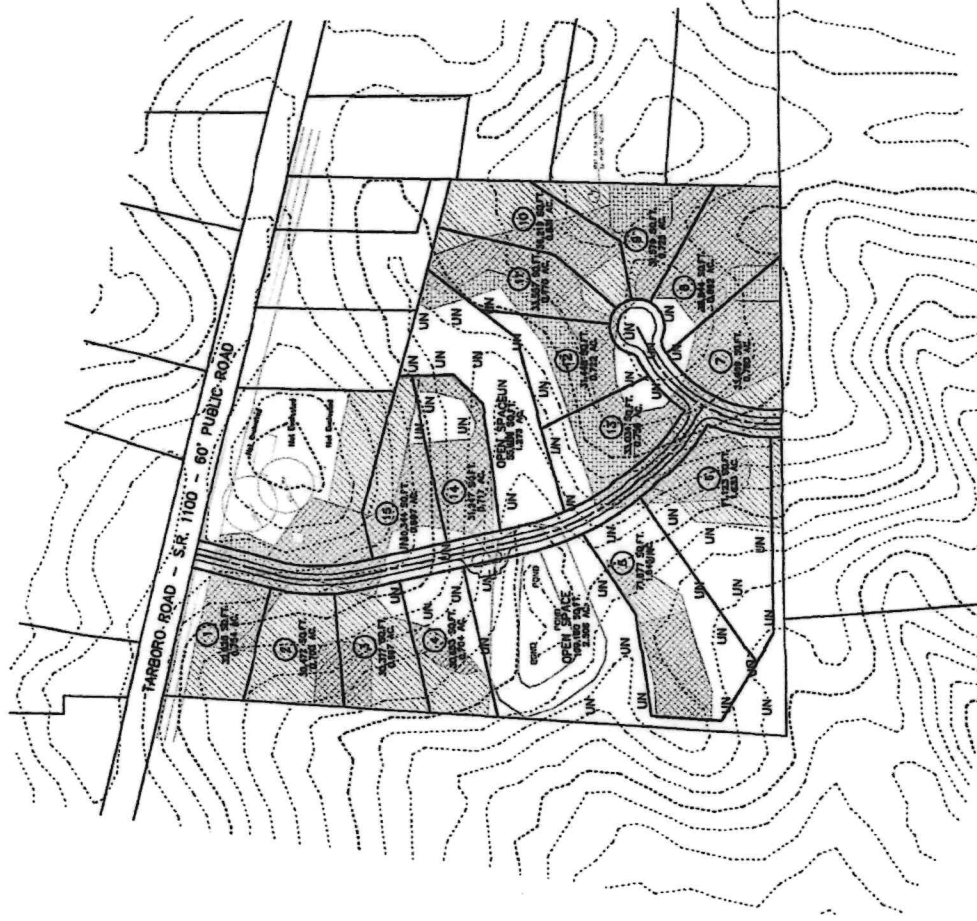

VICINITY MAP

LEGEND
UN = UNIMPROVED
IM = IMPROVED
R/W = RIGHT OF WAY
E = EASEMENT
S = SURVEY
C = CORNER
B = BOUNDARY
L = LOT
R = ROAD
D = DRAINAGE
T = TOWNSHIP
C = COUNTY
S = STATE
F = FEDERAL
N = NATIONAL
I = INTERNATIONAL
O = OTHER

PRELIMINARY SUBDIVISION PLAN FOR
BRC HOMES

OWNER:
REF:
REF:

TOWNSHIP
COUNTY, NORTH CAROLINA
SCALE 1"=100'
JUNE 13, 2019
ZONED R-40
PIN # 1871-18-1205



CMP

PRELIMINARY
FOR REVIEW PURPOSES ONLY

CANTORRE, MOSS & PANCIERA, P.C. PROFESSIONAL LAND SURVEYORS, C-1525, 333 S. WHITE STREET, P.O. BOX 1253, WAKE FOREST N.C., 27588, (919) 556-3148



CDP#
406769

Franklin County Environmental Health
127 S Bickett Blvd.
Louisburg, NC 27549
Phone (919) 496-8100
www.franklincountync.gov

Issued to: **BULMARO RODRIGUEZ**

Location: **25 Geranium Drive YOUNGSVILLE , NC 27596**

**NEW SEPTIC APPLICATION
NEW WELL APPLICATION**

Application Type: **NEW SEPTIC NEW WELL**

Application Number: **E-24-88**

Building Type:

Project Type: Single Family Dwelling

of Bedrooms: 4

Residential Project Type: Single Family Dwelling

Building Foundation: Crawlspace

Water Source: New Well

Date: February 8, 2024

Acreage: 0.84

Zoning: R-30

of Occupants: 4

Commercial Project Type:

Square Footage of Facility:

Number of Employees:

Number of Seats:

lot #8

Preferred Type of Septic System: (1) Conventional
(rock)

Notes:

Parcel ID #: **048831**

Subdivision: LILYS MEADOW LOT

Applicant Information

Applicant Name: BULMARO RODRIGUEZ

Address: 5 W Mason St. Franklinton , NC 27525

Phone: 9194220355

Email: liliumhomesnc@gmail.com

Property Owner Information

Owner Name: EL DORADO INVESTMENT GROUP INC

Address: 12801 CAMP KANATA RD WAKE FOREST , NC 27587

Phone:

Email:

General Contractor Information

Contractor Name: Lilium Homes Inc.

Address: 5 W Mason St. Franklinton , NC 27525

Phone: (919) 605-3275

Email: brodriguez@lilium-homes.com

Zoning

Zoning Permit #: Z-23-103

County Water: No

Front Setback: 30

Right Setback: 10

Left Setback: 10

Rear Setback: 25

The applicant shall notify the Environmental Health Department upon submittal of this application if any of the following apply to the property/site in question. If this answer is "Yes" the applicant must attach supporting documentation and/or show their location on the plot/site plan.

Does the site contain any jurisdictional wetlands? No

Does the site contain, or have within 100 feet, any existing wells and/or septic systems? No

Is any wastewater going to be generate other than domestic sewage? No

Is the site subject to approval by an other public agency? No

Are there any easements or right-of-ways on this site? No

Are there any underground utilities on the site? No

IF THE INFORMATION IN THE APPLICATION FOR A SEPTIC PERMIT IS FALSIFIED, CHANGED, OR THE SITE IS ALTERED, THEN ANY RELATED PERMITS AND CONSTRUCTION AUTHORIZATIONS SHALL BECOME INVALID. This application is valid for one year from the date of application payment. The septic system approval (permit) is valid for five years from the date of Improvement Permit issuance, or without expiration by request with proper documentation. The applicant is responsible for the proper identification and labeling of all property lines, and existing utilities (including septic), and the desired features on site, as well as making the site accessible for evaluation. Authorized county and state officials are granted right of entry to conduct necessary inspections to determine compliance with applicable laws and rules. Permit issuance shall in no way be

PRELIMINARY PLOT PLAN FOR

LILIUM HOMES

LOT 8, LILYS MEADOW SUBDIVISION

25 GERANIUM DRIVE

REF: D.B. 2186, PAGE 253

REF: P.B. 2022, PAGE 195-196

YOUNGSVILLE TOWNSHIP

FRANKLIN COUNTY, NORTH CAROLINA

JANUARY 24, 2022


REVISED FEBRUARY 5, 2024

ZONED R-40

50 25 0 50 100




SCALE 1"=50'

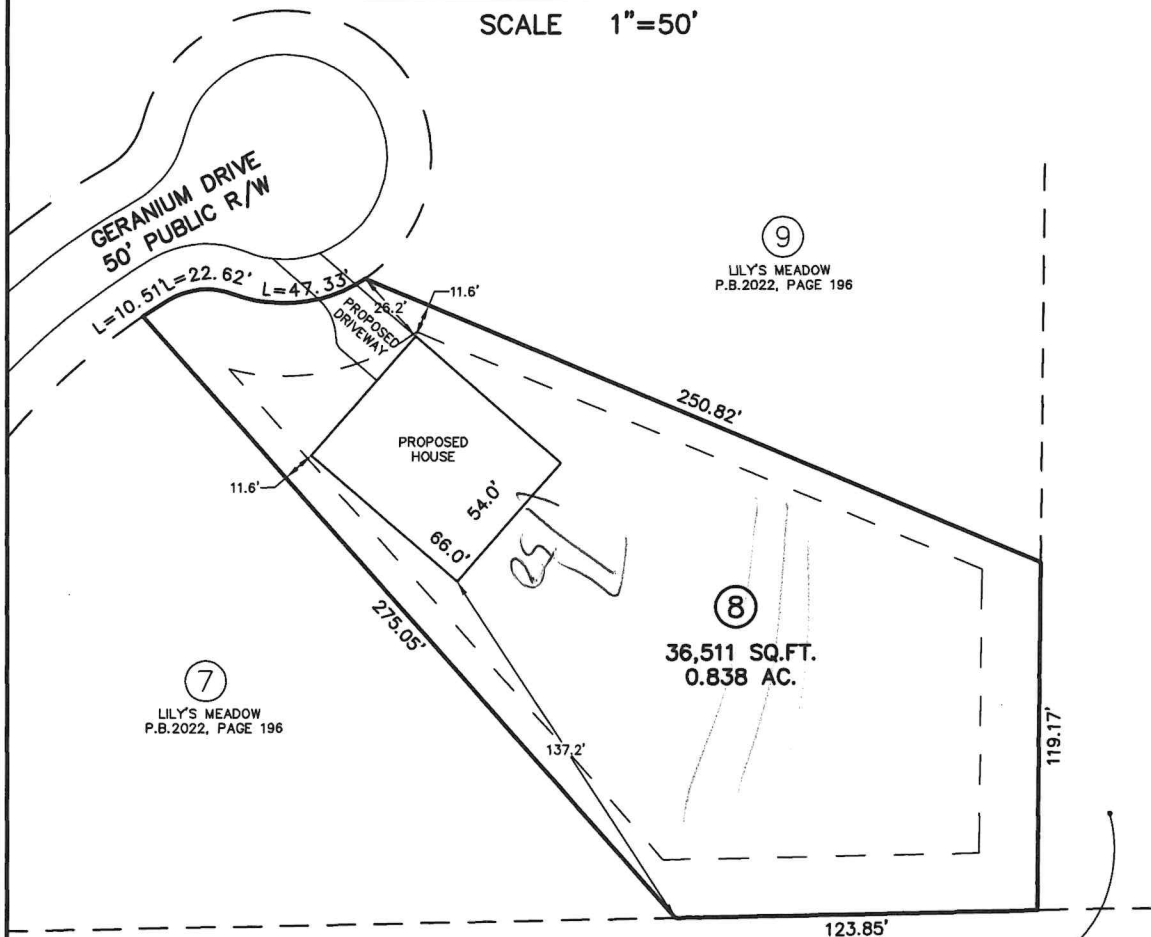

THIS SURVEYOR DOES NOT
WARRANTY THE ACCURACY
OF ARCHITECTURAL DIMENSIONS.
THEY ARE TO BE VERIFIED BY
THE CONTRACTOR.

N/F
JENNY G. JONES
D.B. 1775, PG. 397
M.B. 2010, PG. 22
PIN # 1871-17-5531

N/F
RANDALL WILLIAMS &
JOANNA W. WILLIAMS
D.B. 1021, PG. 373
M.B. 2007, PG. 309
M.B. 1995, PG. 102
PIN # 1871-17-9854

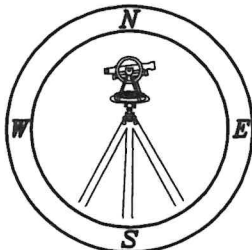

**CAWTHORNE, MOSS
& PANCIERA, P.C.**

Professional Land Surveyors
C-1525

333 S. White Street
Post Office Box 1253
Wake Forest, N.C. 27588
(919)556-3148

NOTES:
-THIS PLAN DOES NOT REFLECT AN
ACTUAL SURVEY. IT IS A PRELIMINARY
PLAN AND SHOULD BE USED FOR ITS
INTENDED PURPOSE ONLY.
-NOT FOR RECORDATION, CONVEYANCES,
OR SALES.

Sheet 1 of 1 (f+b)
PROPERTY ID #: _____
COUNTY: Franklin

lot: 8

TYPE OF WASTEWATER: ☒ Sewage ☐ Industrial Process ☐ Mixed

Grants,
Repair
2001
50'

DESCRIPTION	INITIAL SYSTEM	REPAIR SYSTEM	OTHER FACTORS (.1946):
1e Space / '945)			SITE CLASSIFICATION (.1948):
			EVALUATED BY:
			OTHER(S) PRESENT:
	3	3	



File #: 406769 lot # 8

Property Address: 25 Geranium Dr.

Applicant or Owner Name: Bulmaro Rodriguez

Environmental Health Septic/Well Permit Diagram

Building permits cannot be issued nor should construction begin without Construction Authorization issuance.

☒ Septic Improvement Permit ☒ Septic Construction Authorization (CA) ☒ CA Reissue** ☐ As Built
☒ Well Construction Authorization ☐ Additional Diagram/Specifications Attached

Diagram Date**: _____ EHS: _____

**Any previously dated CA diagram is revoked and/or invalid. Confirm this is the valid diagram for the site before beginning any construction.

Installation/grouting inspections may be scheduled the day before, or, the day of installation until 9am by contacting the Environmental Health office at 919 496 8100. A revisit fee may apply if installation is not ready for inspection at the time requested. Septic Operations Permits will be issued after installation is approved, all permits conditions are met, and any outstanding fees are paid. Well Certificate of Completion will be issued after well head approval, all permit conditions are met, and any outstanding fees are paid.

Septic Tank _____ Pump Tank _____ Drainfield _____ Type System _____ Max Trench Depth _____

Septic Contractor _____ Septic/Pump tank dates _____ Pump fee? NO YES pd date: _____

Well Contractor _____ Well Head date: _____

(If pump) Final Complete Date: _____

Bedrooms: 4

If Repair: na

Acreage: 0.84

Parcel ID: 048831

*Drawing not to scale (if large acreage, may be portion)

(If not as built, indicate changes on front or back of sheet.)

