



## IMPROVEMENT PERMIT

Vance County Health Dept  
Environmental Health  
115 Charles Rollins Road  
Henderson, NC 27536  
Phone: (252) 492-5263 Fax: (252) 492-2361

### For Office Use Only

\*CDP File Number: 418393 - 1  
County ID Number: 0216A01002  
Evaluated For: NEW

PERMIT VALID UNTIL: 10/07/2029

**\*NOTE TO INSPECTIONS DIVISION:** Building Permits cannot be issued with this Improvement Permit.

Applicant: John Patterson  
Address: 35 Stillwood Meadow Ln  
City: Louisburg  
State/Zip: NC 27549  
Phone #: cell :(919) 868-7619

Property Owner: John Patterson  
Address: 35 Stillwood Meadow Ln  
City: Louisburg  
State/Zip: NC. 27549  
Phone #: cell :(919) 868-7619

### Property Location & Site Information

Address: Vicksboro Rd Henderson, NC 27537  
Subdivision: Block/Phase: NEW Lot: 2  
**Directions**  
See attached.  
Structure: SINGLE FAMILY  
# of Bedrooms: 3  
# of People: 6  
\*Water Supply: PUBLIC

### System Specifications

#### Initial System

Usable Soil Depth: 28

Design Flow: 360

Soil Application Rate: 0.3500

Minimum Trench Depth: 12 Inches

Maximum Trench Depth: 14 Inches

\*System Classification/Description:

TYPE III G. OTHER NON-CONV. TRENCH SYSTEMS

Septic Tank: 1000 Gallons

Pump Required: ☐ Yes ☒ No ☐ May Be Required

\*Proposed System:

25% REDUCTION

Pump Tank: Gallons

Repair System Required: ☒ Yes ☐ No ☐ No, but has Available Space

### Repair System

Usable Soil Depth: 28

Soil Application Rate: 0.350

Minimum Trench Depth: 12 Inches

Maximum Trench: Depth: 14 Inches

\*System Classification/Description:

TYPE III G. OTHER NON-CONV. TRENCH SYSTEMS

Pump Required: ☐ Yes ☒ No ☐ May Be Required

\*Proposed System: 25% REDUCTION

Pump Tank: Gallons

No grading or construction activity is allowed in areas designated for system and repair without approval of Health Department.

### \*Site Modifications

The issuance of this permit by the Health Department in no way guarantees the issuance of other permits. The permit holder is responsible for checking with appropriate governing bodies in meeting their requirements.

### \*Permit Conditions

David Trulove 12/23/25 11:30 am Lines only JB  
919-868-1497 12-31-25 Final 11:30 am

Fig. 0216A01002

Permit Number 418343

**SITE SKETCH  
ON-SITE / WELL**


Vicksburg Rd. Henderson  
Address

Subdivision - Section - Lot Lot-2

1017124

**Dental**

System components represent approximate contours only. The contractor must flag the system prior to beginning the installation to ensure that proper grade is maintained.

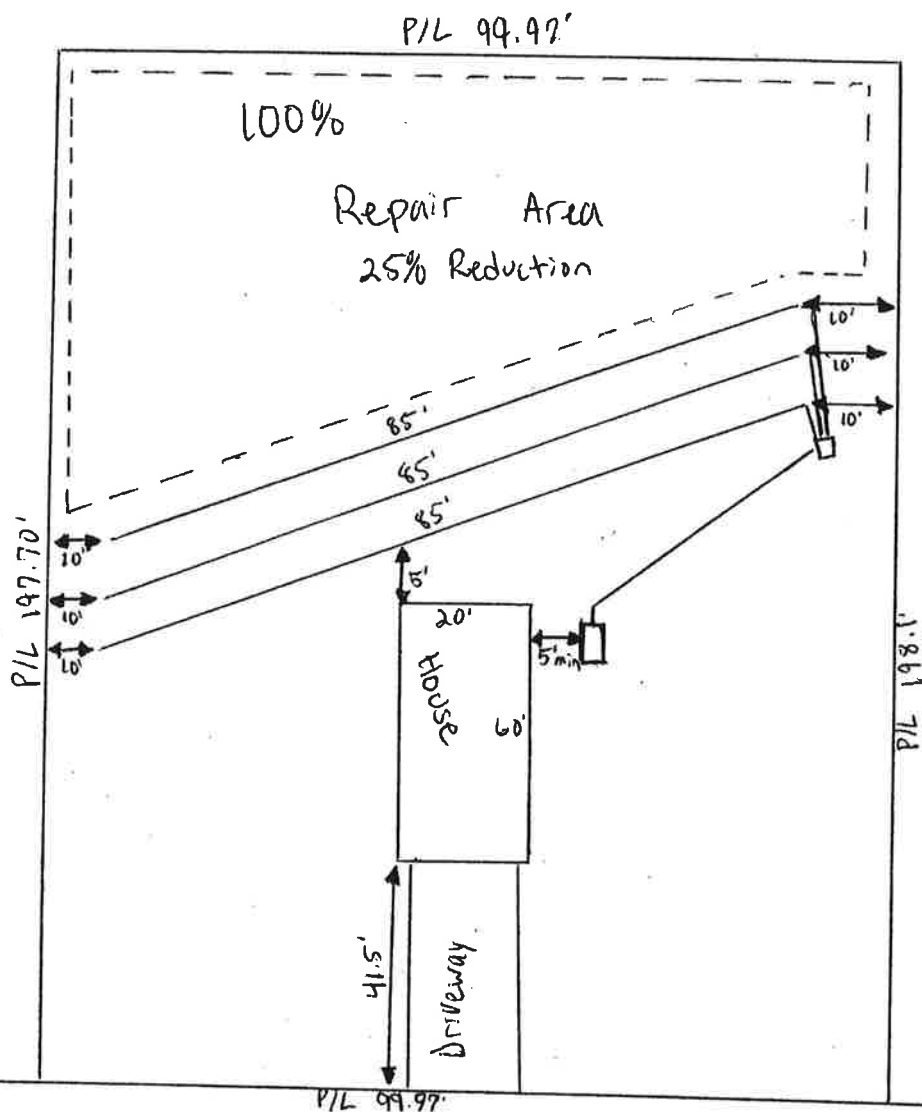

Vicksboro Rd.