


NOTE: Make sketch of installation showing location of house, septic tanks, privies, water supplies on adjacent property, etc. Write in measurements in order that installations may be located at later date.

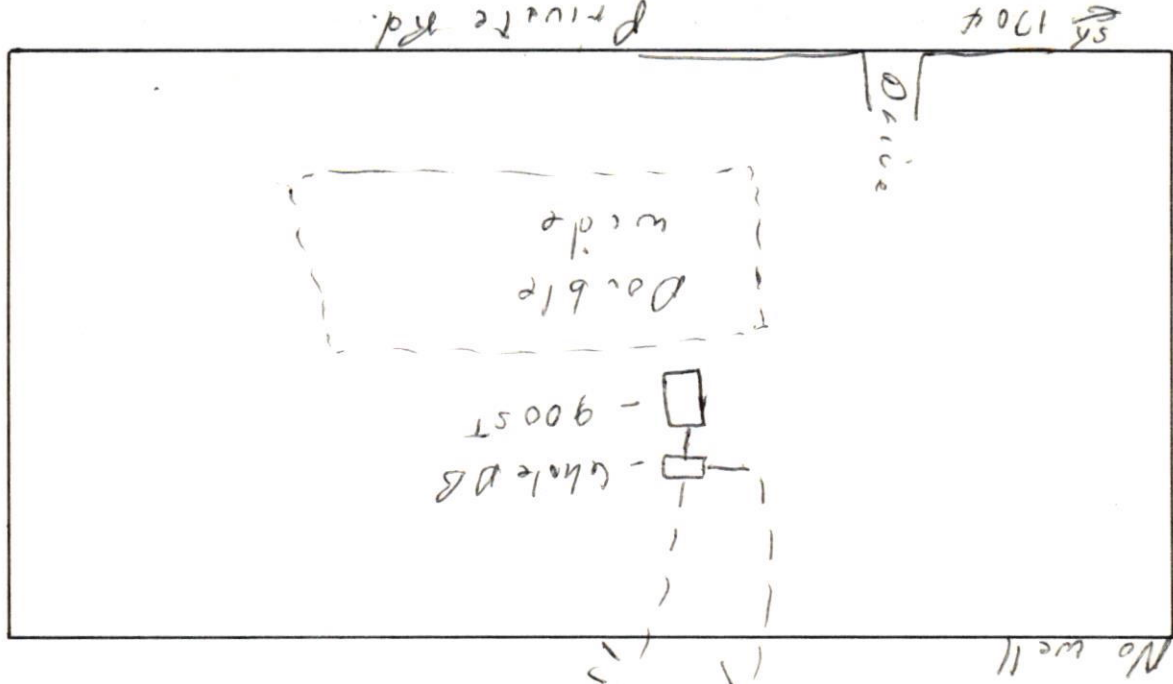

0483 GRANVILLE-VANCE HEALTH DEPARTMENT—Sewage Disposal Record

Owner or Contractor Beck & Associates Date July 1 S.R. No. 1704

Location/Address Route #1 Creedmoor N.C.

Subdivision/Mobile Home Park Name Beaver Creek Lot Size 1.8 acres

Lot No. 24

New System ☒ Repair ☐

House ☐ Mobile Home ☒ Business ☐

No. Bedrooms 3 No. People 2 No. Toilets 2

Water Supply: Private ☒ Approved ☐

Semi-Public ☐ Unapproved ☐

Public ☐ None ☐

Nitrification System:

Tank Size 900 gal.

Distribution Box yes No. Lines 2

Nitrification Field 320 - 960 Sq. Ft.

Lines: 1 2 3 4 5 6

Width 36" 36" _____

Length 165' 111' _____

Grade 4" 3" _____

Stone Depth 12" 14" _____

Layout to be followed by installer:

Improvements Permit By Bobby E. Greene Installer Joel Powell

Certificate of Completion By Bobby E. Greene Date of Inspection Aug. 17, 1987

* Construction must comply with all other applicable state and local regulations, but the permit is not a guarantee that the system will not malfunction and the Granville-Vance Health District will not be held responsible for a malfunctioning system.