


Duffy Realty & Building Co., Inc.

P. O. Box 71947
Durham, N.C. 27722-1947
N.C. Lic. # 7841

Telephone (919) 471-9707
Mobile (919) 210-0100

6.9 Acres

REF DB 464
PG 77

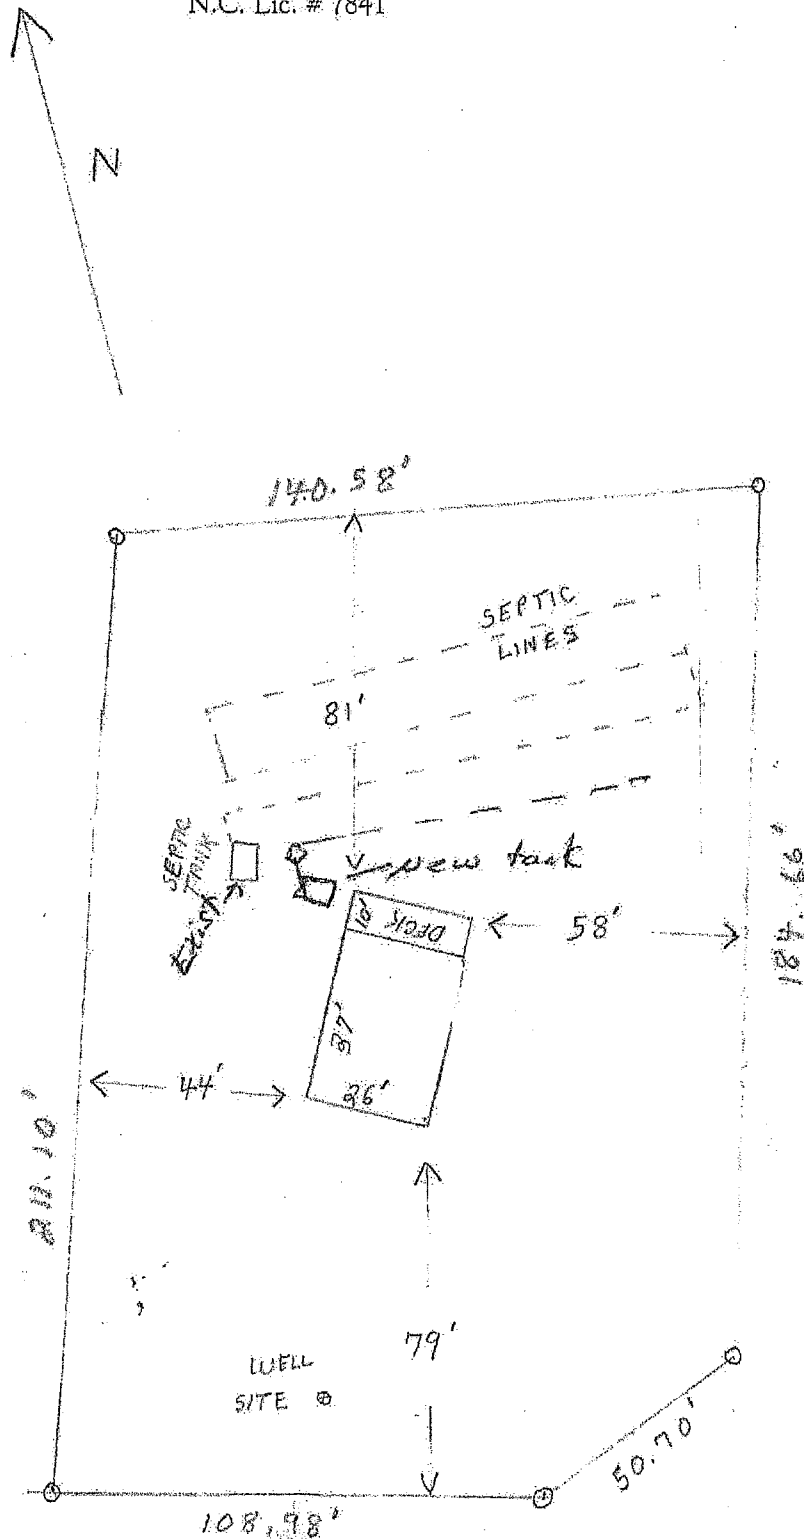

60' EXISTING PRIVATE RD.

GRANVILLE-VANCE HEALTH DEPARTMENT—Sewage Disposal Record


Owner or Contractor Gibbs, Larry Date _____ S.R. No. _____
 Location/Address Thomas Rd
 Subdivision/Mobile Home Park Name Pebble Hill Lot Size 67
 Permit No. # _____ Lot No. _____

New System ☒ Repair _____
 House ☒ Mobile Home _____ Business _____
 No. Bedrooms 3 No. People 3 No. Toilets 2
 Water Supply: Private ☒ Approved _____
 Semi-Public _____ Unapproved _____
 Public _____ None _____

Nitrification System:

Tank Size 1000 gal.
 Distribution Box 155 No. Lines 3
 Nitrification Field _____ Sq. Ft. _____
 Lines: 1 2 3 4 5 6
 Width 3' 3' _____
 Length 110 100 _____
 Grade 12 12 _____
 Stone Depth 12 12 _____

Layout to be followed by installer:

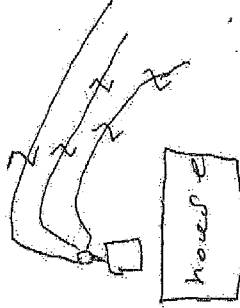


Improvements Permit By W. Vaughan Installer Doyle Builders
 Certificate of Completion By W. Vaughan Date of Inspection 5-23-95

* Construction must comply with all other applicable state and local regulations, but the permit is not a guarantee that the system will not malfunction and the Granville-Vance Health District will not be held responsible for a malfunctioning system.

PERMIT NUMBER No 9904

Addition

**GRANVILLE - VANCE DISTRICT HEALTH DEPARTMENT
IMPROVEMENT AND OPERATION PERMITS**

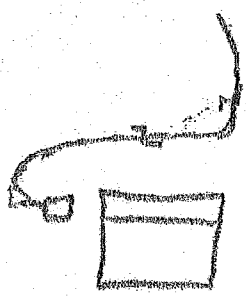COUNTY: <i>Vance</i>	TAX NO. <i>0361 01015</i>	TYPE OF ESTABLISHMENT			*THIS PERMIT SHALL BE ACCOMPANIED BY A LAYOUT SHOWN ON A PLAT, INCLUDING SYSTEM REQUIREMENTS.
SR. NO. <i>1329</i>	RESIDENCE ☒ BUSINESS ☐ OTHER ☐	NUMBER OF BEDROOMS: <i>1</i>	NUMBER OF OCCUPANTS:		
OWNER: <i>Dennis Duffy</i>					
APPLICANT: <i>same</i>		WATER SUPPLY			*THE IMPROVEMENTS PERMIT MUST BE ATTACHED TO A CONSTRUCTION AUTHORIZATION BEFORE OBTAINING BUILDING PERMIT OR OTHER CONSTRUCTION PERMITS AND BEFORE A WASTEWATER SYSTEM IS INSTALLED.
APPLICANT'S ADDRESS:		PUBLIC ☐	WELL ☒	OTHER ☐	
PROPERTY ADDRESS/LOCATION: <i>Thomas Rd</i> <i>301 Pebble Hill Ln</i>		TYPE OF WASTEWATER SYSTEM			
		DESCRIPTION	INITIAL INSTALLATION	REPAIR	
SUBDIVISION: <i>Pebble Hill</i>		DESIGN FLOW:	<i>120</i>		
LOT NUMBER:		LTAR:	<i>.4</i>		
REFERENCE SKETCH (SEE PLAT FOR DETAILS) 		ABSORPTION AREA:	<i>225' x 4'</i>		
		TRENCH WIDTH:	<i>3</i>		
		TRENCH SPACING:	<i>9'</i>		
		TOTAL TRENCH LENGTH:	<i>75'</i>		
		NUMBER OF TRENCHES:	<i>1</i>		
		GRAVEL DEPTH:	<i>*18"</i>		
		TANK SIZE:	<i>900</i>		
		CONDITIONS:	<i>Chamber</i>		
IMPROVEMENT PERMIT				DATE:	*THIS IMPROVEMENT PERMIT IS SUBJECT TO REVOCATION IF THE INTENDED USE CHANGE FROM THOSE SHOWN ON THE IMPROVEMENT PERMIT. CHANGES SHALL REQUIRE HEALTH DEPARTMENT APPROVAL.
FOR:					
ISSUED BY: <i>Walter Z. Vaughn</i>				<i>10-13-97</i>	
OPERATION PERMIT				DATE:	
SYSTEM INSTALLED BY: <i>Greg Harris</i>					
ISSUED BY: <i>W. Vaughn</i>				<i>2-20-98</i>	

E165 9-2-97