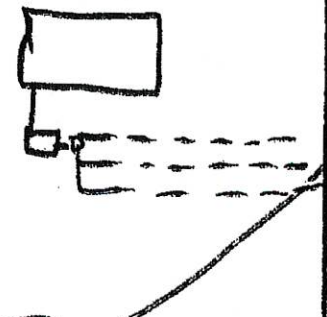


GRANVILLE - VANCE DISTRICT HEALTH DEPARTMENT **IMPROVEMENT AND OPERATION PERMITS**

COUNTY: <i>Vance</i>	TAX NO. 	TYPE OF ESTABLISHMENT			*THIS PERMIT SHALL BE ACCOMPANIED BY A LAYOUT SHOWN ON A PLAT, INCLUDING SYSTEM REQUIREMENTS.
SR NO. <i>1304</i>	RESIDENCE ☒ BUSINESS ☐ OTHER ☐	NUMBER OF BEDROOMS: <i>3</i>	NUMBER OF OCCUPANTS: <i>5</i>		
OWNER: <i>Keith Tiepner</i>					
APPLICANT:		WATER SUPPLY			
APPLICANT'S ADDRESS:		PUBLIC ☐	WELL ☒	OTHER ☐	*THE IMPROVEMENTS PERMIT MUST BE ATTACHED TO A CONSTRUCTION AUTHORIZATION BEFORE OBTAINING BUILDING PERMIT OR OTHER CONSTRUCTION PERMITS AND BEFORE A WASTEWATER SYSTEM IS INSTALLED.
PROPERTY ADDRESS/LOCATION: <i>Debner Rd</i> <i>118 Brentwood Lane</i>		TYPE OF WASTEWATER SYSTEM			
SUBDIVISION: <i>Brentwood</i>		DESCRIPTION	INITIAL INSTALLATION	REPAIR	
LOT NUMBER: <i>2</i>		DESIGN FLOW:	300 <i>300</i>		
REFERENCE SKETCH (SEE PLAT FOR DETAILS) <i>Call H.D. for layout before construction of house begins</i>		LTAR:	<i>.3</i>		
		ABSORPTION AREA:	1200 <i>810</i>		
		TRENCH WIDTH:	<i>3'</i>		
		TRENCH SPACING:	<i>9'</i>		
		TOTAL TRENCH LENGTH:	400 <i>270</i>		
		NUMBER OF TRENCHES:	4 <i>3</i>		
		GRAVEL DEPTH:	<i>12" 18</i>		
		TANK SIZE:	<i>1000</i>		*THIS IMPROVEMENT PERMIT IS SUBJECT TO REVOCATION IF THE INTENDED USE CHANGE FROM THOSE SHOWN ON THE IMPROVEMENT PERMIT. CHANGES SHALL REQUIRE HEALTH DEPARTMENT APPROVAL.
		CONDITIONS:			
IMPROVEMENT PERMIT		DATE:			
FOR:					
ISSUED BY:					
OPERATION PERMIT		DATE:			
SYSTEM INSTALLED BY: <i>Wm H. G. S. +</i>					
ISSUED BY: <i>Walter P. Vaughn</i>				<i>8-11-97</i>	