

FRANKLIN COUNTY HEALTH DEPARTMENT

25.2 478 3331


PERMIT NUMBER: <u>9218C</u>	CONST IMPROVE PERMIT DATE: <u>07.97</u>	21428	SIZE:
APPLICANT: WALLACE WILLIAM & BARBARA 303 LAKESIDE DR GARNER NC 27529		OWNER: LECH MARIE	
TELEPHONE: <u>772-9200</u>			
COMMENT: SFD	DESCRIPTION: 5 YEAR ☒	LIFETIME: ☐	
LOCATION / DIRECTIONS: LAKE ROYALE #1155			
FEE: 100.00 4502		SIGNATURE OR OWNER OR AUTHORIZED AGENT:	

THE ABOVE SIGNATURE INDICATES THAT I HAVE READ, UNDERSTAND, AND AGREE WITH ALL PROVISIONS AND INFORMATION AS OUTLINED ON THE BACK SIDE OF THIS FORM

TOPO <u>PS</u>	TEXTURE <u>PS</u>	STRUCTURE <u>PS</u>	DEPTH <u>22</u>
R. HOR <u>PS</u>	SOIL. WET <u>PS</u>	AVAIL. SP <u>PS</u>	OTHER <u>—</u>
MINRL <u>PS</u>	OVERALL <u>PS</u>	LTAR <u>.4</u>	
#BEDRMS <u>3</u>	GPD <u>360</u>	DISPOSAL <u>—</u>	TYPE. SYS <u>Pump</u>
SZ. TANK <u>900</u>	SZ. CHAMB <u>1800</u>	NITRIFI <u>300'x3'</u>	TYPE. WAT <u>Private</u>
SITE. LOC <u>—</u>	MAX TRENCH DEP <u>30"</u>	TYP. FAC <u>SFD</u>	

REMARKS:

- 1) Run lines on contour
- 2) Keep min 5' off prop. lines
- 3) Keep lines out of drive area
- 4) Pump to conventional

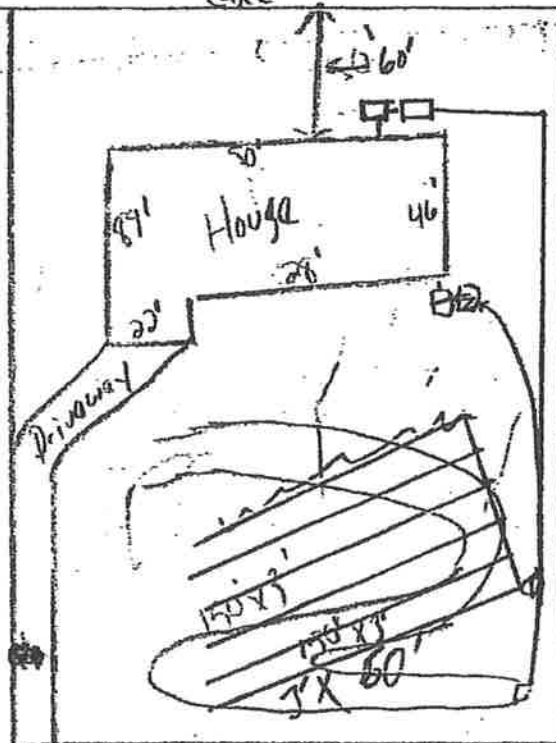

changed 6-9-97
requested by
Chuck Gable

HB-1000
SB-646
7-28-91
HB-1000
BPT

Branthley Coney

IMPROVEMENT PERMIT DATE:

3/20/97

ENV HEALTH SPEC:

See Note

CONSTRUCTION AUTHORIZATION DATE:

3/20/97

ENV HEALTH SPEC:

See Note

OPERATION PERMIT DATE:

10-14-98

ENV HEALTH SPEC:

See Note