

GRANVILLE-VANCE HEALTH DEPARTMENT—Sewage Disposal Record


Owner or Contractor Watson F.C. Jr. Date S.R. No.
Location/Address US #158 Box 308 Woodtrail Way
Subdivision/Mobile Home Park Name Hunter's Ridge Lot Size 1 ac.
0426A04022 Lot No. 22

New System ☒ Repair
House ☒ Mobile Home Business
No. Bedrooms 3 No. People No. Toilets 2
Water Supply: Private Approved
Semi-Public Unapproved
Public ☒ None

Nitrification System:

Tank Size 1000 gal.
Distribution Box YES No. Lines 3
Nitrification Field 960 Sq. Ft.
Lines: 1 2 3 4 5 6
Width 3 3 3
Length 140 140 60
Grade ✓ ✓ ✓
Stone Depth 12 12 12

Layout to be followed by installer:

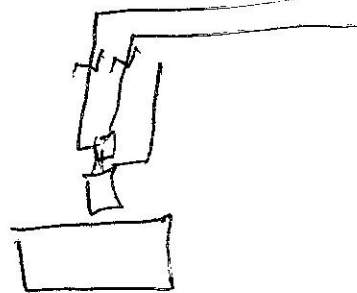

Improvements Permit By W. Vaughan Installer John Ayres
Certificate of Completion By W. Vaughan Date of Inspection 11-6-86

* Construction must comply with all other applicable state and local regulations, but the permit is not a guarantee that the system will not malfunction and the Granville-Vance Health District will not be held responsible for a malfunctioning system.