

GRANVILLE-VANCE HEALTH DEPARTMENT - Sewage Disposal Record

Owner or Contractor Bowser, David Date 6-8-92 S.R. No. _____

Location/Address 501 Pt. Rd.

Subdivision/Mobile Home Park Name Timberlake Lot Size 1.15

Permit No. # _____ Lot No. 39

New System ☒ Repair _____

House ☒ Mobile Home _____ Business _____

No. Bedrooms 3 No. People 4 No. Toilets 2 1/2

Water Supply: Private ☒ Approved _____

Semi-Public _____ Unapproved _____

Public _____ None _____

Nitrification System:

Tank Size 1000 gal.

Distribution Box YES No. Lines 3

Nitrification Field 1200 Sq. Ft.

Lines: 1 2 3 4 5 6


Width 3 3 3 _____

Length 133 133 133 _____

Grade ✓ ✓ ✓ _____

Stone Depth 12 12 12 _____

Layout to be followed by installer:

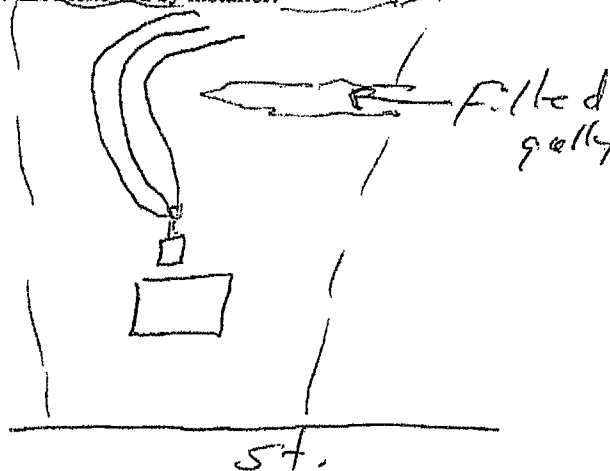

Improvements Permit By W. Dwyer Installer John Ayres

Certificate of Completion By W. Dwyer Date of Inspection 1-29-93

* Construction must comply with all other applicable state and local regulations, but the permit is not a guarantee that the system will not malfunction and the Granville-Vance Health District will not be held responsible for a malfunctioning system.