

Granville - Vance District Health Department

00050

Environmental Health

Well Construction Permit

Owner/Applicant: Yolanda Richardson Date: 12-31-08
 Address or Location of Property: 146 Oak Forest Dr 0465A01615


Subdivision & Lot #: 1 Oak Forest #15 Septic Permit #: 106276
 Zoning Permit #: _____ Environmental Health Specialist: MDS

This well permit is to locate and site the area that a private groundwater well may be established on the property listed above by the Environmental Health Specialists of Granville County. If one does not locate the well in the approved area and complete the well as specified by the 15A NCAC .02C rules, then permits may be revoked. At completion of drilling of the well, grout must be witnessed by EHS and a well log turned into Environmental Health.

Minimum Setbacks: (these are the main setbacks, but not all required setbacks)

Setback from property lines – 10 ft Setback from septic tank and drain field, including repair area – 100 ft
 Setback from structural foundations – 25 ft Setback from ponds, lakes or other bodies of water – 50 ft

Site Sketch:

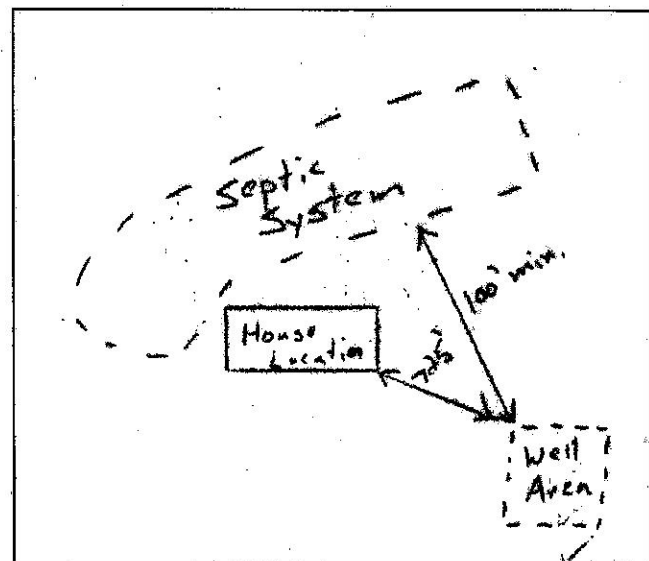


Conditions:

Authorized Agent: Mac Shingleton, R.S.
 Date: 12-31-08

Well Grout: (Circle or write in)

Witnessed: Yes or No EHS Agent: SMD
 Date: 02/12/09 Annular Space Open: Yes or No
 Over reamed: Yes or No
 Method: _____ Pump ✓ Poured _____ Pressure
 Depth Grouted: 20 ft
 Well Log received: Yes or No (EHS to Attach to Permit)

As Built Drawing:

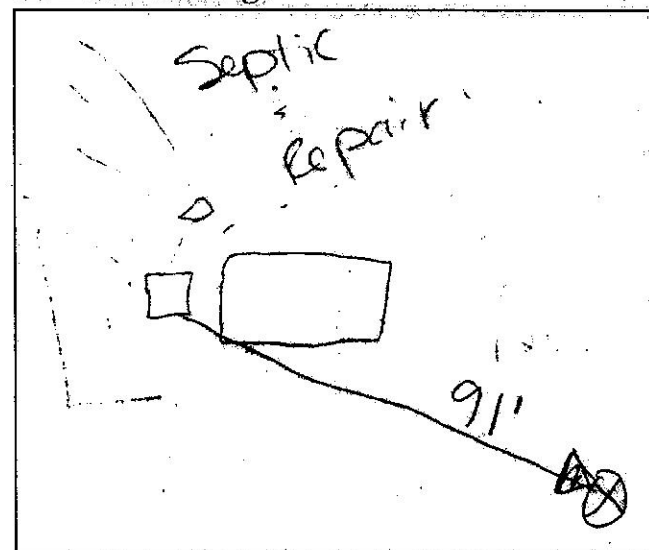

Well Final: (Place a check mark when finalized)

Seal Present and Intact: ✓ Air Vent: ✓
 Hose Spigot: ✓ Electrical Box: ✓
 Pump Installer Tag: ✓ Well Installer Tag: ✓
 All holes sealed: ✓ 12" above grade: ✓
 Comments: 3-4-09 No vent pipe /
all holes not sealed /
needs seals around
conduit / no pump installer tag

Well Completion Permit: Shak Durham EHS
 Date Completed: 03/12/09

Water Samples Taken: Date: 03/12/09
 EHS: SMD Results: _____
 Retest: _____ Results: _____