

HARVEY BRUCE

002 0753

GRANVILLE-VANCE DISTRICT HEALTH DEPARTMENT
IMPROVEMENT PERMIT AND CERTIFICATE OF COMPLETION


OWNER/AGENT Harvey + Faye Bruce
LOCATION 22 Grete Lane STATE ROAD NO. _____
SUBDIVISION NAME 060802039 LOT NO. 4.95

SYSTEM DESIGNED FOR:

NEW SYSTEM ☒ REPAIR _____ RESIDENCE ☒ BUSINESS _____ OTHER _____
NO. BEDROOMS 2 NO. OCCUPANTS _____ WATER SUPPLY: INDIVIDUAL ☒ PUBLIC _____
LOT SIZE 1 ACRES F _____ L _____ B _____ R _____
SEPTIC TANK 1000 GALLONS PUMP TANK _____ GALLONS DISTRIBUTION Line
NITRIFICATION FIELD 1200 SQUARE FEET NUMBER OF LINES 3.7
LENGTH OF LINES 2.7 + 100 WIDTH OF LINES 36" STONE DEPTH 12"

CONDITIONS TRENCH DEPTH 36"-48"
* PREFER 48" TRENCH DEPTH

LAYOUT

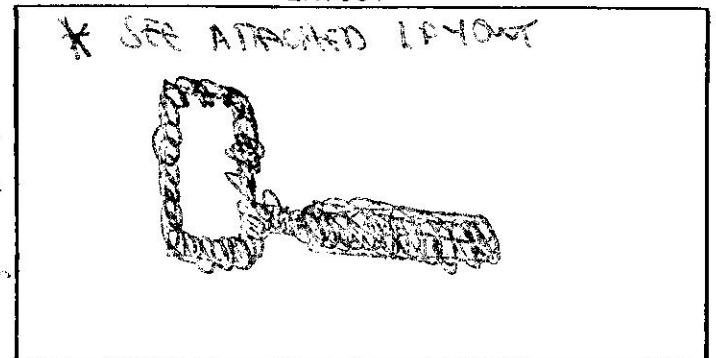


NOTICE: The above are minimum specifications for a sewage disposal system on the above captioned property. This permit is subject to compliance with local zoning and building regulations and all the provisions of the Laws and Rules for Sanitary Sewage Collection, Treatment, and Disposal of the North Carolina Administrative Code. This permit may not be altered without written permission from a representative of the Granville-Vance District Health Department. System must be installed within _____ years of date of issuance. This permit is subject to revocation if site plans or the intended use changes.

I understand the requirements of this permit and the information I have provided is accurate to the best of my knowledge.

OWNER/AGENT _____ DATE _____
IMPROVEMENT PERMIT BY: Sharon T. Davidson DATE 8-15-05 Updated
CERTIFICATE OF COMPLETION BY: Wesley Shingleton, P.E. DATE 10-27-05
SYSTEM INSTALLED BY: Norman Clifford

NOTICE: This approval indicates that the installation complies with all applicable state and local regulations, but shall in no way be taken as a guarantee that the system will function satisfactorily for any given period of time and the Granville-Vance District Health Department will not be held responsible for a malfunctioning system.

Satterwhite Point Road

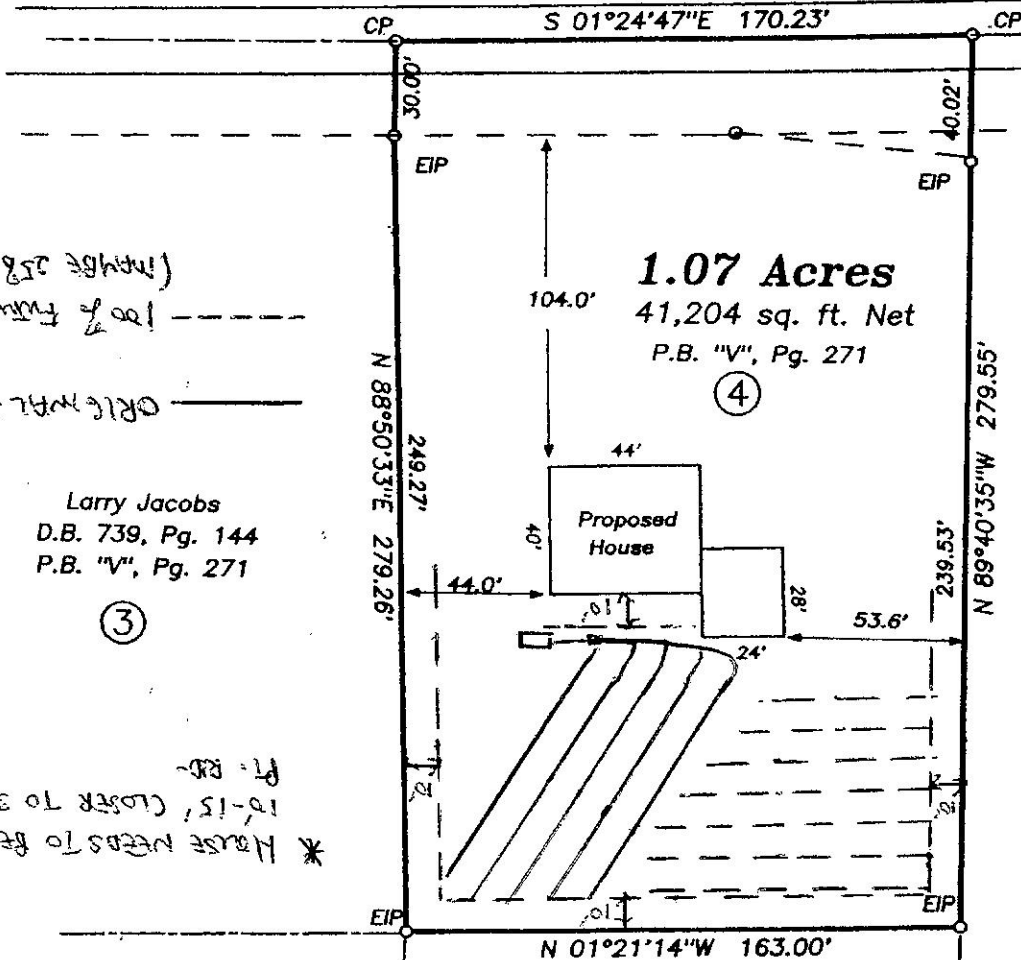

Larry Jacobs
D.B. 739, Pg. 144
P.B. "V", Pg. 271

Anthony Barker
D.B. 732, Pg. 456
P.B. "V", Pg. 271


P.B. "V", Pg. 271

This plat is subject to all easements,
agreements, and rights of way of
record prior to the date of this plat.

All Areas Calculated By Coordinate Method

LEGEND

EIP Existing Iron Pipe	NIP New Iron
EIS Existing Iron Spike	NIS New Iron
EPK Existing PK Nail	NPK New PK N
ERB Existing Rebar	NRB New Reba
ERS Existing Railroad Spike	CP Computed
ECM Existing Conc. Monument	PP Power Poi
RCP Reinforced Concrete Pipe	⊙ Property L
CMP Corrugated Metal Pipe	⊙ Center Lin
EDL Electric Distribution Line	R/W Right of V
ESL Electric Service Line	MBL Min. Bldg.
CM Concrete Monument	

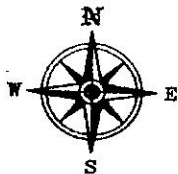


Alan's Surveying Company, P.A.

630 Corbitt Road

Henderson, N. C. 27536

(919) 492-9234

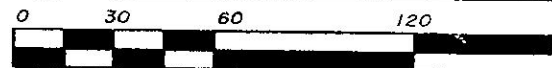

Date: 03/22/05

Scale 1" =

File # V05020

I, Alan R. Rowland, certify that this plat was drawn
under my supervision from an actual survey made
under my supervision, that the ratio of precision
as calculated before adjustment is 1: 10,000 +;
that this survey and plat was prepared in
accordance with the N. C. Standards of Practice
for Land Surveying. Witness my original signature,
seal, and registration number this
day of , 1998.

Alan R. Rowland

L-2897

Site Plan For
Harvey R. Bruce
& Faye M. Br

Lot 4, Timberla
Middlebur
Vance Cou