


TYPE II A - CONVENTIONAL - ORIGINAL - REPAIR

PERMIT NUMBER 3705

GRANVILLE-VANCE DISTRICT HEALTH DEPARTMENT IMPROVEMENT AND OPERATION PERMITS

COUNTY: VANCE	TAX NO. .	TYPE OF ESTABLISHMENT			*THIS PERMIT SHALL BE ACCOMPANIED BY A LAYOUT SHOWN ON A PLAT, INCLUDING SYSTEM REQUIREMENTS. *THE IMPROVEMENTS PERMIT MUST BE ATTACHED TO A CONSTRUCTION AUTHORIZATION BEFORE OBTAINING BUILDING PERMIT OR OTHER CONSTRUCTION PERMITS AND BEFORE A WASTEWATER SYSTEM IS INSTALLED. *THIS IMPROVEMENT PERMIT IS SUBJECT TO REVOCATION IF THE INTENDED USES CHANGE FROM THOSE SHOWN ON THE IMPROVEMENT PERMIT. CHANGES SHALL REQUIRE HEALTH DEPARTMENT APPROVAL.
	SR. NO.	RESIDENCE <u>X</u> BUSINESS <u>—</u> OTHER <u>—</u>	NUMBER OF BEDROOMS: 4	NUMBER OF OCCUPANTS: ≤ 8	
OWNER: <u>Michael J Smith</u> <u>Toby Investments</u>					
APPLICANT: <u>W. A. EURLIN</u>		WATER SUPPLY			
APPLICANT'S ADDRESS:		PUBLIC <u>—</u>	WELL <u>X</u>	OTHER <u>—</u>	
PROPERTY ADDRESS/LOCATION: SOMERSET LN		TYPE OF WASTEWATER SYSTEM			
SUBDIVISION: <u>SOMERSET</u>		DESCRIPTION	INITIAL INSTALLATION	REPAIR	
LOT NUMBER: <u>51</u>		DESIGN FLOW:	<u>480 gpd day</u>		
		LIAR:	<u>0.3</u>		
REFERENCE SKETCH (SEE PLAT FOR DETAILS) * SEE ATTACHED LAYOUT		ABSORPTION AREA:	<u>1600 FT²</u>		
		TRENCH WIDTH:	<u>3'</u>		
		TRENCH SPACING:	<u>AT LEAST 9' ON CENTERS</u>		
		TOTAL TRENCH LENGTH:	<u>534'</u>		
		NUMBER OF TRENCHES:	<u>4-5</u>		
		GRAVEL DEPTH:	<u>12"</u>		
		TANK SIZE:	<u>1000 GAL</u>		
		CONDITIONS:	<u>24"-36" TRENCH DEPTH</u>		
IMPROVEMENT PERMIT					Updated 7-8-07 DATE: <u>WDS</u> <u>6-24-07</u>
FOR: <u>Toby Investments</u> ISSUED BY: <u>[Signature]</u>					
OPERATION PERMIT					DATE:
SYSTEM INSTALLED BY:					PERMIT VALID FOR 5 YEARS FROM DATE OF ISSUE
ISSUED BY:					

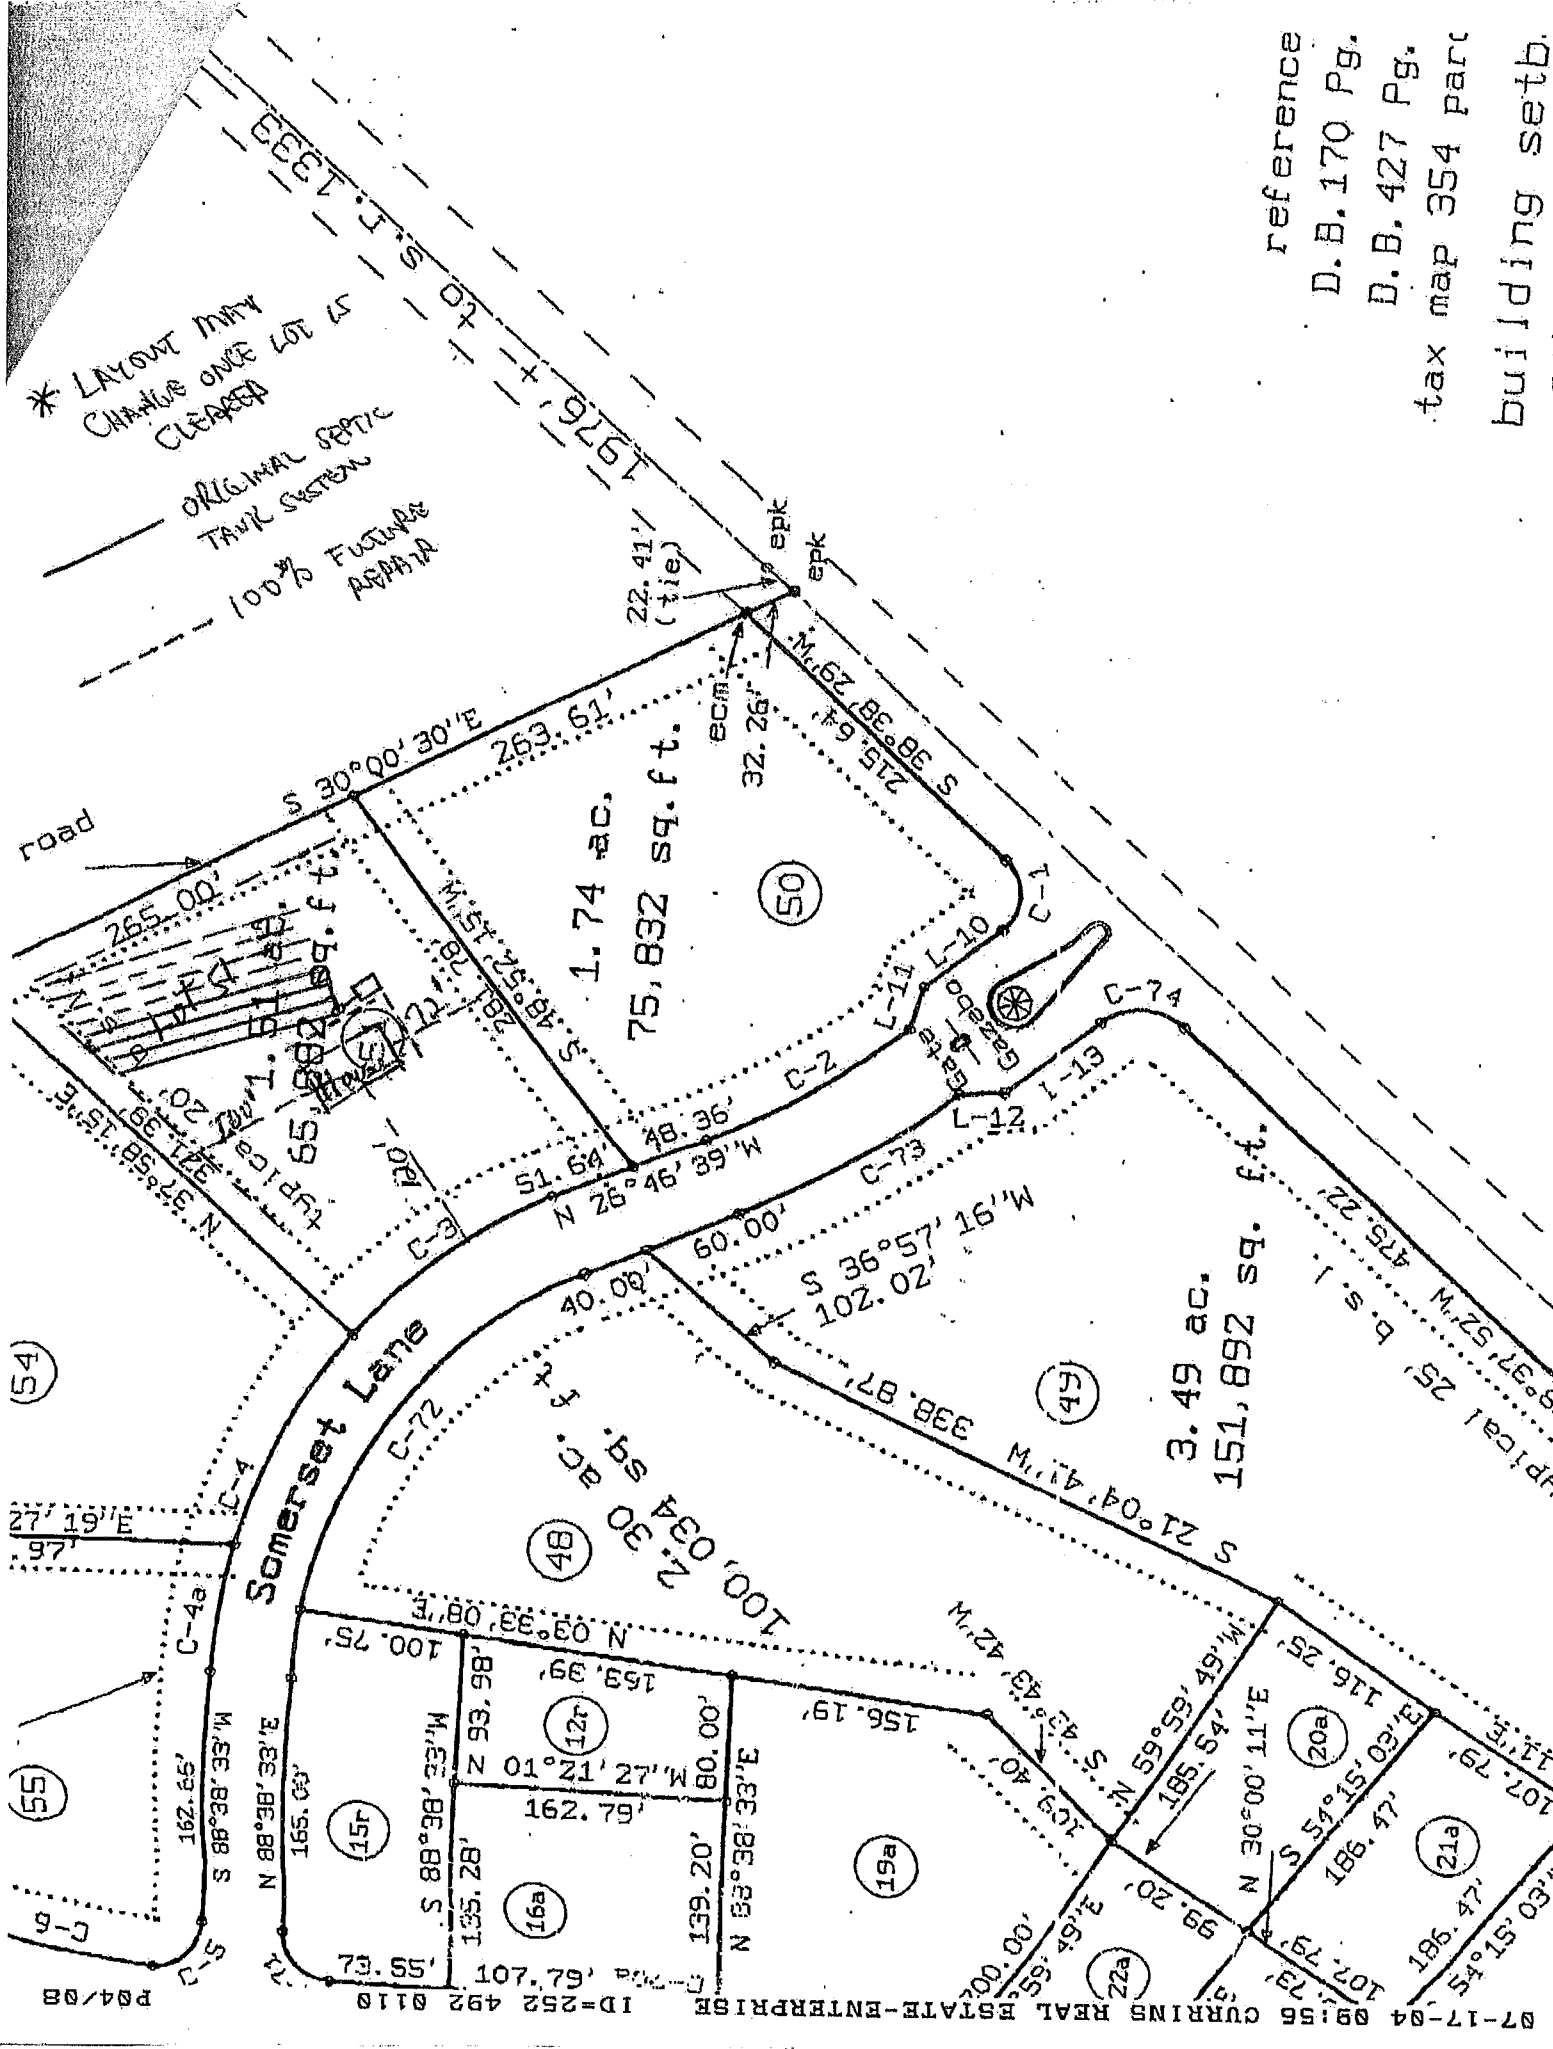

reference
D.B. 170 Pg.
D.B. 427 Pg.
tax map 354 par
building setb.

* LAYOUT MUST
CHANGE ONCE LOT IS
CLEARED

ORIGINAL SEPTIC
TANK SYSTEM

100% FUTURE
ASPH/PA

road

Somerset Lane