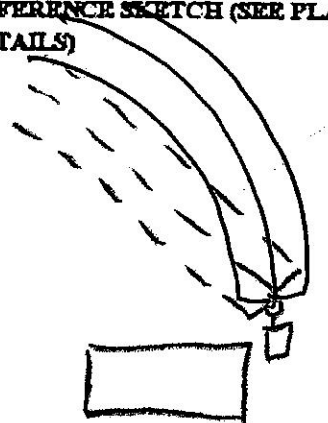


GRANVILLE - VANCE DISTRICT HEALTH DEPARTMENT
 IMPROVEMENT AND OPERATION PERMITS

COUNTY: Vance	TAX NO. SR NO. 1518	TYPE OF ESTABLISHMENT			*THIS PERMIT SHALL BE ACCOMPANIED BY A LAYOUT SHOWN ON A PLAT, INCLUDING SYSTEM REQUIREMENTS.
OWNER: Mark Hargrove	RESIDENCE ☒ BUSINESS ☐ OTHER ☐	NUMBER OF BEDROOMS: 3	NUMBER OF OCCUPANTS: 3		
APPLICANT: John Foster Homes		WATER SUPPLY			
APPLICANT'S ADDRESS: 0528 01071		PUBLIC ☐	WELL ☒	OTHER ☐	
PROPERTY ADDRESS/LOCATION: Stewart Fm. Rd. 575		TYPE OF WASTEWATER SYSTEM			*THE IMPROVEMENTS PERMIT MUST BE ATTACHED TO A CONSTRUCTION AUTHORIZATION BEFORE OBTAINING BUILDING PERMIT OR OTHER CONSTRUCTION PERMITS AND BEFORE A WASTEWATER SYSTEM IS INSTALLED.
		DESCRIPTION	INITIAL INSTALLATION	REPAIR	
SUBDIVISION: Eastview		DESIGN FLOW:	360		
LOT NUMBER: 19		LTAR:	.4		
REFERENCE SKETCH (SEE PLAT FOR DETAILS)  1518		ABSORPTION AREA:	900sqft		
		TRENCH WIDTH:	3		
		TRENCH SPACING:	9'		
		TOTAL TRENCH LENGTH:	300'		
		NUMBER OF TRENCHES:	3		
		GRAVEL DEPTH:	12"		
		TANK SIZE:	1000		
		CONDITIONS:			
IMPROVEMENT PERMIT				DATE:	*THIS IMPROVEMENT PERMIT IS SUBJECT TO REVOCATION IF THE INTENDED USE CHANGE FROM THOSE SHOWN ON THE IMPROVEMENT PERMIT. CHANGES SHALL REQUIRE HEALTH DEPARTMENT APPROVAL.
FOR:					
ISSUED BY: Wallace T. Vaughn RS				5-26-99	
OPERATION PERMIT				DATE:	
SYSTEM INSTALLED BY: JOHN AYSOUE					
ISSUED BY: Paul T. L...				7-12-99	