

SEWAGE DISPOSAL SYSTEM INSTALLATION REVIEW

SEPTIC AND PUMP TANK INSPECTION

SEPTIC TANK

Manufacturer MILS
 Date of Manufacture 8/14/17
 Stamp ST0858
 Capacity 1000
 Tee _____
 Baffle _____
 Sealant _____
 AIR GAP _____, FILTER _____, RISER _____

INITIAL

WJB

DATE

10-23-17

PUMP TANK

Manufacture _____
 Date of Manufacture _____
 Stamp _____
 Capacity _____
 Sealant _____
 Manhole _____
 RISER _____, SEALANT _____

MECHANICAL INSPECTION

PUMP

Manufacturer and Model # _____
 Control Panel _____
 Alarm _____
 Electrical Connection _____
 SEALANT AROUND CONDUIT _____

NITRIFICATION/DISTRIBUTION AND DRAINFIELD INSPECTION

DISTRIBUTION BOX

Level ✓
 Equal Distribution ✓
 Other _____

awc
↓
✓

10-26-17
↓

DISTRIBUTION MANIFOLD

Pipe Size _____
 Gate Valves _____
 Other _____

OTHER DISTRIBUTION

Type _____

NITRIFICATION LINES

Trench Width 3'
 Trench Length 80'
 Trench Grade ✓
 Stone-Depth —

LINE 1

3'
80'
✓
—

LINE 2

3'
80'
✓
—

LINE 3

3'
80'
✓
—

LINE 4

3'
80'
✓
—

LINE 5

3'
80'
✓
—

LINE 6

EZ-Flow

WELL INSPECTION

LOCATION OF WELL _____

COMMENTS:

**Granville - Vance District Health Department
Environmental Health**

Final Sketch

Pin _____

Improvement Permit _____

Construction Authorization _____

Applicant's Name
Sally Jones

Permit No. 411

Subdivision - Section - Lot
1200000 49

Physical Address: 3812 Greenwood Dr.

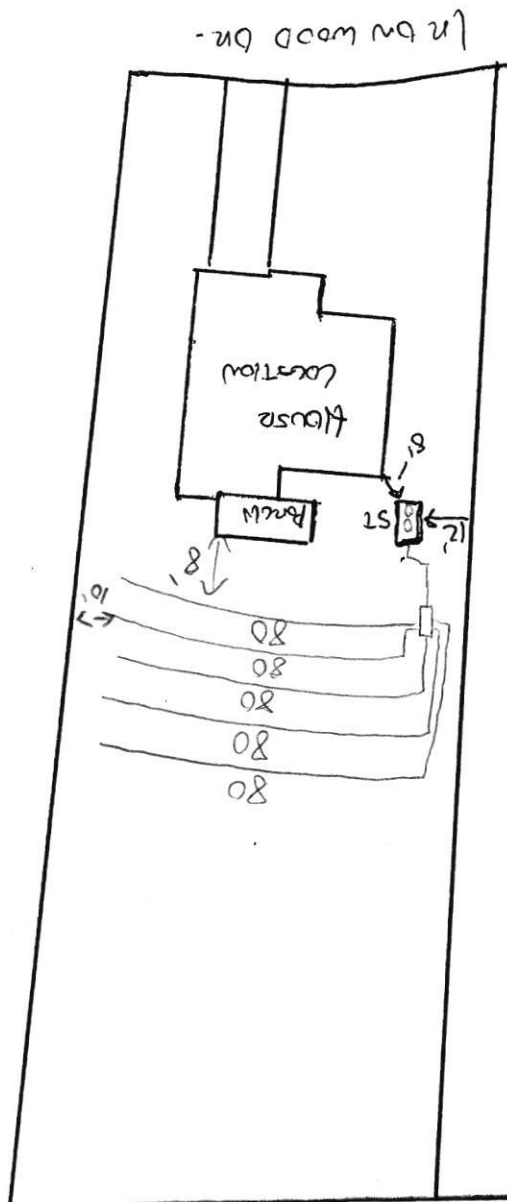
System Installer

Glenn Todd

Date

(6-23-12) (Tank) WTS

System design and details as installed.



- 10' from property line to D-Box

1200000 Dr.

Tank (6-23-12) WTS

Handwritten signature

Granville - Vance District Health Department

Environmental Health

Well Construction Permit

2074

Owner/Applicant: Savvy HomesDate: 5-8-17Address or Location of Property: 3812 Ironwood DrSubdivision & Lot #: Ironwood/49Septic Permit #: 9101Zoning Permit #: 19855Environmental Health Specialist: AWC

This well permit is to locate and site the area that a private groundwater well may be established on the property listed above by the Environmental Health Specialists of Granville County. If one does not locate the well in the approved area and complete the well as specified by the 15A NCAC .02C rules, then permits may be revoked. At completion of drilling of the well, grout must be witnessed by EHS and a well log turned into Environmental Health.

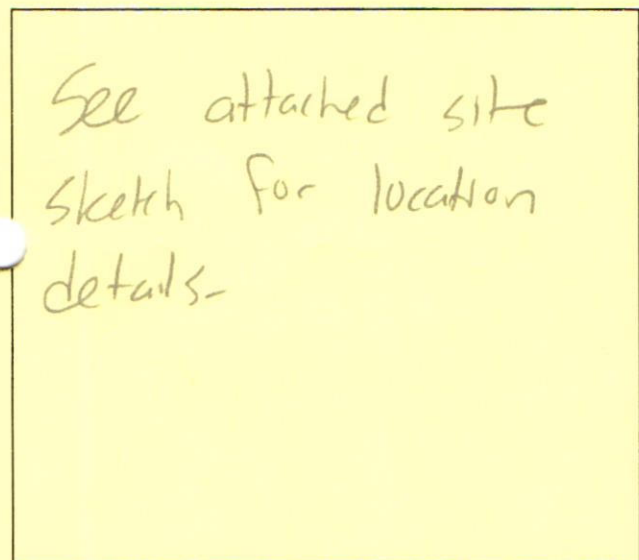
Minimum Setbacks: (these are the main setbacks, but not all required setbacks)

Setback from property lines – 10 ft

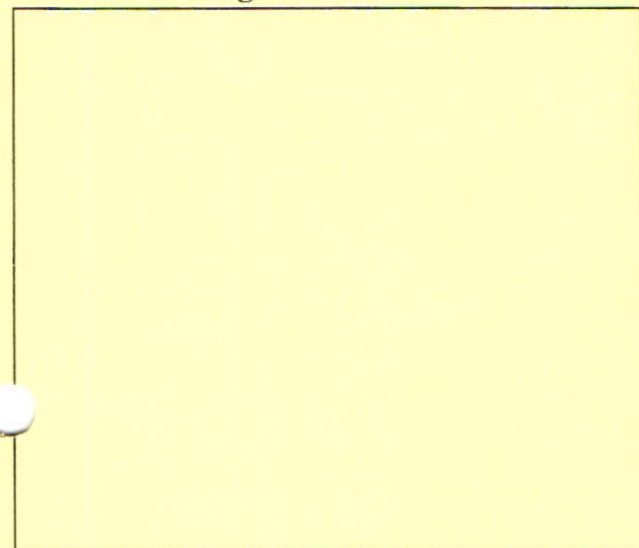
Setback from septic tank and drain field, including repair area – 100 ft

Setback from structural foundations – 25 ft

Setback from ponds, lakes or other bodies of water – 50 ft

Site Sketch:**Conditions:**Authorized Agent: Adam CurrenDate: 5-8-17**# 1 Well Grout: (Circle or write in)**Witnessed: Yes or No EHS Agent: WillieDate: 8-31-17 Annular Space Open: Yes or NoOver reamed: Yes or No Depth Grouted: 204Method: Pump ☒ Poured ☐ Pressure

Well Log received: Yes or No (EHS to Attach to Permit)

Driller Name: SOUTHERN Cert. # Depth: 315 Casing Depth: 120 GPM: 20**As Built Drawing:****# 2 Well Final: (Place a check mark when finalized)**Seal Present and Intact: ☒ Air Vent: ☒Hose Spigot: ☒ Electrical Box: ☒Pump Installer Tag: ☒ Well Installer Tag: ☒All holes sealed: ☒ 12" above grade: ☒**Comments:**# 3 Well Completion Permit: Adam Curren EHSDate Completed: 11-29-17**# 4 Water Samples Taken: Date:**EHS: Results: Retest: Results:

GRANVILLE-VANCE DISTRICT HEALTH DEPARTMENT IMPROVEMENT AND OPERATION PERMITS

COUNTY: <u>Granville</u>	TAX NO.	TYPE OF ESTABLISHMENTS			*THIS PERMIT SHALL BE ACCOMPANIED BY A LAYOUT SHOWN ON A PLAT, INCLUDING SYSTEM REQUIREMENTS. *THIS IMPROVEMENT PERMIT IS SUBJECT TO REVOCATION IF THE INTENDED USES CHANGE FROM THOSE SHOWN ON THE IMPROVEMENT PERMIT. CHANGES SHALL REQUIRE HEALTH DEPARTMENT APPROVAL.
	SR. NO.	RESIDENCE ☒ BUSINESS ☐ OTHER ☐	NUMBER OF BEDROOMS: <u>4</u>	NUMBER OF OCCUPANTS: <u>8 MAX</u>	
APPLICANT: <u>Savvy Homes</u>	WATER SUPPLY	WELL ☒ PUBLIC ☐	OTHER ☐		
APPLICANT'S NAME & ADDRESS: <u>8025 Creedmoor Rd Raleigh, NC 27613</u>	TYPE OF WASTEWATER SYSTEM	INITIAL INSTALLATION <u>Type III g</u>	REPAIR		
PROPERTY ADDRESS/LOCATION: <u>3812 Ironwood Dr</u>	DESIGN FLOW:	<u>480 gpd</u>			
SUBDIVISION: <u>Ironwood</u>	LTAR:	<u>.3 gpd/ft²</u>			
LOT NUMBER: <u>49</u>	ABSORPTION AREA:	<u>1,200 ft²</u>			
REFERENCE SKETCH (SEE PLAT FOR DETAILS)	TRENCH WIDTH:	<u>36"</u>			
	TRENCH DEPTH:	<u>20-22"</u>			
	TRENCH SPACING:	<u>9' o.c.</u>			
	TOTAL TRENCH LENGTH:	<u>400'</u>			
	NUMBER OF TRENCHES:	<u>4 or 5</u>			
	GRAVEL DEPTH:	<u>N/A</u>			
	TANK SIZE:	<u>1000 gal</u>			
	PUMP TANK SIZE:	<u>N/A</u>			
	DISTRIBUTION DEVICE:	<u>D-BOX</u>			PERMIT VALID FOR: <u>5</u> YEARS YES ☒ NO ☐
					NO EXPIRATION YES ☐ NO ☒

***** IMPROVEMENT PERMIT DATE: 5-8-17 *****

FOR: Savvy Homes

ISSUED BY: Adam Curran

***** CONSTRUCTION AUTHORIZATION FOR IMPROVEMENT PERMIT# 9101 *****

Unless otherwise indicated, the same conditions above apply regarding system type, layout, location and installation requirements.

(The wastewater system cannot be installed until authorization is signed)

Comments: Contractor to establish & follow contour

Date: 5-8-17 Environmental Health Specialist: Adam Curran

Construction Authorization Addendum ☐ Yes ☒ No

***** OPERATION PERMIT DATE: 10-23-17 (cont) WTD *****

SYSTEM INSTALLED BY: Glenn Todd 10-26-17 Lines

ISSUED BY: Adam Curran

PERFORMANCE, MONITORING, MAINTENANCE AND OPERATION
AS REQUIRED BY RULE .1961