

919 562 1820

**Franklin County Health Department
Division of Environmental Health
107 Industrial Drive-Suite C
Louisburg, North Carolina 27549**

PAGE 1 OF 2

Phone: 919-496-8100

SEPTIC PERMIT

Fax: 919-496-8136

Permit Number: 4094 Type: I PIN: 1833-70-3814 Date: 11/29/2007

Applicant: SHARPE HOME CONCEPTS INC Owner: JAMES CHARLES WILSON JR &
1420 KEITH RD 10 LANCE LANE
WAKE FOREST, NC 27587 YOUNGSVILLE, NC 27596

Telephone: (919) 569-9530

Telephone:

Subdivision: LANCE RIDGE

Lot Number: 9

Size: 1.000

Physical Address/ Location /Directions 105 LANCE LANE/LANCE CIRCLE

Description: LifeTime _____ 5 Year /

TYPE FACIL RES #EMPLOY _____ #BEDRMS 4 GPD 480 LTAR 13
TYPE WAT County TYPE SYS A TYPE REP P/A BSMT NO BST FX N/A
SIZE TANK 1000 SIZE CHB N/A SIZE NITR 3'x4'00" MTD 24"
COMMENTS Maintain all setbacks, use serial distribution

Septic Contractors are responsible for notifying the health department for final inspections, between 8:00-9:00 AM on the day of completion, Monday - Friday. Any request for final inspections received afterwards will be scheduled the same day, if possible, or the next workday. Have permit number and owner/applicant's name ready when making the call.

Actions of representatives of state or local agencies engaged in the evaluation and determination of measures required to effect the compliance with the provisions of this permit shall in no way be taken as a guarantee that wastewater disposal systems permitted and approved will function in a satisfactory manner for any given period of time, or that such employees assume any liability for damages, consequential or direct which are caused, or may be caused, by a malfunction of this wastewater treatment and disposal system.

Proper precautions must be taken to assure the proper functioning of the system after it has been covered. Do not run any heavy equipment over the system, as soft earth will allow damage to the tank and lines. Pipe all roof drains away from the septic system site to prevent flooding of the lines from surface water. Terrace the ground to prevent excessive drainage from higher areas adjacent to the system. Do not construct driveways over any part of the septic system unless proper provisions were made when the septic system was constructed. Only grass, not trees or shrubbery, should be cultivated over the lines. All plumbing fixtures should be carefully inspected periodically and any problems repaired immediately. All septic tanks should be pumped off by a permitted pump operator on a regular schedule, not to exceed every five years.

The improvement permit and construction authorization is a site approval, for the future installation of a wastewater treatment and disposal system. Changes in ownership of the site do not affect the validity of this permit. However, any alteration of the site or soil conditions, changes in the location of the proposed facility, changes to the wastewater flow and/or characteristics, or submittal of false information with the application or misrepresentation of the property lines may subject this permit to suspension or revocation.

FOR THIS TO BE A VALID CONSTRUCTION AUTHORIZATION, A LAYOUT SHEET MUST BE ATTACHED

IMPROVEMENT PERMIT

DATE 12-7-07 EHS

CONSTRUCTION AUTHORIZATION

DATE 12-7-07 EHS

Shad Leonard
Shad Leonard

919 562 1820

PAGE 2 OF 2

Franklin County Health Department

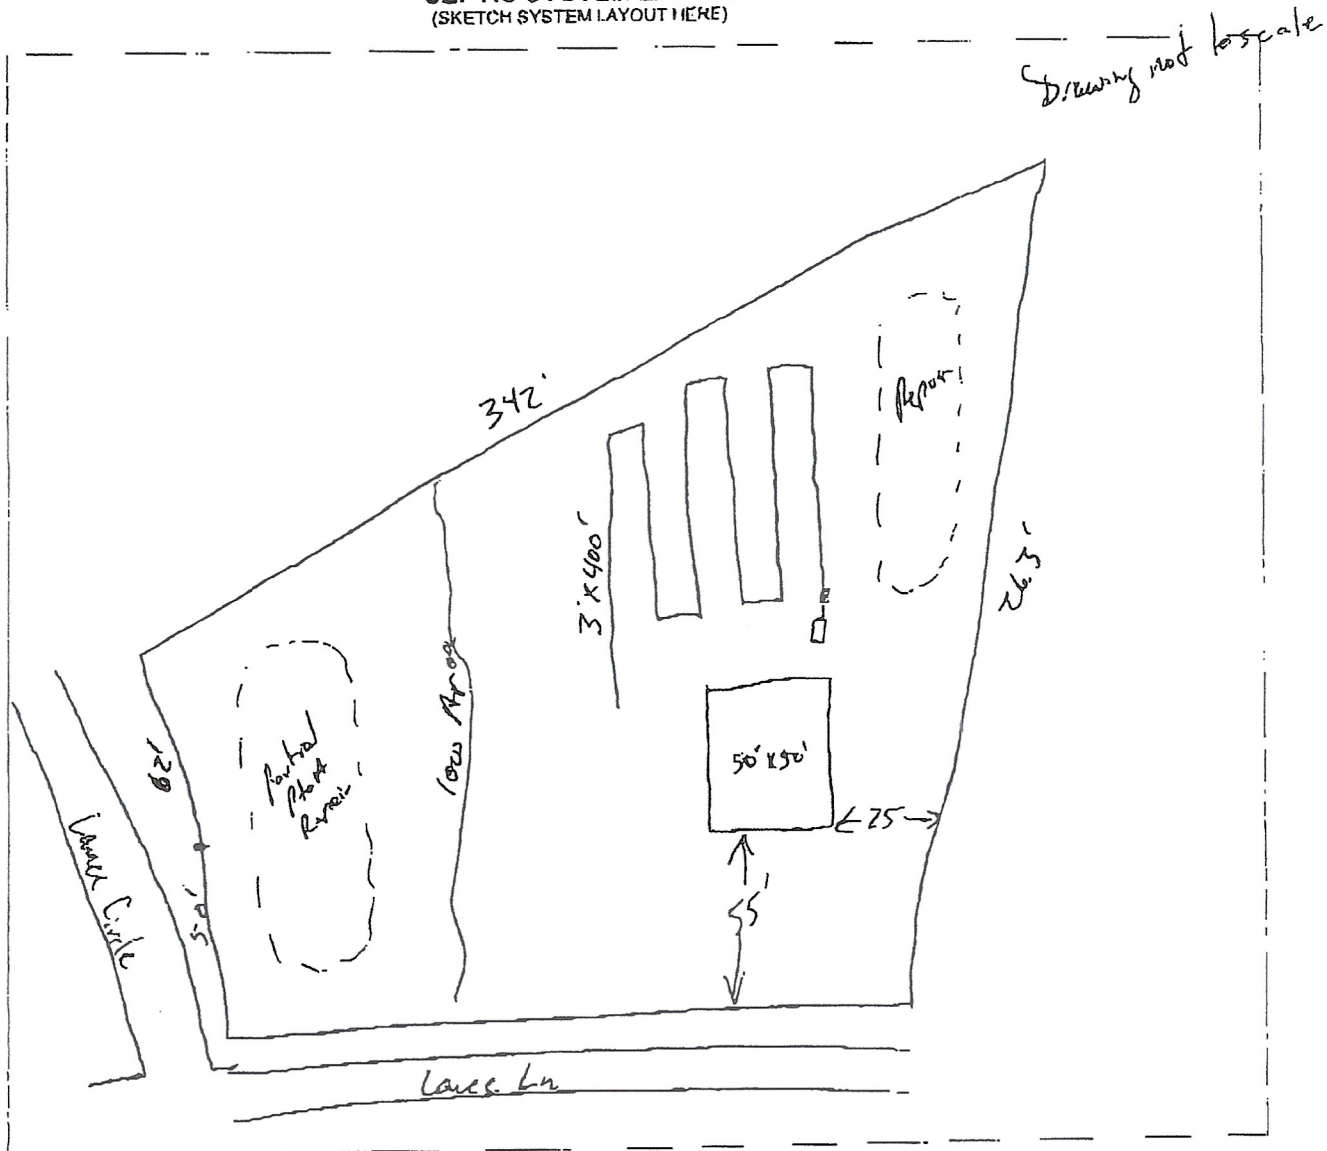
Name: SHARPE HOME CO

Permit Number

4094

CONTRACTOR . _____ TANK MANU _____ MANU DATE . _____

WELL INSTALLED YES _____ NO _____ SYSTEM CODE _____

SEPTIC SYSTEM LAYOUT
(SKETCH SYSTEM LAYOUT HERE)**SEPTIC SYSTEM AS-BUILT**
(IF DIFFERENT FROM INITIAL LAYOUT)
ON REVERSE

OPERATIONS PERMIT

DATE _____ EHS _____