



Existing System Approval

Franklin County Health Department
Environmental Health Section
107 Industrial Drive
Louisburg, NC 27549
Phone: Fax:

For Office Use Only

*CDP File Number:
393807

County ID Number:

Evaluated For:
EXISTING

Permit Valid Until:

Applicant: MATTHEW HOWARD

Address: 120 WINNEBAGO LOOP

City: LOUISBURG

State/Zip: NC / 27549

Phone #:

Property Owner: MATTHEW HOWARD

Address: 120 WINNEBAGO LOOP

City: LOUISBURG

State/Zip: NC / 27549

Phone #:

Property Location & Site Information

Address: 120 WINNEBAGO LP Subdivision: LOT ROYALE Phase: Lot:

Road#: LOUISBURG NC 27549 Township:

*Structure: OTHER

of Bedrooms: 0 # of People: 0 Directions: 120 WINNEBAGO

*Water Supply: N/A Type of business: ACCESSORY BUILDING

Basement: ☐ Yes ☒ No Total sq. Footage: No. Of Employees:

*Proposed Improvement:

*Release Conditions: PROPOSED ACCESSORY BUILDING MEETS SEPTIC SETBACKS

This release in no way expresses or implies that the existing subsurface sewage treatment and disposal system serving the site will continue to function for any period of time.

Applicant/Legal Reps. Signature Required? ☐ Yes ☐ No

Applicant/Legal Reps. Signature: *Date:

*Issued By: Bendel, Joel *Date of Issue: 05/10/2023

Authorized State Agent:

****Site Plan/Drawing attached.****

☐ Hand Drawing

☐ Import Drawing

Total Time: (HH:MM)

Hours Minutes

Activity Code: -



CDP
393807

Franklin County Environmental Health
127 S Bickett Blvd.
Louisburg, NC 27549
Phone (919) 496-8100
www.franklincountync.gov

Issued to: **Matthew Howard**

Location: **120 WINNEBAGO LP LOUISBURG , NC 27549**

SEPTIC RECHECK APPLICATION

Application Type: SEPTIC RECHECK

Application Number: **E-23-443**

Building Type:

Project Type: Accessory Building (e.g. Detached Garage, Carport, Storage Building)

of Bedrooms: 0

Residential Project Type: Accessory Building with Plumbing

Building Foundation: N/A

Water Source: Public Water

Past Expansions or Repairs: No

Year Septic System was Installed:

Parcel ID #: **022992**

Date: April 24, 2023

Acreage: 0.45

Zoning: R-30

of Occupants: 0

Commercial Project Type:

Square Footage of Facility:

Number of Employees:

Number of Seats:

Notes:

Subdivision: LOTS ROYALE C 1320 1321

Septic System Recheck for:

Replacing dwelling in the same footprint as previous (same size in the same location):

Replacing dwelling in a different footprint (different size and/or location):

Wastewater flow change (bedrooms/occupant and/or business different from previous):

Addition to the dwelling (enlarge building footprint):

Deck/Porch addition:

Pool addition:

Regulatory compliance check (municipality or Lake Royale):

Accessory building/garage with no plumbing: true

Accessory building garage with plumbing: , , ,

Applicant Information

Applicant Name: Matthew Howard

Address: 120 Winnebago Loop Louisburg , Nc 27549

Phone: 6154804021

Email: jennifershoward@icloud.com

Property Owner Information

Owner Name: MATTHEW GREGORY HOWARD

Address: 3821 WESTBURY LAKE DR RALEIGH , NC 27603

Phone:

Email:

General Contractor Information

Contractor Name: Eagle Carports, Inc.

Address: 210 Airport Road Mount Airy , NC 27030

Phone: (800) 579-8589

Email:

Zoning

Zoning Permit #: Z-23-625

Front Setback: 15

Left Setback: 5

County Water: No


Right Setback: 5

Rear Setback: 5

The applicant shall notify the Environmental Health Department upon submittal of this application if any of the following apply to the property/site in question. If this answer is "Yes" the applicant must attach supporting documentation and/or show their location on the plot/site plan.

Does the site contain any jurisdictional wetlands? No

Does the site contain, or have within 100 feet, any existing wells and/or septic systems? Yes

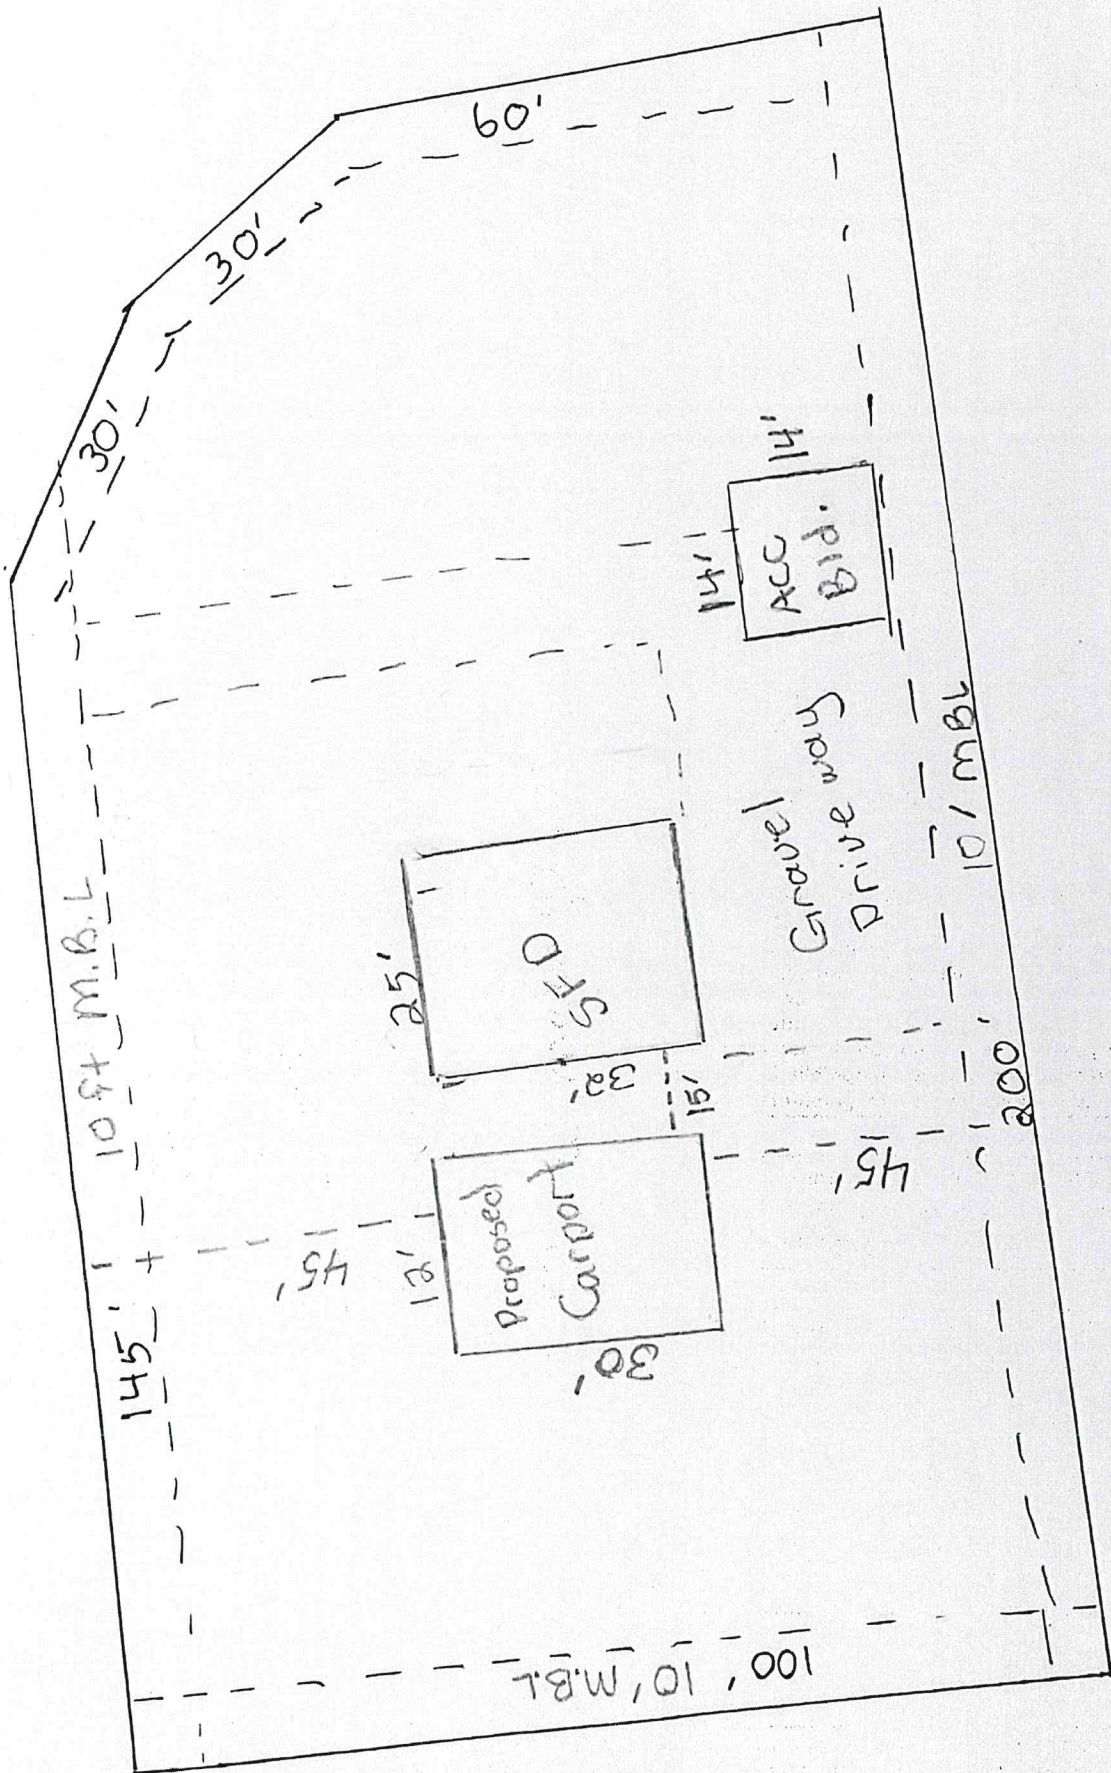

120 Wimebago Loop

