

FRANKLIN COUNTY HEALTH DEPARTMENT

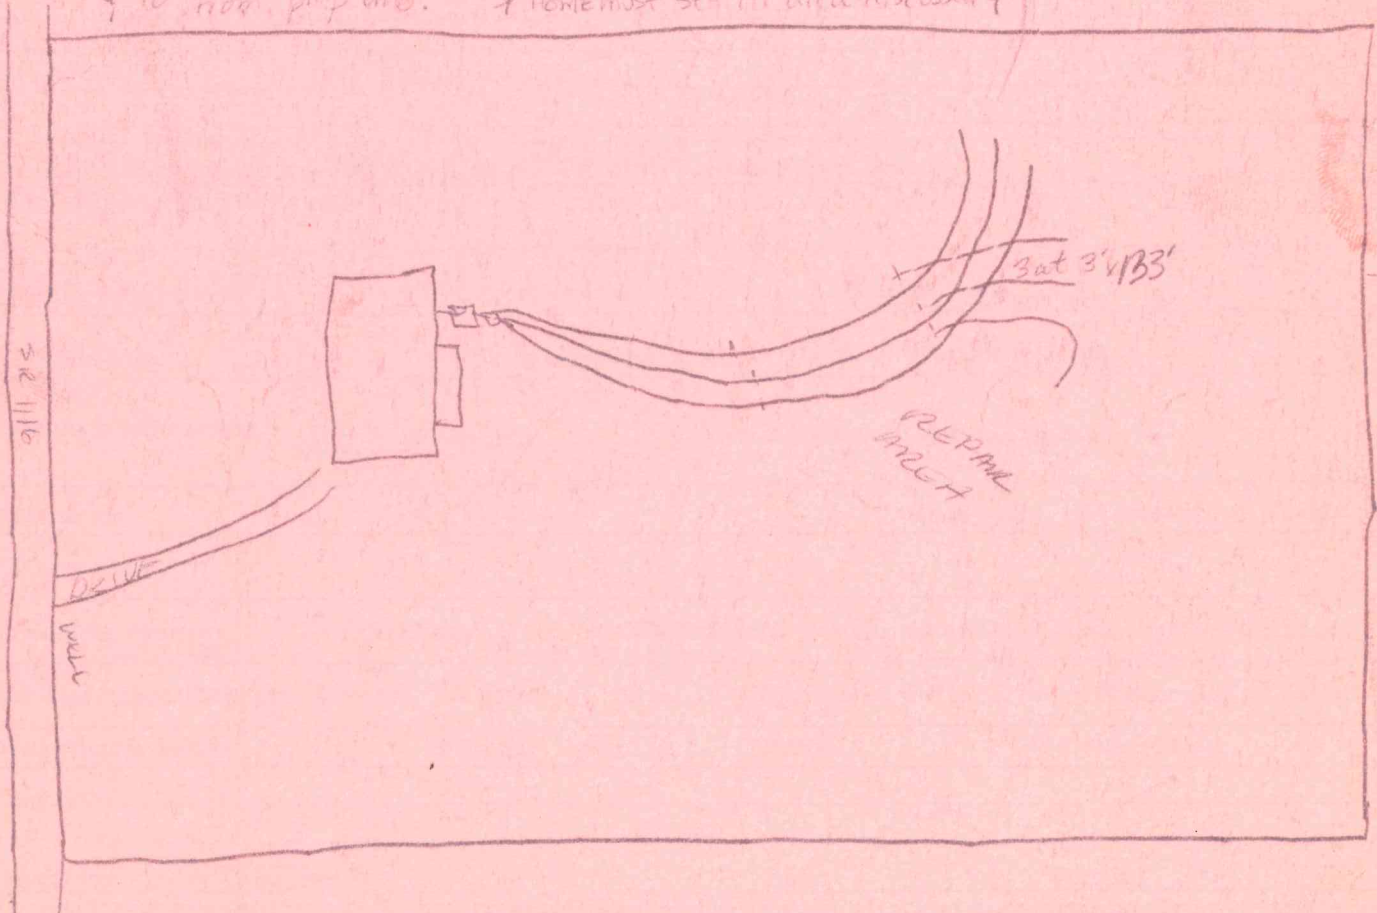
9/130

PERMIT NUMBER: 37051	DATE: IMPROVEMENTS PERMIT 02.18.92	26729	SIZE
APPLICANT: JOHNSON EUGENE 3806 ELLIS STREET CAPITAL HEIGHTS MD 20743 TELEPHONE: 455-3712		OWNER: JOHNSON EUGENE 3806 ELLIS STREET CAPITAL HEIGHTS MD 20743	
COMMENT: SINGLE FAMILY DWELLING		CONTRACTOR: Terry Johnson	
LOCATION / DIRECTIONS: SR 1125 & SR 1116 ~ .1 mile past Triple R Farms fence on W. side			
FEE: 50.00 23552		SIGNATURE OF OWNER OR AUTHORIZED AGENT:	

THE ABOVE SIGNATURE INDICATES THAT I HAVE READ, UNDERSTAND, AND AGREE WITH ALL PROVISIONS AND INFORMATION AS OUTLINED ON THE BACK SIDE OF THIS FORM

#BEDRMS 3 DISPOSAL - OTHER - TYPE. SYS C
SZ. TANK 100 SZ. CHAMB - NITRIFI 400' x 3' OPER. REQ N
SITE. LOC -

REMARKS: Key system shallow 24" Man! Yellow rainwater c/w. Stay 100' from well & 10' from prop line. + Home must set in area discussed &

DATE. ISSUED 3/2/92EH SPECIALIST Chris HsiehDATE. APPROVED 4/9/92EH SPECIALIST Chris Hsieh