

FRANKLIN COUNTY HEALTH DEPARTMENT

PERMIT NUMBER: <u>126500</u>	DATE: <u>12-13-2003</u>	SIZE: <u>1.290A</u>
APPLICANT: <u>CONST IMPROVE PERMIT 20030026</u>		OWNER: <u>1214 13 2370</u>
FIDELIS CONSTRUCTION INC 601 SECERT POND RD WAKE FOREST NC 27587 TELEPHONE: <u>510-1038</u> <u>570-1041</u>		ABERDEEN LLC PO BOX 20242 RALEIGH NC 27619
COMMENT: <u>SED</u>	DESCRIPTION: 5 YEAR ☒	LIFETIME: ☐
LOCATION / DIRECTIONS: <u>ABERDEEN #16 - 55 HOLSTEIN LANE YNG</u>		
FEE: <u>225.00</u>		SIGNATURE OR OWNER OR AUTHORIZED AGENT:

THE ABOVE SIGNATURE INDICATES THAT I HAVE READ, UNDERSTAND, AND AGREE WITH ALL PROVISIONS AND INFORMATION AS OUTLINED ON THE BACK SIDE OF THIS FORM

TOPO <u>PS</u>	TEXTURE <u>PS</u>	STRUCTURE <u>PS</u>	DEPTH <u>PS</u>
R. HOR <u>PS</u>	SOIL. WET <u>PS</u>	AVAIL. SP <u>PS</u>	OTHER <u>PS</u>
MINRL <u>PS</u>	OVERALL <u>PS</u>	LTAR <u>0.35</u>	
#BEDRMS <u>4</u>	GPD <u>480</u>	DISPOSAL	TYPE. SYS <u>Coax</u>
SZ. TANK <u>1000</u>	SZ. CHAMB	NITRIFI <u>3'x450'</u>	TYPE. WAT <u>Publ</u>
SITE. LOC	MAX TRENCH DEP <u>30"</u>	TYP. FAC <u>SED</u>	

REMARKS: *DRAWING NOT TO SCALE

*EXACT SYSTEM LOCATION MAY VARY ACCORDING TO CONTOUR

CONTRACTOR: David Brentley & Sons


TANK MANUF: D-B 1000

MANUF DATE: 12-30-03

* Install SYSTEM along Contour & IN DRY Conditions

* Do Not Park or Drive over SYSTEM AREA

* Verify EXACT LOCATION ONCE Construction begins!

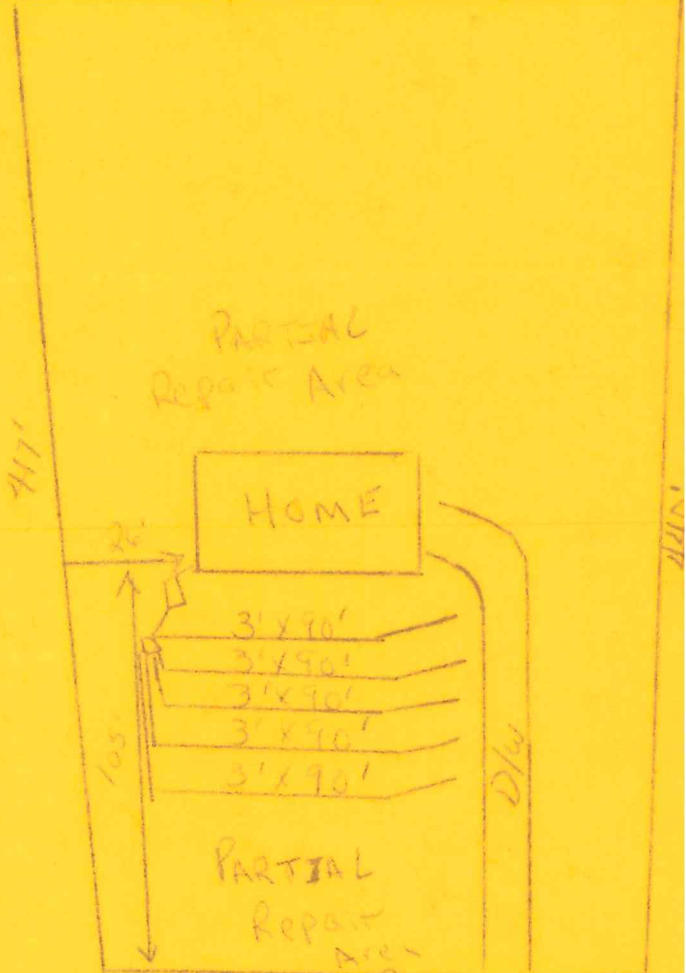

IMPROVEMENT PERMIT DATE: 8/26/03

CONSTRUCTION AUTHORIZATION DATE: 8/26/03

OPERATION PERMIT DATE: 2/2/04

ENV HEALTH SPEC: Judy Smith, RS

ENV HEALTH SPEC: Judy Smith, RS

ENV HEALTH SPEC: Judy Smith, RS

FRANKLIN COUNTY SOIL/SITE EVALUATION SHEET

APPLICANT Fidelis Constr. PROPERTY ID _____
 WATER SUPPLY Public DATE _____
 LOCATION/DIRECTIONS Aberdeen Lot 16

FACTORS

PROFILES

		1	2	3	4	5	6
LANDSCAPE POSITION	1940	S					
SLOPE (%)	1940	<0%					
HORIZON I DEPTH	1943	0-10					
TEXTURE	1941(a) (1)	SCL					
CONSISTENCE	1941	FR					
STRUCTURE	1941(a)(2)	SRU					
CLAY MINEROLOGY	1941(a)(3)	NXP					
HORIZON II DEPTH	1943	10-42					
TEXTURE	1941(a) (1)	CL					
CONSISTENCE	1941	FI					
STRUCTURE	1941(a)(2)	SRU					
CLAY MINEROLOGY	1941(a)(3)	SXP					
HORIZON III DEPTH	1943						
TEXTURE	1941(a) (1)						
CONSISTENCE	1941						
STRUCTURE	1941(a)(2)						
CLAY MINEROLOGY	1941(a)(3)						
HORIZON IV DEPTH	1943						
TEXTURE	1941(a) (1)						
CONSISTENCE	1941						
STRUCTURE	1941(a)(2)						
CLAY MINEROLOGY	1941(a)(3)						
SOIL WETNESS	1941	742"					
RESTRICTIVE HORIZON	1944	742"					
SAPROLITE	1943/1956	42"					
CLASSIFICATION	1948	PS					
LTAR (gpd/ft2)	1955	.35					
OTHER FACTORS (1946)			SITE LTAR (gpd/ft2) .35				
AVAILABLE SPACE (1945) PS			SYSTEM TYPE Conv.				
CLASSIFICATION (1948) PS							
EVALUATED BY: ANDY S.			OTHERS PRESENT				

COUNTY OF FRANKLIN

ENVIRONMENT HEALTH APPLICATION (496-8100)

Permit #: 10028

Permit Type: SEPTIC PERMIT

Date Issued: 08/25/2003

Project Address: 55 HOLSTEIN LANE, YOUNGSVILLE, NC 27596

Location: 55 HOLSTEIN LANE

Subdivision: ABERDEEN (WATER)

Size #: 1.290

Lot #: 16

Applicant: FIDELIS CONSTRUCTION, INC

601 SECRET POND RD

WAKE FOREST, NC 27587

Phone: 919-570-1041

Owner: ABERDEEN LLC

Phone:

P O BOX 20242

RALEIGH NC 27619

Tax record: 35708

Pin #: 1844-13-2370

Parcel #: B04C00 016

Zoned: R 40

Setbacks Front: 50

Rear: 50

Side: 20

Proposed Use: SFD

of bedrooms: 4

of people: 4

Type Wastewater - Sewage: _____

Industrial Process Wastewater: _____

Type Water Supply - Private: _____

Community: _____

Previously Identified Jurisdictional Wetland - Yes: _____

No: _____

Township: YOUNGSVILLE Public Water/Sewer: COUNTY

ST Road #:

Desc:

Fees Due: \$225.00

Date Paid: 08/25/2003

Special Conditions:

Call Environment Health (496-8100) between 8:00 AM and 9:00 AM Monday thru Friday to schedule an appointment with the environment health specialist to evaluate your lot. He/She will show you where to locate the well and septic system, in relation to the desired dwelling location and any property lines. If approved, an improvements permit will be issued. After the septic tank has been installed and approved, the Sanitarian will issue a certification of completion.

I certify that all the statements made in this application and any attached documents are true, complete and correct to the best of my knowledge and belief and are made in good faith. I understand that false information may be grounds for rejection of this application. Authorized county representatives are granted right of entry to make evaluations or inspections and to release information upon public request.



(Signature of Contractor, Authorized Agent or Owner)

8 / 25 / 03

Date

Franklin County DRC Application

RESIDENTIAL

Zoning Permit #: 6833



ADDRESS: **55 HOLSTEIN LANE**
 PARCEL NO.: **1844-13-2370** ZONING: **R 40**
 SUBDIVISION: **ABERDEEN (WATER)** LOT: **16**
 ISSUED TO: **FIDELIS CONSTRUCTION INC**
601 SECRET POND RD
WAKE FOREST, NC 27587
 PHONE NUMBER: **919-570-1041**
 SETBACK: FRONT: **50** RIGHT: **20** LEFT: **20** REAR: **50**
 COUNTY WATER: **COUNTY** FLOODPLAIN: **NO**
 PERMIT TYPE: **ZONING PERMIT**
 TYPE OF CONSTRUCTION: **SINGLE FAMILY DWELLING**
 PERMIT DATE: **08/25/2003** WATERSHED **NO**
 TOWNSHIP **YNGS** EXPIRE DATE: **02/25/2004**

It is hereby certified that the above use as shown on the plats and plans submitted with this application conforms with all applicable provisions of the Franklin County Zoning Ordinance. The issuance of this application does not allow the violation of Franklin County Zoning Ordinance or other governing regulations. The applicant is responsible for obtaining a building permit (if required) prior to commencing work on the proposed improvement. A final zoning inspection must be scheduled by the applicant.

NOTES:

I hereby certify that all information I have provided to the Planning Department is true and accurate.

APPLICANTS SIGNATURE:


[Handwritten Signature]

UTILITY COMPANY : **PROGRESS ENGERY** **WAKE ELECTRIC** **OTHER**
 NUMBER OF STORIES: 1 **1 1/2** **2** **2 1/2**
 SQUARE FOOTAGE: HEATED **UNHEATED** **TOTAL**
 BASEMENT: **N/A** **YES** **NO** **MANUFACTURED**
 FIREPLACE: **N/A** **MASONARY** **MANUFACTURED**
 PLAN SETS: **MODULAR** **STICKBUILT**
 ELECTRICIAN: **MECHANICAL:**
 PLUMBING:
 MULTI USE PLAN #
 COST OF CONSTRUCTION:

NO MORE THAN 2 STRUCTURAL DEVIATIONS OR PLANS MUST BE REDRAWN

DEPARTMENTAL USE ONLY

	INITIALS (IN)	DATE	INITIALS (OUT)	DATE
ZONING	<i>[Signature]</i>	8/25/03		
INITIAL PERMITTING				
ADDRESSING				
PLAN REVIEW				
FIRE REVIEW				
SEPTIC/SEWER				
FINAL PERMITTING				

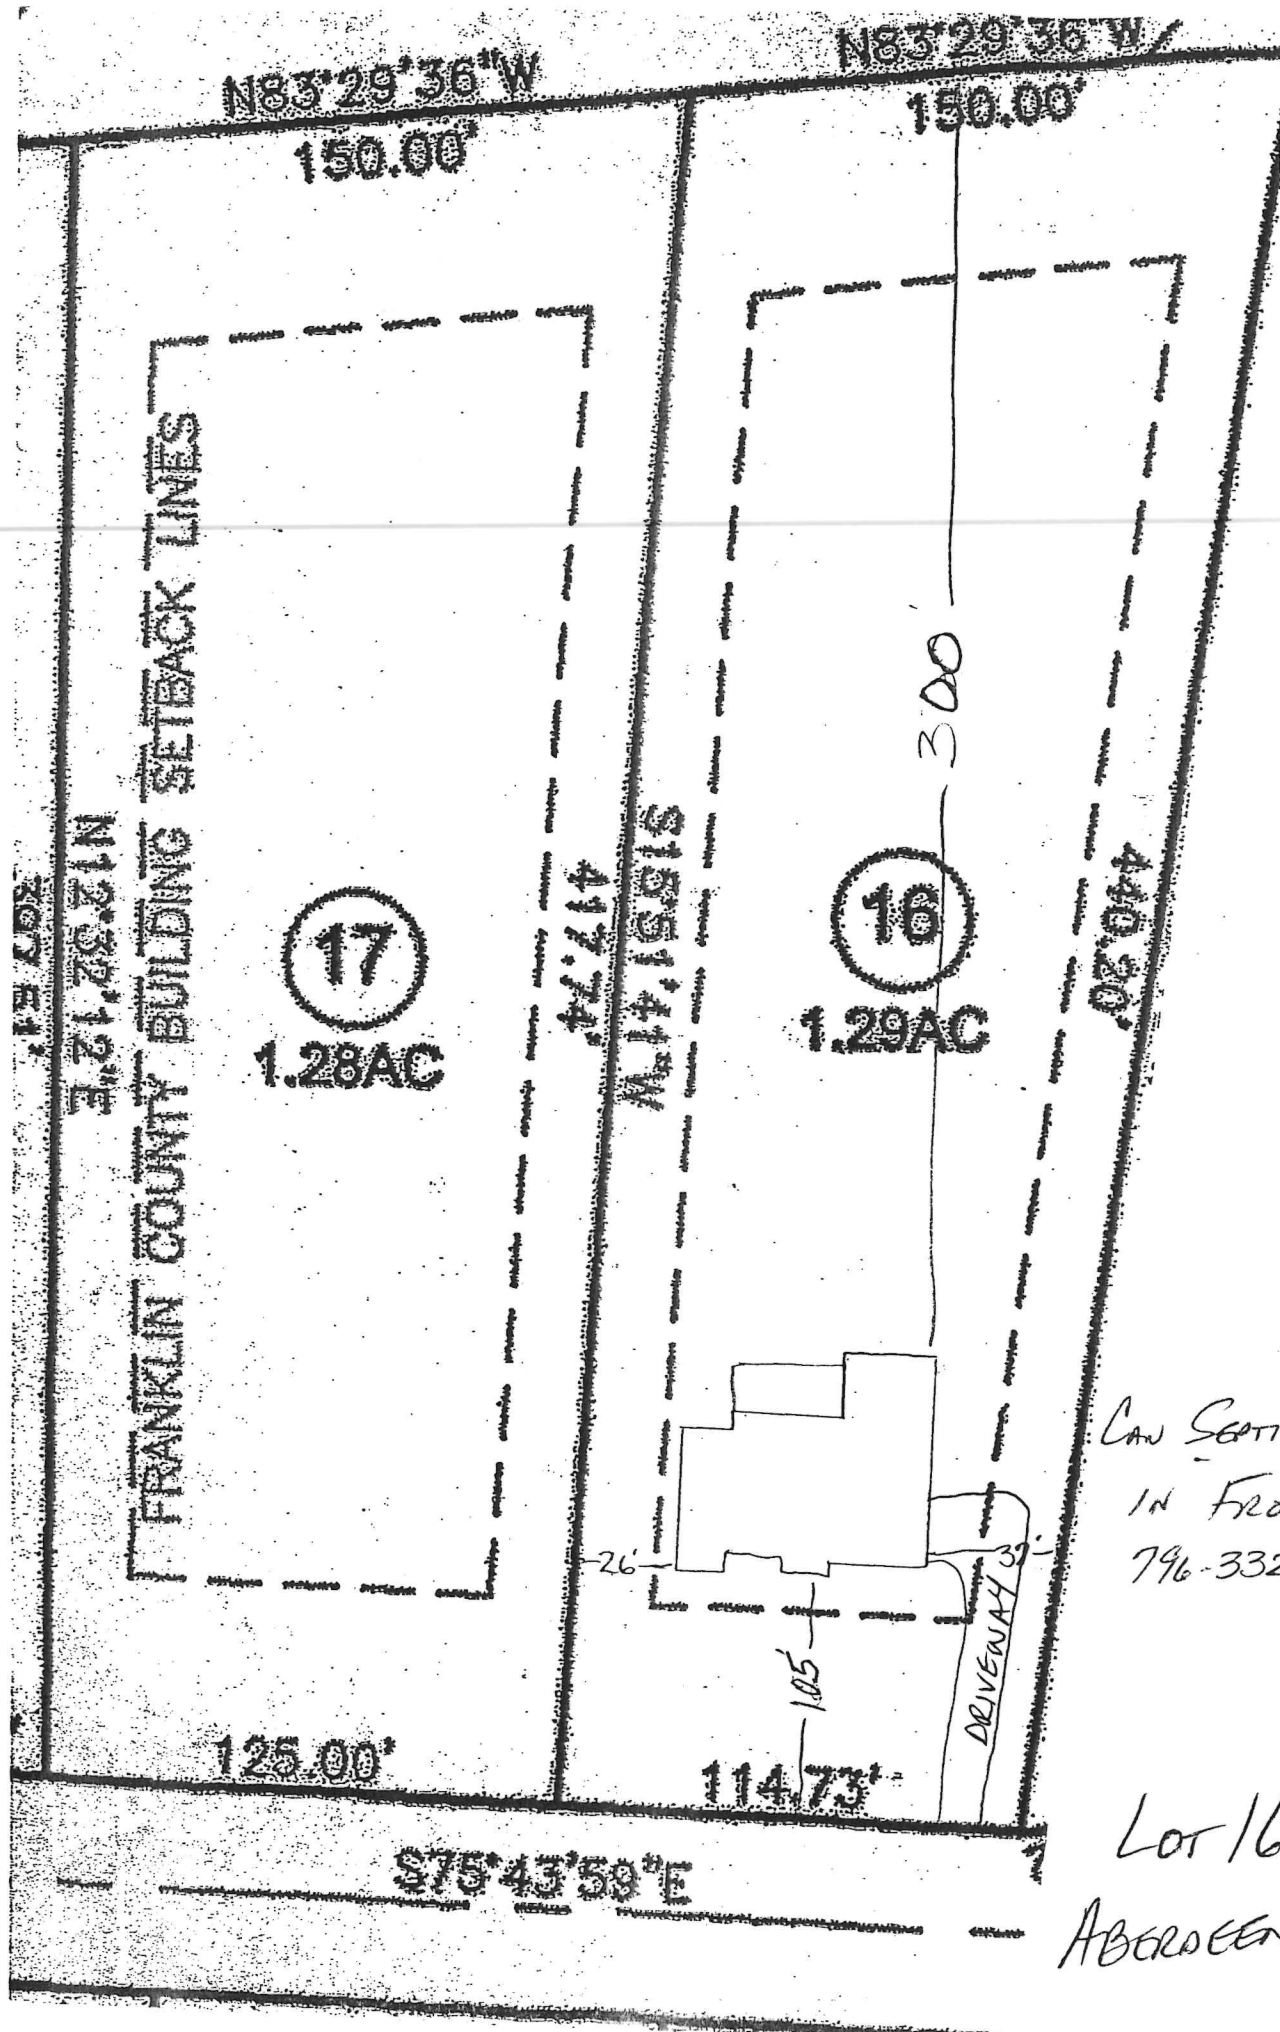

CAN SEPTIC E
IN FRONT
796-3324

Lot 16
ABERDEEN