

252-478-5569

FRANKLIN COUNTY HEALTH DEPARTMENT

PERMIT NUMBER: 16935C CONST IMPROVE PERMIT 20021120	DATE: 2017-08-30/29	SIZE: 1700
APPLICANT: WALTON WILLIAM 1965 MOULTON RD LOUISBURG NC 27549	OWNER: WALTON WILLIAM	
TELEPHONE: 496-1651		
COMMENT: SFD	DESCRIPTION: 5 YEAR ☐	LIFETIME: ☐
LOCATION / DIRECTIONS: MOULTON RD		
FEE: 225.00	SIGNATURE OR OWNER OR AUTHORIZED AGENT:	

THE ABOVE SIGNATURE INDICATES THAT I HAVE READ, UNDERSTAND, AND AGREE WITH ALL PROVISIONS AND INFORMATION AS OUTLINED ON THE BACK SIDE OF THIS FORM

TOPO <u>1/5</u>	TEXTURE <u>PS</u>	STRUCTURE <u>1/5</u>	DEPTH <u>1/5</u>
R. HOR <u>5</u>	SOIL. MET <u>5</u>	AVAIL. SP <u>1/5</u>	OTHER <u>-</u>
MIN. L <u>5'X1'</u>	OVERALL <u>PS</u>	LTAR <u>.35</u>	
#BEDAMS <u>6</u>	GPD <u>720</u>	DISPOSAL <u>N</u>	TYPE. SYS <u>Innov.</u>
SZ. TANK <u>1500</u>	SZ. CHAM <u>-</u>	NITRIFI <u>3'X515'</u>	TYPE. MAT <u>Puv</u>
SITE. LOC <u>3.17</u>	MAX TRENCH DEP <u>24"</u>	TYP. FAC <u>SFD</u>	

REMARKS:

* Drawing not to scale
 * Must use Innovative 515'

CONTRACTOR: Vernon DickersonTANK MANUF: Ellis 1500 SFS 109MANUF DATE: 9-18-03

* Install Interceptor drain 10'
 upslope of initial system to
 divert water movement

* Maintain all setbacks

* Any questions call 496-8100

18" wide

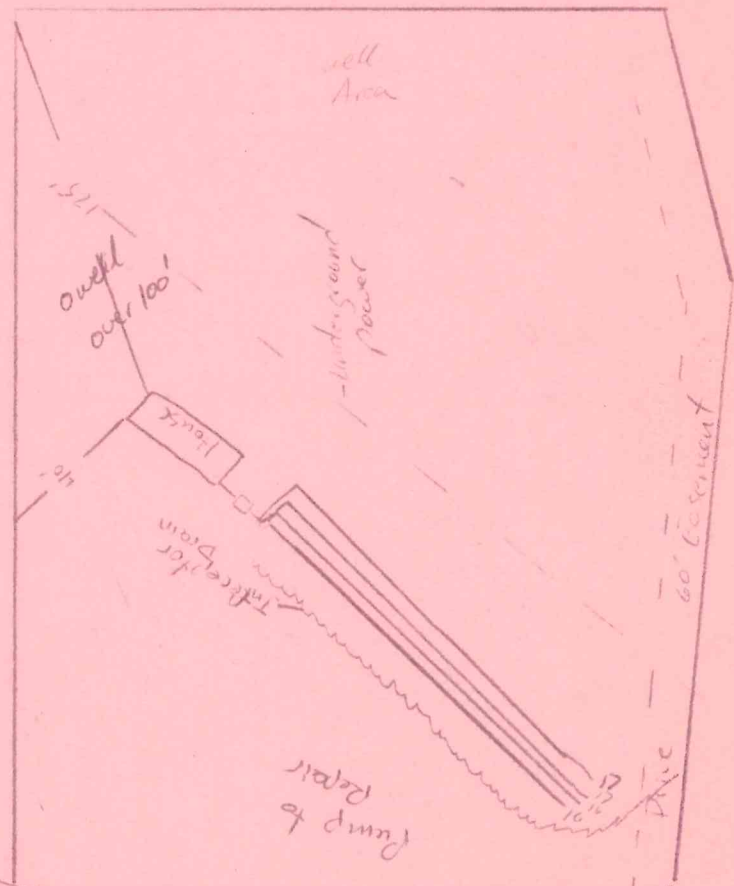
2' deep

1' stone + pipe

Leave lip on lower
 side to catch water

~~83~~ panels
 83

Moulton Rd

IMPROVEMENT PERMIT DATE: 11/21/02ENV HEALTH SPEC: Shad LeonardCONSTRUCTION AUTHORIZATION DATE: 11/21/02ENV HEALTH SPEC: Shad LeonardOPERATION PERMIT DATE: 11/25/03ENV HEALTH SPEC: Shad Leonard

COUNTY OF FRANKLIN

ENVIRONMENT HEALTH APPLICATION (496-8100)

Permit #: **8193**Permit Type: **SEPTIC PERMIT**Date Issued: **11/13/2002**Project Address: **MOULTON RD.,**Location: **MOULTON RD.**

Subdivision:

Lot #:

Size #: **3.170**

Applicant: **WALTON WILLIAM**
1065 MOULTON RD
LOUISBURG, NC 27549

Phone: **496-1651**

Contractor:

Phone:

Proposed Use: **SFD**

Work:

Desc:

Bldg Cost: \$0	Fees Due: \$225.00	Date Paid: 11/13/2002
Zoned: AR	Setbacks Front: 30	Rear 25 Side 10
Tax record: 34765	Pin #: 2817-48-3039	Parcel #: I04 00 017B
Township: LOUISBURG	Public Water/Sewer: PRIVATE	ST Road #:
Special Conditions/Property Owner: WALTON WILLIAM		
# of bedrooms: 6 # of people: 7 Approved for Issuance by:		
** Environmental Health Use Only **		
Type Wastewater - Sewage: _____ Industrial Process Wastewater: _____		
Type Water Supply - Private: _____ Community: _____		
Previously Identified Jurisdictional Wetland - Yes: _____ No _____		
I certify that all the statements made in this application and any attached documents are true, complete and correct to the best of my knowledge and belief and are made in good faith. I understand that false information may be grounds for rejection of this application. Authorized county representatives are granted right of entry to make evaluations or inspections and to release information upon public request.		

Call Environment Health (496-8100) between 8:00 AM and 9:00 AM Monday thru Friday to schedule an appointment with the environment health specialist to evaluate your lot. He/She will show you where to locate the well and septic system, in relation to the desired dwelling location and any property lines. If approved, an improvements permit will be issued. After the septic tank has been installed and approved, the Sanitarian will issue a certification of completion.

William L. Walton
(Signature of Contractor, Authorized Agent or Owner)

11/13/2002
Date

Franklin County DRC Application

RESIDENTIAL



Zoning Permit #: 5880

ADDRESS: MOULTON RD.

PARCEL NO.: 2817-48-3039

ZONING: AR

SUBDIVISION:

**ISSUED TO: WALTON WILLIAM
1065 MOULTON RD.
LOUISBURG, NC 27549**

PHONE NUMBER: 496-1651

SETBACK: FRONT: 30 RIGHT: 10 LEFT: 10 REAR: 25

COUNTY WATER: NO FLOODPLAIN: NO

PERMIT TYPE: ZONING PERMIT

TYPE OF CONSTRUCTION: 60 X 35 SFD

PERMIT DATE: 11/13/2002 WATERSHED NO

TOWNSHIP LOU EXPIRE DATE: 05/13/2003

It is hereby certified that the above use as shown on the plats and plans submitted with this application conforms with all applicable provisions of the Franklin County Zoning Ordinance. The issuance of this application does not allow the violation of Franklin County Zoning Ordinance or other governing regulations. The applicant is responsible for obtaining a building permit (if required) prior to commencing work on the proposed improvement. A final zoning inspection must be scheduled by the applicant.

I hereby certify that all information I have provided to the Planning Department is true and accurate.

APPLICANTS SIGNATURE:

William L. Walter

UTILITY COMPANY : CP & L **WAKE ELECTRIC** **OTHER**
NUMBER OF STORIES: 1 1 1/2 2 2 1/2
SQUARE FOOTAGE: HEATED UNHEATED **TOTAL**
BASEMENT: N/A YES NO **MANUFACTURED**
FIREPLACE: N/A **MASONARY** **MANUFACTURED**
PLAN SETS: MODULAR STICKBUILT
ELECTRICIAN: **MECHANICAL:**
PLUMBING:
MULTI USE PLAN #
COST OF CONSTRUCTION:

NO MORE THAN 2 STRUCTURAL DEVIATIONS OR PLANS MUST BE REDRAWN

DEPARTMENTAL USE ONLY

	INITIALS (IN)	DATE	INITIALS (OUT)	DATE
ZONING	<i>W.L.W.</i>	<i>5/13/02</i>		
INITIAL PERMITTING				
ADDRESSING				
PLAN REVIEW				
FIRE REVIEW				
SEPTIC/SEWER				
FINAL PERMITTING				

2
16
16
17
7
to panels

COUNTY OF FRANKLIN

ENVIRONMENT HEALTH APPLICATION (496-8100)

Permit Type: **SEPTIC PERMIT**

Issued: 11/13/2002

8193

Address: **MOULTON RD.,**

Location: **MOULTON RD.**

Division:

Lot #:

Size #: **3.170**

Ant: **WALTON WILLIAM**
1065 MOULTON RD
LOUISBURG, NC 27549

Phone: **406-1651**

Adm:
Steel

Contractor:

Phone:

side plan
change d/k.
MDW

Proposed Use: **SFD**

Work:

Desc:

Bldg Cost: \$0	Fees Due: \$225.00	Date Paid: 11/13/2002
Zoned: AR	Setbacks Front: 30	Rear 25 side 10
Tax record: 34765	Pin #: 2817-48-3039	Parcel #: 104 00 017B
Township: LOUISBURG	Public Water/Sewer: PRIVATE	ST Road #:
Special Conditions/Property Owner: WALTON WILLIAM		
# of bedrooms: 6	# of people: 7	Approved for Issuance by:
** Environmental Health Use Only ** Type Wastewater - Sewage: _____ Industrial Process Wastewater: _____ Type Water Supply - Private: _____ Community: _____ Previously Identified Jurisdictional Wetland - Yes: _____ No _____		
I certify that all the statements made in this application and any attached documents are true, complete and correct to the best of my knowledge and belief and are made in good faith. I understand that false information may be grounds for rejection of this application. Authorized county representatives are granted right of entry to make evaluations or inspections and to release information upon public request.		

Call Environment Health (496-8100) between 8:00 AM and 9:00 AM Monday thru Friday to schedule an appointment with the environment health specialist to evaluate your lot. He/She will show you where to locate the well and septic system, in relation to the desired dwelling location and any property lines. If approved, an improvements permit will be issued. After the septic tank has been installed and approved, the Sanitarian will issue a certification of completion.

William L. Walton
(Signature of Contractor, Authorized Agent or Owner)

11/13/2002
Date

S 77°05'00"E 823.22'

616.73'

CC EIP

Existing 60' Easement

See D.B. 969, Pg. 329

S 68°00'24"E 358.34'

S 40°15'49"W 62.74'

S 43°10'24" 137.36'

①

3.17 ACRES
D.B. 785, Pg. 344
D.B. 778, Pg. 365

N 18°12'03"E 255.74'

NIP

N 68°00'24"W 407.85'

NIP

NPK

EPK

EPK

12.44 ACRES
D.B. 785, Pg. 344
D.B. 778, Pg. 365

②

Site plan O.K.
MDW
11/20/02

ADDN:
Shad

S 33°50'E 603.10'

NIP

N 71°42'40"E 180.05'

68.24'

186.84'

13.23'

S 35°50'23"W 200.07'

S 52°11'53"W 314.62'

S.R. 1414

60' PUBLIC R/W

I hereby certify that I of the property shown hereon, which was conveyed, that I hereby adopt my subdivision the streets and establish all streets, parks, drainage ways, and dedicate all the to public use that the I certify that the Ordinance of Franklin

02/13/01
Date

Ch

I certify that the plat shown hereon complies with the Watershed Protection Ordinance and is approved by the Watershed Administrator for recording in the Register of Deeds Office.

NOTE: This property is located within a Public Water Supply Watershed and development restrictions may apply.

Doreen P. Wood
Watershed Administrator

been grc

William Walton

Factors	Profile 1	Profile 2	Profile 3	Profile 4	Profile 5	Profile 6
Landscape Position						
Slope						
Horizon I Depth	0-12	0-18	0-8	0-18		
Texture Group	SL	SL	SL	SL		
Consistence	A, ns, np	A, ns, np	A, ns, np	A, ns, np		
Structure	gr	gr	gr	gr		
Mineralogy	SFXP	SFXP	SFXP	SFXP		
Horizon II Depth	12-36	18-40	8-20	18-30		
Texture Group	SL	SL	SL	SL		
Consistence	A, ss, sp	A, ss, sp	A, ss, sp	A, ss, sp		
Structure	SBK	SBK	SBK	SBK		
Mineralogy	SFXP	SFXP	SFXP	SFXP		
Horizon III Depth			20-38			
Texture Group			cl/sap			
Consistence			A, ss, sp			
Structure			SBK/gr			
Mineralogy			SFXP			
Horizon IV Depth						
Texture Group						
Consistence						
Structure						
Mineralogy						
Soil Wetness				20"		
Restrictive Horizon						
Saprolite						
Classification	PS	PS	PS	US		
Long-Term Acceptance Rate	.35	.35	.35			

Site Classification: PS Site Long-Term Acceptance Rate: .35
 Evaluated By: J. MacLean Other(s) Present: Chris Hedrick
 Remarks: Innovative (interceptor drain needed)

Landscape Position
 R-Ridge
 S-Shoulder slope
 L-Linear slope
 FS-Foot slope
 N-nose slope
 H-Head slope
 Cc-Concave slope
 Cv-Convex slope
 T-terrace
 FP-Flood plain

Texture
 s-sand
 ls-loamy sand
 sl-sandy loam
 l-loam
 si-silt
 sil-silt loam
 sicl-silty clay loam
 cl-clay loam
 scl-sandy clay loam
 sc-sandy clay
 sic-silty clay
 c-clay

Moist Consistence
 vfr-very friable
 fr-friable
 fi-firm
 vfi-very firm
 efi-extremely firm

Wet Consistence
 ns-non-sticky
 ss-slightly sticky
 s-sticky
 vs-very sticky
 np-non-plastic
 sp-slightly plastic
 p-plastic
 vp-very plastic

Structures
 sg-single grain
 m-massive
 cr-crumb
 gr-grainular
 sbk-sub-angular blocky
 abk-angular blocky

Mineralogy
 1:1
 2:1
 mixed
Saprolite
 s-suitable

Classification
 s-suitable
 u-unsuitable
 ps-provisionally suitable
Long-Term Acceptance Rate