



Franklin County
215 E. Nash St. Louisburg, NC 27549
Phone (919) 496-2281
www.franklincountync.us

335008

Issued to: Teresa Lynne Howard

Location: 103 SITTING BULL CV LOUISBURG , NC 27549

NEW SEPTIC APPLICATION

Application Type: NEW SEPTIC

Application Number: **E-20-729**

Date: November 19, 2020

Building Type:

Acreage: 0.25

Project Type: Single Family Dwelling

Zoning: AR

of Bedrooms: 1

of People: 2

Parcel ID #: 025858

Subdivision: LOT ROYALE C

Applicant Information

Applicant Name: **Teresa Lynne Howard**

Address: 648 Ashbottle Drive Rolesville , NC 27571

Phone: 731-444-0377

Email: drlynnehowardvaughn@yahoo.com

Property Owner Information

Owner Name: Teresa Lynne Howard

Address: 648 Ashbottle Drive Louisburg , NC 27549

Phone: 731-444-0377

Email: drlynnehowardvaughn@yahoo.com

General Contractor Information

Contractor Name:

Address: ,

Phone:

Email:

Zoning

Zoning Permit #: Z-20-1632

County Water: TESI

Front Setback: 30

Right Setback: 10

Left Setback: 10

Rear Setback: 25

Call Environmental Health (919-496-8100) between 8:00 - 9:00 a.m. Monday - Friday in order to schedule an appointment with an environmental Health Specialist for your lot evaluation. This application for an improvement permit/construction authorization and well permit does not constitute approval for zoning, septic, and building permits. It will be necessary to meet all guidelines for zoning, septic, and building permits prior to construction. The application is valid for either 12 months or without expiration, depending upon documentation submitted.


Please contact the Environmental Health Department at 919-496-8100 to determine the status of your application prior to visiting the Planning & Inspections Department to obtain a building permit.

I hereby certify that I am the owner, or authorized by the owner to act as his/her legal representation. Furthermore, as legal representative (if applicable) I have advised the owner of my intention to apply for this wastewater treatment and disposal system and drinking water and well system permit.

I also certify that all of the statements made in this application and any attached documents are true, complete, and correct, to the best of my knowledge and belief, and are made in good faith. If information in this application for these improvements is falsified, changed or site is altered, then improvement permits and authorization to construct these improvements shall become invalid. Authorized county representatives are granted right of entry to make these evaluations or inspections, and to be release information upon public request.

November 19, 2020

Site Plan

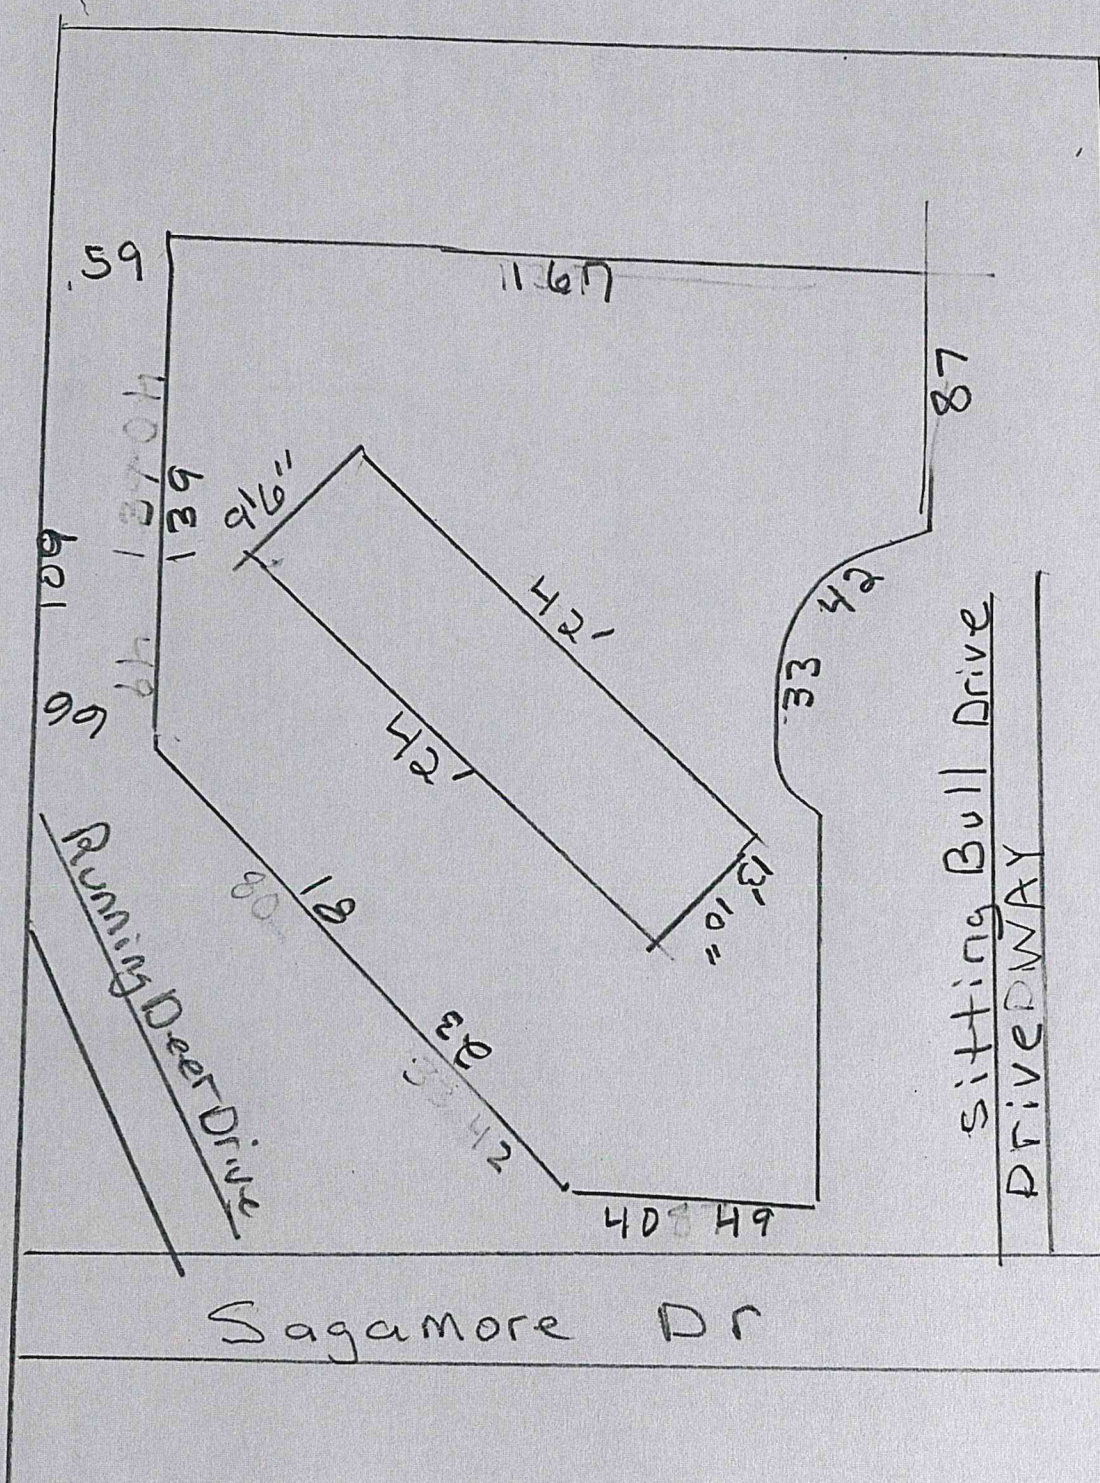

The driveway is already in place. No changes needed for it. Sitting Bull has a gravel driveway which will remain.



IMPROVEMENT PERMIT
Franklin County Health Department

107 Industrial Drive

Louisburg

NC

27549

For Office Use Only

Page 1 of 2

*CDP File Number

335008 - 1

County ID Number:

Evaluated For:

NEW

PERMIT VALID UNTIL: 1 2 / 1 5 / 2 0 2 5

*NOTE TO INSPECTIONS DIVISION: Building Permits cannot be issued with only an Improvement Permit. ☐ Fill Sheet ☐ CA?

Applicant: TERESA LYNNE HOWARD

Address: 648 ASHBRIITLE DRIVE

City: ROLESVILLE

State/Zip: NC 27571

Phone #:

Property Owner: TERESA LYNNE HOWARD

Address: 648 ASHBRIITLE DRIVE

City: ROLESVILLE

State/Zip: NC 27571

Phone #:

Address 103 SITTING BULL

Road # LOUISBURG NC 27549

Township:

Property Location & Site Information

Subdivision: LAKE ROYALE

Phase:

Lot: C

Structure: SINGLE FAMILY

of Bedrooms: 1

of People: 2

*Water Supply: N/A

Directions

103 SITTING BULL

Initial System

System Specifications

*Site Classification:

Saprolite System? ☐ Yes ☐ No

Design Flow: 2 4 0

Soil Group:

Soil Application Rate: .

*System Classification/Description:

TYPE II A. CONV SYSTEM (SINGLE-FAMILY OR 480 GPD OR LESS)

*Proposed System: 25% REDUCTION

Minimum Trench Depth: Inches

Maximum Trench Depth: 1 7 Inches

Fill Depth: Inches

Septic Tank: 1 0 0 0 Gallons

Pump Required: ☐ Yes ☒ No ☐ May Be Required

Pump Tank: Gallons

Repair System Required: ☐ Yes ☒ No ☐ No, but has Available Space

Repair System

*Site Classification:

Soil Application Rate: .

*System Classification/Description:

*Proposed System:

Minimum Trench Depth: Inches

Maximum Trench Depth: Inches

Fill Depth: Inches

Pump Required: ☐ Yes ☐ No ☐ May be Required

Pump Tank: Gallons

No grading or construction activity is allowed in areas designated for system and repair without approval of Health Department.

*Site Modifications

The issuance of this permit by the Health Department in no way guarantees the issuance of other permits. The permit holder is responsible for checking with appropriate governing bodies in meeting their requirements.

*Permit Conditions

The Department and Local Health Department may impose conditions on the issuance and may revoke the permits for failure of the system to satisfy the conditions, the rules, or this article. This permit is subject to revocation if the site plan, plat, or intended use changes (NCGS 130A-335(f)). The person owning or controlling the system shall be responsible for assuring compliance with the laws, rules, and permit conditions regarding system location, installation, operation, maintenance, monitoring, reporting, and repair (1938(b)).

*Authorized State Agent: 2739 - Joel Bendel

Date of Issue: 1 2 / 1 5 / 2 0 2 0

Authorized State Agent Signature:

Owner/Applicant Signature: _____

Site Plan/Drawing attached.

Change
Remarks

750

Change
Remarks

400



CONSTRUCTION AUTHORIZATION

Franklin County Health Department

107 Industrial Drive

Louisburg

NC

27549

For Office Use Only

Page 1 of 2

*CDP File Number 335008 - 1

County ID Number:

Evaluated For: NEW

PERMIT VALID UNTIL: 1 2 / 1 5 / 2 0 2 5

☐ Open Pump System Sheet

Applicant: TERESA LYNNE HOWARD
Address: 648 ASHBRIITLE DRIVE
City: ROLESVILLE
State/Zip: NC 27571
Phone #:

Property Owner: TERESA LYNNE HOWARD
Address: 648 ASHBRIITLE DRIVE
City: ROLESVILLE
State/Zip: NC 27571
Phone #:

Address 103 SITTING BULL
Road # LOUISBURG

NC

27549

Property Location & Site Information

Subdivision: LAKE ROYALE

Phase:

Lot: C

Township:

Directions

103 SITTING BULL

Structure: SINGLE FAMILY

of Bedrooms: 1

of People: 2

*Water Supply: N/A

System Specifications

*Site Classification:

Saprolite System? ☐ Yes ☐ No

Design Flow: 2 4 0

Soil Application Rate: .

*System Classification/Description:

TYPE II A. CONV SYSTEM (SINGLE-FAMILY OR 480 GPD OR LESS)

*Proposed System: 25% REDUCTION

Nitrification Field Sq. ft.

No. Drain Lines

Total Trench Length: 2 0 0 ft.

Trench Spacing: ☐ Inches O.C.

☐ Feet O.C.

Trench Width: ☐ Inches

☐ Feet

Aggregate Depth: inches

Minimum Trench Depth: Inches

Maximum Trench Depth: 1 7 Inches

Minimum Soil Cover: Inches from "Natural Ground Level"

Maximum Soil Cover: Inches "Natural Ground Level"

*Distribution Type: GRAVITY - PARALLEL (eq. d-box)

Septic Tank: 1 0 0 0 Gallons

Pump Required: ☐ Yes ☒ No

Pump Tank: Gallons

Grease Trap: Gallons

Septic Tank Installer ☐ I ☐ II ☐ III ☐ IV

Grade Level Required:

The issuance of this permit by the Health Department in no way guarantees the issuance of other permits. The permit holder is responsible for checking with appropriate governing bodies in meeting their requirements.

*Permit Conditions

This Authorization for Wastewater System Construction shall be valid for a period equal to the period of validity of the Improvement Permit and may be issued at the same time the Improvement Permit issued [NCGS 130A-336(b)]. If the installation has not been completed during the period of validity of the Construction Permit, the information submitted in the application for a permit or Construction Authorization is found to have been incorrect, falsified or changed, or the site is altered, the permit or Construction Authorization shall become invalid, and may be suspended or revoked [1937(g)]. The person owning or controlling the system shall be responsible for assuring compliance with the laws, rules, and permit conditions regarding system location, installation, operation, maintenance, monitoring, reporting and repair [1938(b)].

*Authorized State Agent: 2739 - Joel Bendel

*Date of Issue: 1 2 / 1 5 / 2 0 2 0

Authorized State Agent Signature:

** Site Plan/Drawing attached.**

Owner/Applicant Signature: _____

Malfunction Log ☐ Yes

☐ Hand Drawing

☐ Import Drawing

Chairs
Remo

400



File # 335008 PIN# _____

Property Address: 103 Sitting Bull CV

Applicant or Owner Name: Teresa Howard

Environmental Health Septic/Well Permit Diagram

Building permits cannot be issued nor should construction begin without Construction Authorization issuance.

☒ Septic Improvement Permit ☒ Septic Construction Authorization (CA) ☐ CA Reissue** ☐ As Built
☐ Well Construction Authorization ☐ Additional Diagram/Specifications Attached

Diagram Date**: 12-15-20 EHS: Joel Bendel


**Any previously dated CA diagram is revoked and/or invalid. Confirm this is the valid diagram for the site before beginning any construction.

Installation/grouting inspections may be scheduled the day before, or, the day of installation until 9am by contacting the Environmental Health office at 919 496 8100. A revisit fee may apply if installation is not ready for inspection at the time requested. Septic Operations Permits will be issued after installation is approved, all permits conditions are met, and any outstanding fees are paid. Well Certificate of Completion will be issued after well head approval, all permit conditions are met, and any outstanding fees are paid.

Septic Tank 1000 Pump Tank N/A Drainfield 3'x200' Type System ACC Max Trench Depth 17"

Septic Contractor _____ Septic/Pump tank dates _____ Pump fee? Yes ☒ No

Well Contractor _____ Well Grout date: _____

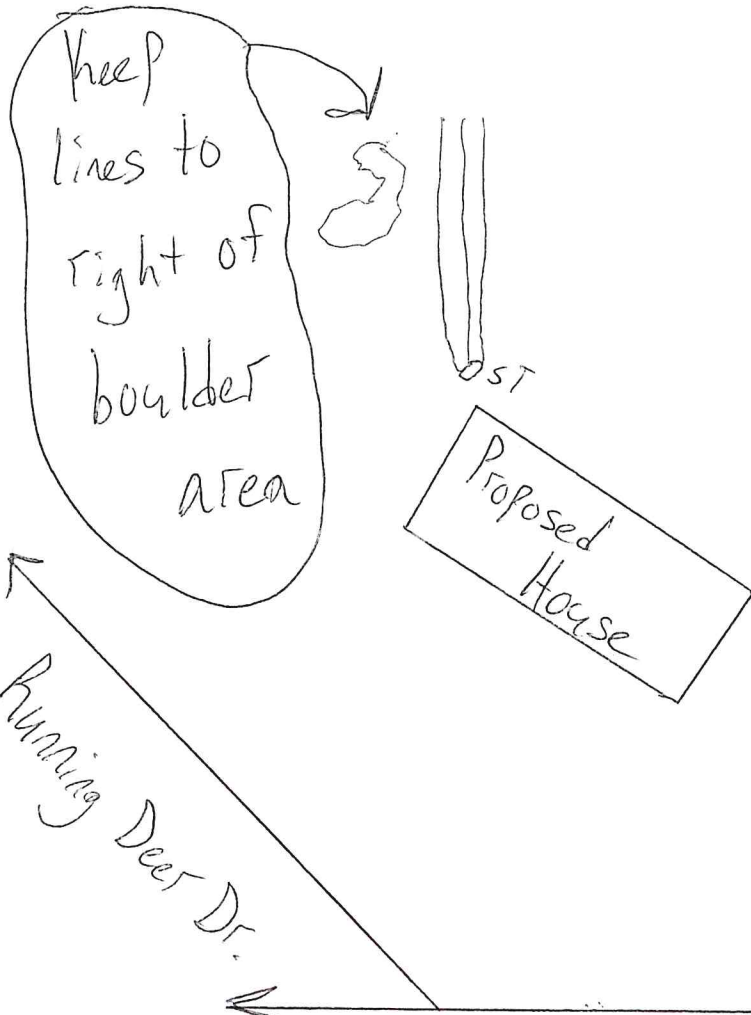

*Drawing not to scale
*Refer to plot plan also