

*File #: 324957 - 1
PIN #: 193000982272
Tax Lot #: 66
Tax Block #:

WELL CONSTRUCTION RECORD

Owner: Gresham Pointe, LLC
28 Hayes Ct

Franklinton, NC

Directions

Hwy 96 S, take a left on Fairport Rd, go 4 miles,
subdivision is on the left.

Drilling Contractor: Stephenson Well Drilling

Driller Registration:

Date Drilled: 04/13/2021

Use of Well: SINGLE FAMILY

Total Depth: Ft.

Static Water Level: Ft.

Replacement Well: NO

Yield: gpm

Water Zone: 1) Ft. 2) Ft.
3) Ft. 4) Ft.

Disinfection Type: GRANULAR Amount:

WELL HEAD CONSTRUCTION

Location:

Latitude:

Longitude:

Enclosure	☒ Yes	☐ No	☐ N/A
Enclosure Floor	☐ Yes	☒ No	☐ N/A
Access Port	☒ Yes	☐ No	☐ N/A
Vent:	☒ Yes	☐ No	☐ N/A
Sample Tap	☒ Yes	☐ No	☐ N/A
Back Flow	☐ Yes	☒ No	☐ N/A
Tee (jet)	☐ Yes	☒ No	☐ N/A
Suction Line	☐ Yes	☒ No	☐ N/A
Temporary	☐ Yes	☒ No	☐ N/A
Well ID Plate	☒ Yes	☐ No	☐ N/A
Pump ID Plate	☒ Yes	☐ No	☐ N/A
EHS:	Stiles, Bailey <i>Barney Stiles</i>		
Issue Date:	05/11/2021		

Casing: Depth: 106 Ft. Thickness: In. Comments:
Diameter: In. Top of Casing: 12 In.
Material: PVC SCH 40

Grout:

	Depth	Material	Method
From 0 To 20 Ft.	BENTONITE	POUR	
From 0 To Ft.	N/A	N/A	

* Liner Date: From 0 To Ft.

Grout:

	Depth	Material	Method
From 0 To Ft.	N/A	N/A	

Issued by: Stiles, Bailey

Date of Issue: 04/14/2021

WG done on 4/14/21 by WTB. Still drilling at
time of grout.

SEWAGE DISPOSAL SYSTEM INSTALLATION REVIEW

SEPTIC AND PUMP TANK INSPECTION

SEPTIC TANK

Manufacturer DB
 Date of Manufacture 2/10/20
 Stamp STB 502
 Capacity 1000
 Tee ✓
 Baffle ✓
 Sealant ✓
 AIR GAP ✓, FILTER ✓, RISER ✓

INITIAL

WTB
↓

DATE

4/22/21
↓

PUMP TANK

Manufacture Syntek
 Date of Manufacture "
 Stamp "
 Capacity "
 Sealant "
 Manhole "
 RISER ", SEALANT "

"
"
MECHANICAL INSPECTION

PUMP

Manufacturer and Model # "
 Control Panel "
 Alarm "
 Electrical Connection "
 SEALANT AROUND CONDUIT "

"
"
NITRIFICATION/DISTRIBUTION AND DRAINFIELD INSPECTION

DISTRIBUTION BOX

Level ✓
 Equal Distribution ✓
 Other "

WTB
↓

4/22/21
↓

DISTRIBUTION MANIFOLD

Pipe Size "
 Gate Valves "
 Other "

"
"
OTHER DISTRIBUTION

Type "

NITRIFICATION LINES

Trench Width 3'
 Trench Length 100'
 Trench Grade ✓
 Stone Depth 24"

LINE 1

3'
100'
✓
24"

LINE 2

3'
100'
✓
24"

LINE 3

3'
100'
✓
24"

LINE 4

3'
100'
✓
24"

LINE 5

"
"
"
"

LINE 6

"
"
"
"

R2 flow

WELL INSPECTION

LOCATION OF WELL In front left of house

WTB

4/22/21

COMMENTS:

N-G-R2/203 NGE0 (Gravity)

Granville – Vance District Health Department
Environmental Health

Pin _____

Permit Number CBPH

(5) 324955

Final Sketch

Greshampointelle

Applicants Name

Greshampointe 66

Subdivision – Section – Lot

Physical Address: 4579 Ashley View Ln.


Number of Bedrooms 4

Brantley & Sons

System Installer

4/22/21

Date

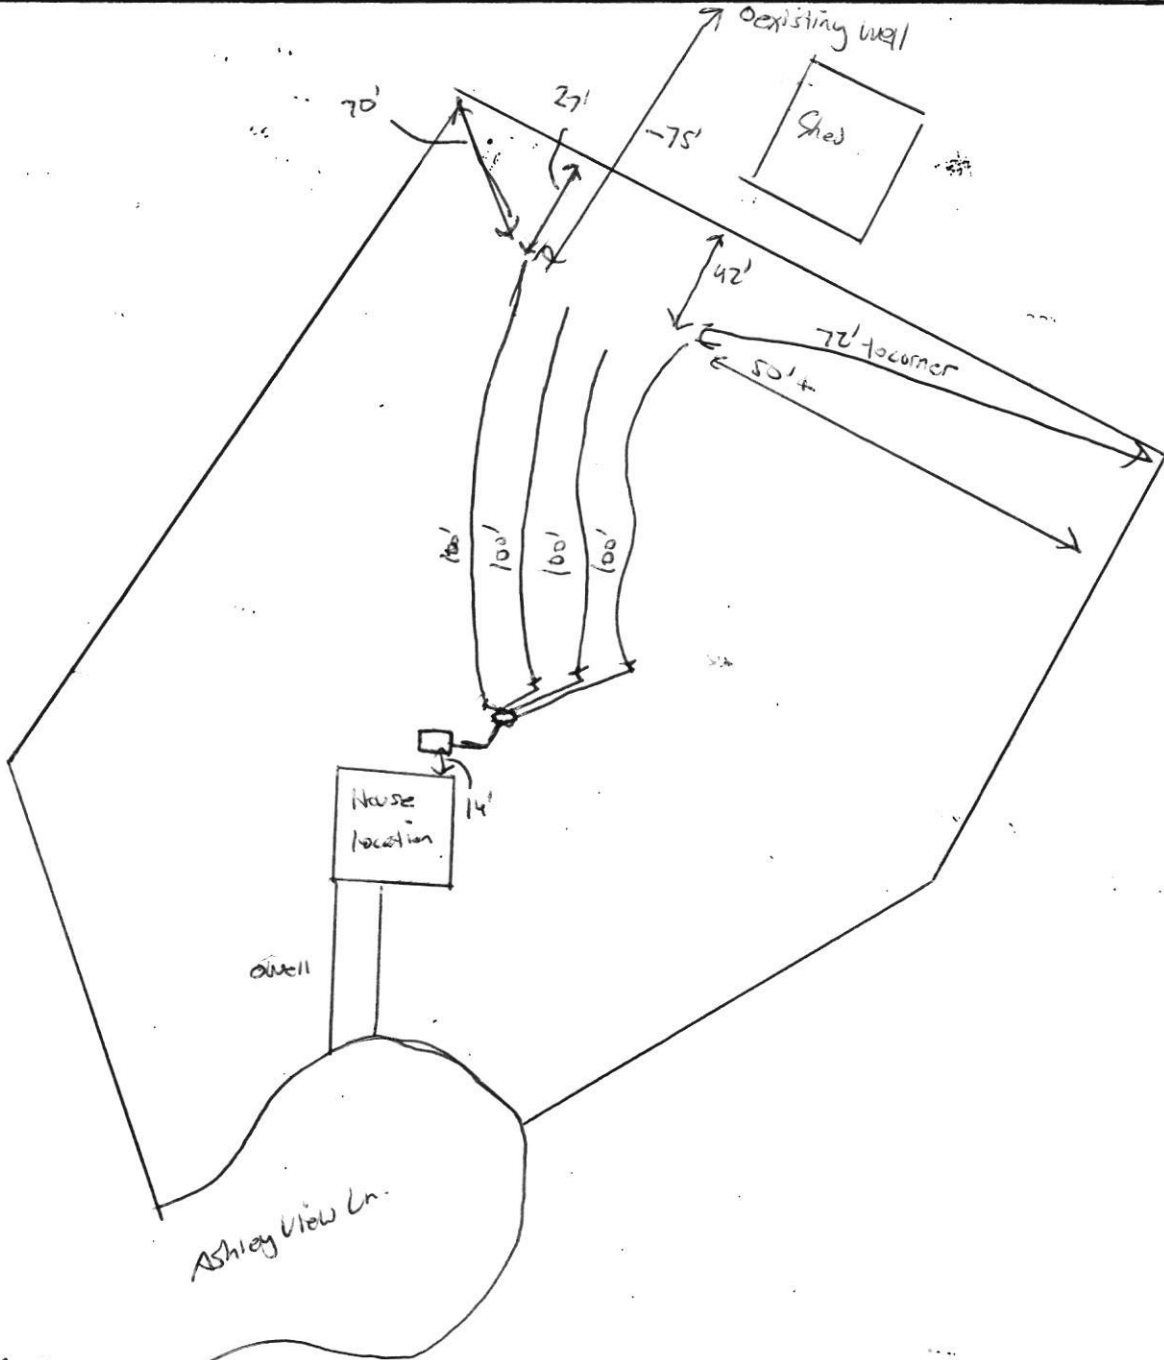

Mike

Authorized Signature

4/22/21

Date



OPERATION PERMIT

Granville County Health Dept
Environmental Health
101 Hunt Drive
Oxford, NC 27565
Phone: (252) 492-5263 Fax: (252) 492-2361

For Office Use Only

*CDP File Number 324955 - 1
County ID Number: 193000982272
Evaluated For: NEW

Property Owner: Gresham Pointe LLC

Address: 28 Hayes Ct

Road #:

City: Franklinton

State/Zip: NC/

Phone #: (919) 669-7570

Township:

Subdivision: Gresham Pointe

Phase: NEW

Lot: 66

Structure: SINGLE FAMILY

of Bedrooms: 4

of People: 8

Water Supply: NEW WELL

Saprolite System?: ☐ Yes ☒ No

Pump Required?: ☐ Yes ☒ No

Design Flow: 480

System Classification/Description: TYPE III G. OTHER
NON-CONV. TRENCH SYSTEMS

Installer: Brantley & Sons

Certification #: 1036

Specific System: EZFLOW EZ 1203H-GEO

Installed:

STB: 502

PT:

Septic Tank Date: 02/10/2020

Pump Tank Date: _____

Comments: Installed new 4 bedroom system. (4) 100' lines. EZ Flow

This system has been installed in compliance with applicable NC General Statutes, Rules for Sewage Treatment and Disposal, and all conditions of the Improvement Permit and Construction Authorization.

PERMIT CONDITIONS:

I. Performance: System shall perform in accordance with Rule .1961.

II. Monitoring: As required by Rule .1961.

III. Maintenance: Ground absorption sewage treatment and disposal systems shall be checked, and the contents of the septic tank removed, periodically from all compartments, to ensure proper operation of the system. The contents shall be pumped whenever the solids level is found to be more than 1/3 of the liquid depth in any compartment.

Other:

Subsurface Operator Required: ☐ Yes ☒ No

If yes, see attached sheet for additional operation conditions, maintenance and reporting.

Operation:

Other: Installed new 4 bedroom system. (4) 100' lines. EZ Flow

Authorized State Agent: Bullock, Will

Date of Issue: 04/22/2021

Owner/Applicant:

Gresham Pointe LLC