

mo. 7 Top 5 pages

919-578-0413

**Franklin County Health Department
Division of Environmental Health
107 Industrial Drive-Suite C
Louisburg, North Carolina 27549**

PAGE 1 OF 2

Phone: 919-496-8100

SEPTIC PERMIT

Fax: 919-496-8136

Permit Number: 4629 Type: I PIN: 2831-47-0893 Date: 8/25/2008

Applicant: CYNTHIA P SMITH Owner: CYNTHIA P SMITH
239 CROWDER RD 239 CROWDER RD
CASTALIA, NC 27816 CASTALIA, NC 27816

Telephone: (919) 853-6850 Telephone: (919) 853-6850

Subdivision: LAKE ROYALE Lot Number: 689C Size: 0.280

Physical Address/ Location /Directions 109 CREEK DR

Description: LifeTime _____ 5 Year X

TYPE FACIL Cover # EMPLOY 1 # BEDRMS 2 GPD 240 LTAR .46/1

TYPE WAT 10m TYPE SYS Pot TYPE REP N/A BSMT N BST FX N/A

SIZE TANK 1000 SIZE CHB 1000 SIZE NITR 3'x180' MTD 12'14"

COMMENTS 12" trench depth w/ 8" fill material to point
in to cover entire drain to wet area see design spec.
by CCSC

Septic Contractors are responsible for notifying the health department for final inspections, between 8:00-9:00 AM on the day of completion, Monday - Friday. Any request for final inspections received afterwards will be scheduled the same day, if possible, or the next workday. Have permit number and owner/applicant's name ready when making the call.

Actions of representatives of state or local agencies engaged in the evaluation and determination of measures required to effect the compliance with the provisions of this permit shall in no way be taken as a guarantee that wastewater disposal systems permitted and approved will function in a satisfactory manner for any given period of time, or that such employees assume any liability for damages, consequential or direct which are caused, or may be caused, by a malfunction of this wastewater treatment and disposal system.

Proper precautions must be taken to assure the proper functioning of the system after it has been covered. Do not run any heavy equipment over the system, as soft earth will allow damage to the tank and lines. Pipe all roof drains away from the septic system site to prevent flooding of the lines from surface water. Terrace the ground to prevent excessive drainage from higher areas adjacent to the system. Do not construct driveways over any part of the septic system unless proper provisions were made when the septic system was constructed. Only grass, not trees or shrubbery, should be cultivated over the lines. All plumbing fixtures should be carefully inspected periodically and any problems repaired immediately. All septic tanks should be pumped off by a permitted pump operator on a regular schedule, not to exceed every five years.

The improvement permit and construction authorization is a site approval, for the future installation of a wastewater treatment and disposal system. Changes in ownership of the site do not affect the validity of this permit. However, any alteration of the site or soil conditions, changes in the location of the proposed facility, changes to the wastewater flow and/or characteristics, or submittal of false information with the application or misrepresentation of the property lines may subject this permit to suspension or revocation.

FOR THIS TO BE A VALID CONSTRUCTION AUTHORIZATION, A LAYOUT SHEET MUST BE ATTACHED

IMPROVEMENT PERMIT

DATE 12/2/08 EHS [Signature]

CONSTRUCTION AUTHORIZATION

DATE 12/2/08 EHS [Signature]

Franklin County Health Department

Name: SMITH

Permit Number

4629

CONTRACTOR

Dan Beatty

TANK MANU

SI 7071000 5/11/07

MANU DATE

WELL INSTALLED

YES

NO


SYSTEM CODE

1000

SEPTIC SYSTEM LAYOUT

(SKETCH SYSTEM LAYOUT HERE)

See attached layout & Spec sheet by CSC.

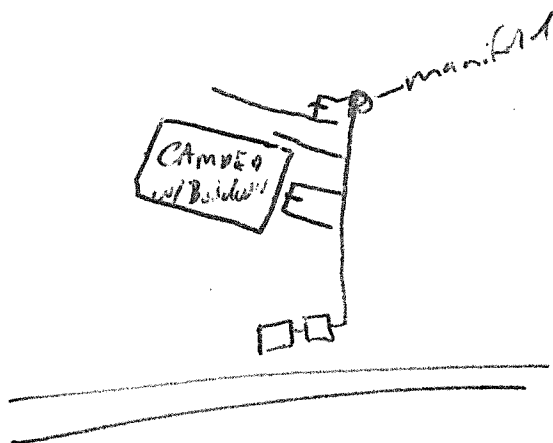

SEPTIC SYSTEM AS-BUILT

(IF DIFFERENT FROM INITIAL LAYOUT)

ON REVERSE


OPERATIONS PERMIT

DATE

6/25/09

EHS

Cynthia Smith Lake Royale - Creek Drive 2-Bedroom System Layout

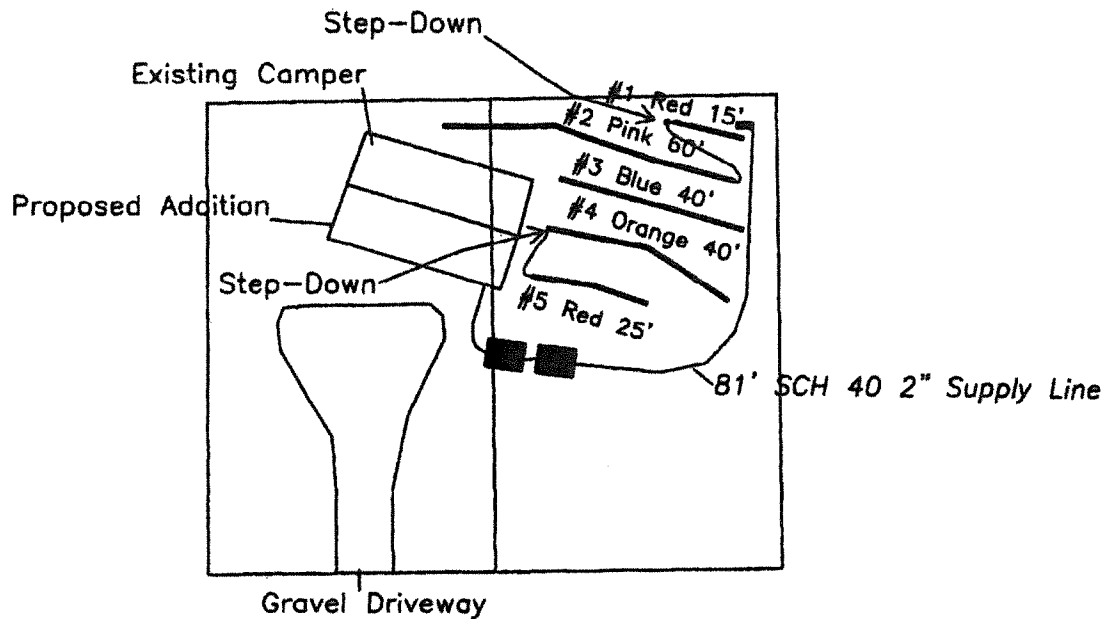

Depending on depth to bedrock
bedrock tank locations may
need to be altered.

System: Pressure Manifold
Lines: 1-5, (180')
0.4 LTAR
14" Trench Bottom
Accepted Status System

GRAPHIC SCALE

1" = 40'



Central Carolina
Soil Consulting
919-784-9449
Project # 691

***Cynthia Smith - Lake Royal
Creek Drive***

2-Bedroom System (240 gal./day)

<u>LINE #</u>	<u>COLOR</u>	<u>BS</u>	<u>HI</u>	<u>FS</u>	<u>ELEVATION</u>	<u>LINE LENGTH</u>	<u>Design Length</u>
TBM		0.8		100.0		<u>in field</u>	<u>installation</u>
INST. 1			100.8				
1	Red			2.4	98.4	17	15
2	Pink			3.2	97.6	60	60
3	Blue			4.0	96.8	42	40
4	Orange			4.9	95.9	40	40
5	Red			5.6	95.2	26	25
Total						185	180

<u>System</u>	<u>Repair</u>
Lines 1-4	Lot is Repair Exempt
System Type	Accepted Status System
	EZ-FLOW
Suggested Soil LTAR (gal/day/ft ²)	0.40
System Installation LTAR	0.33
Total Line Length	180
Square Footage	540
Proposed Trench Bottom	14"

Distribution Method Pressure Manifold

Notes: TBM is top of back corner eip.
Lines 1 and 2 along with shall use a step down


Sheet1

Lake Royal - Cynthia Smith Lot System, Tap Chart

Bench Mark	2.90	Is = 100.00 Location of BM						Elevation Head	13.60
Pump tank elev.	10	92.90	Pump elev.	87.90	Manifold elev.				101.50
line	color	rod read	Elevation	length	hole size	flow/tap	gal/day	trench area	LINE LTAR
1 & 2	Red/Pnk	2.40	100.50	75	3/4in SCH 80	10.1	106.83	225	0.4748
3	Blue	4.00	98.90	40	1/2in SCH 80	5.48	57.96	120	0.4830
4 & 5	Org/Red	4.90	98.00	65	1/2in SCH 40	7.11	75.20	195	0.3857

*Lines 1 & 2 along with 4 & 5 shall use step downs

	total	feet =	180	gal/min =	22.69	<u>LTAR =</u>	0.4000
						<u>LTAR + %5</u>	0.4200
% of Dose Vol.	90	<u>Des. Flow</u>	240			(ltar W/ INOV)	0.5333
Dose Volume	105.30	Pump Run=	10.56			(ltar W/ INOV + 5%)	0.5600
Dose Pump Time	4.64	Tank Gal/IN	21				
Drawdown in Inches	5.01						

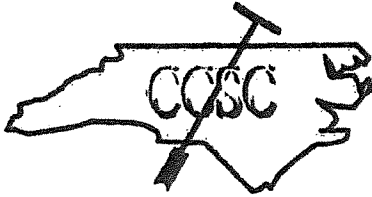**Central Carolina Soil Consulting, PLLC**

4024 Barrett Drive, Suite 201

Raleigh, NC 27609

Phone: 919-784-9449

Fax: 919-784-9079

Fax

To: Jeff Wood**From:** Jason Hall**Fax:** 496-8136**Pages:** 5**Phone:****Date:****Re:** Cynthia Smith Design**cc:**☐ **Urgent**☐ **For Review**☐ **Please Comment**☐ **Please Reply**

• Comments:

Profile Description
Cynthia Smith
Franklin County, NC

<u>Depth</u>	<u>Horizon</u>	<u>Texture</u>	<u>Color</u>	<u>Mottles</u>	<u>Structure</u>	<u>Moist Consistence</u>	<u>Wet Consistence</u>
0-14"	A	Sandy Loam	10 YR 4/2		Granular	Very Friable	Non-sticky
14-15"	E	Sandy Loam	10 YR 5/6		Granular	Very Friable	Non-plastic
15-29"	Bt1	Sandy Clay Loam	10 YR 5/8		SBK	Firm	Non-Sticky
29"+	Cr						Non-Plastic
							Slightly-Sticky
							Slightly-Plastic

**** Suggested Soil LTAR 0.4**

**** Restrictive soil characteristic (rock) located at 29 inches.**

**** Site is provisionally suitable for ultra-shallow conventional or LPP**



COUNTY OF FRANKLIN

ENVIRONMENT HEALTH APPLICATION (496-8100)

Permit #: 24441

Permit Type: SEPTIC PERMIT

Date Issued: 08/22/2008

Project Address: 109 CREEK DR, LOUISBURG NC 27549

Location: 109 CREEK DR

Size #: 0.280

Subdivision: LAKE ROYALE

Lot #: 689C &

Applicant: SMITH CYNTHIA P
239 CROWDER RD
CASTALIA NC 27816

Phone: 853.6850

Owner Name: SMITH CYNTHIA P

Phone:

Owners Address: 239 CROWDER RD

CASTALIA NC 27816

Tax record: 20738

Pin #: 2831-47-0893

Parcel #: LR0702 0689C

Zoned: A R

Setbacks Front: 30

Rear: 5

Side: 5

Proposed Use: BEDROOM,BATH,LR

of bedrooms: 1

of people:

Township: CYPRESS

Public Water/Sewer: TESI (LK ROY)

ST Road #:

Desc:

Fees Due: \$325.00

Date Paid: 08/22/2008

* Please complete all sections below*

☐ Yes ☒ No Does this site contain any previously identified jurisdictional wetlands?
☐ Yes ☒ No Is any wastewater, other than domestic, going to be generated?
☐ Yes ☒ No Is the site subject to approval by any other public agency?

*If the answer to any of the above is "yes", applicant must submit supporting documentation.

Please indicate desired system type(s). Systems can be ranked in order of preference.

☐ Conventional ☐ Accepted ☐ Modified Conventional ☐ Alternative
☐ Other ☒ No Preference

Call Environmental Health (919.496.8100) between 8:00 - 9:00 am Monday - Friday in order to schedule an appointment with an environmental health specialist for your lot evaluation. This application for an improvement permit/construction authorization and well permit does not constitute approval for zoning, septic or building permits. It will be necessary to meet all guidelines for zoning, septic and building permits prior to construction. The permit is valid for either 60 months or without expiration, depending upon documentation submitted. (complete site plan= 60 months--complete surveyed plat=without expiration.)

I hereby certify that I am the owner, or authorized by the owner to act as his/her legal representation. Furthermore, as legal representative (if applicable) I have advised the owner of my intention to apply for this wastewater treatment and disposal system and drinking water and well system permit.

I also certify that all of the statements made in this application and any attached documents are true, complete, and correct, to the best of my knowledge and belief, and are made in good faith. If information in this application for these improvements is falsified, changed or site is altered, then improvement permits and authorization to construct these improvements shall become invalid. Authorized county representatives are granted right of entry to make these evaluations or inspections, and to release information upon public request.

X Ernesto Fernandez
Print & Signature of Owner or Owner's Legal Representative

08/22/2008

Franklin County DRC Permit RESIDENTIAL



Zoning Permit #: 14078

ADDRESS: 109 CREEK DR

PARCEL NO.: 2831-47-0893

ZONING: A R

SUBDIVISION: LAKE ROYALE

LOT: 689C &

ISSUED TO: SMITH CYNTHIA P
239 CROWDER RD
CASTALIA NC 27816

PHONE NUMBER: 853-6850

SETBACK: FRONT: 30 RIGHT: 5 LEFT: 5 REAR: 5

COUNTY WATER: TESI FLOODPLAIN: N/A MISC FEE:

PERMIT TYPE: ZONING PERMIT

TYPE OF CONSTRUCTION: ADDITION & ROOF OVER CAMPER

PERMIT DATE: 08/22/2008

WATERSHED N/A

TOWNSHIP CYP

EXPIRE DATE: 02/22/2009

It is hereby certified that the above use as shown on the plats and plans submitted with this application conforms with all applicable provisions of the Franklin County Zoning Ordinance. The issuance of this application does not allow the violation of Franklin County Zoning Ordinance or other governing regulations. The applicant is responsible for obtaining a building permit (if required) prior to commencing work on the proposed improvement. A final zoning inspection must be scheduled by the applicant.

NOTES:

I hereby certify that all information I have provided to the Planning Department is true and accurate.

APPLICANTS SIGNATURE:

UTILITY COMPANY: PROGRESS ENERGY WAKE ELECTRIC OTHER

NUMBER OF STORIES: 1 _____ 1 1/2 _____ 2 _____ 2 1/2 _____

SQUARE FOOTAGE: HEATED _____ UNHEATED _____ TOTAL _____

BASEMENT: YES _____ NO _____

FIREPLACE: NO _____ MASONARY _____ MANUFACTURED _____

PLAN SETS: MODULAR _____ STICKBUILT _____

NAME OF:

ELECTRICIAN: _____

MECHANICAL: _____

PLUMBING: _____

COST OF CONSTRUCTION: _____

NO MORE THAN 2 STRUCTURAL DEVIATIONS OR PLANS MUST BE REDRAWN

DEPARTMENTAL USE ONLY

	INITIALS (IN)	DATE	INITIALS (OUT)	DATE
ZONING	TWD	8/22/08		
INITIAL PERMITTING				
ADDRESSING				
PLAN REVIEW				
FIRE REVIEW				
SEPTIC/SEWER				
FINAL PERMITTING				