

Profile

Sales

Residential

Commercial

OBY

Values

Commercial Apartment

Commercial Use

Sketch

Map

Photos

PARCEL ID: 017952

January 1 Owner(s): JACOBS GERALDINE

January 1 Owner(s):

Tax Year: 2024

1 of 1

Parcel

PIN	2814-68-7927
Physical Address	13 ALTON DR
Unit	
City	LOUISBURG
Zip Code	27549-
Neighborhood	I07A0B
Class	Dwelling
Land Use Code	Single Family
Acres	.83
Land Type	U
Frontage Width and Depth	--
Zoning	FCO AR
Street1/Street2	Unpaved /
Topo1/Topo2/Topo3	Level / Rolling /
Util1/Util2/Util3	Well/Septic/Electric
Restrict1/Restrict2/Restrict3	//

Legal

Sub Name	ALSTON ACRES B PT
Lot No.	45
Township	Louisburg
Tax Jurisdiction	CNLF
Plat Book/Page	/
Deed Book/Page	1828 / 236

Current Owner Details

Owner 1	JACOBS GERALDINE
Owner 2	
In Care Of	
Mailing Address	45 SECLUSION DR
City/State/Zip	LOUISBURG/NC/27549
Solid Waste Fee	1

Actions

 Printable Summary Printable Version

Reports


Property Report Card ▲

Go

FRANKLIN COUNTY HEALTH DEPARTMENT

PERMIT NUMBER: 42341	IMPROVEMENTS PERMIT	DATE: 08.31.92	17952	SIZE:
APPLICANT: TAYLOR LOIS RT 5 BOX 28 LOUISBURG NC 27549 TELEPHONE: 496-4210			OWNER: TAYLOR LOIS RT 5 BOX 28 LOUISBURG NC 27549	
COMMENT: SFD			CONTRACTOR:	
LOCATION / DIRECTIONS: ALSTON ACRES 45 B				
FEE: 50.00			SIGNATURE OF OWNER OR AUTHORIZED AGENT:	
24866				

THE ABOVE SIGNATURE INDICATES THAT I HAVE READ, UNDERSTAND, AND AGREE WITH ALL PROVISIONS AND INFORMATION AS OUTLINED ON THE
BACK SIDE OF THIS FORM

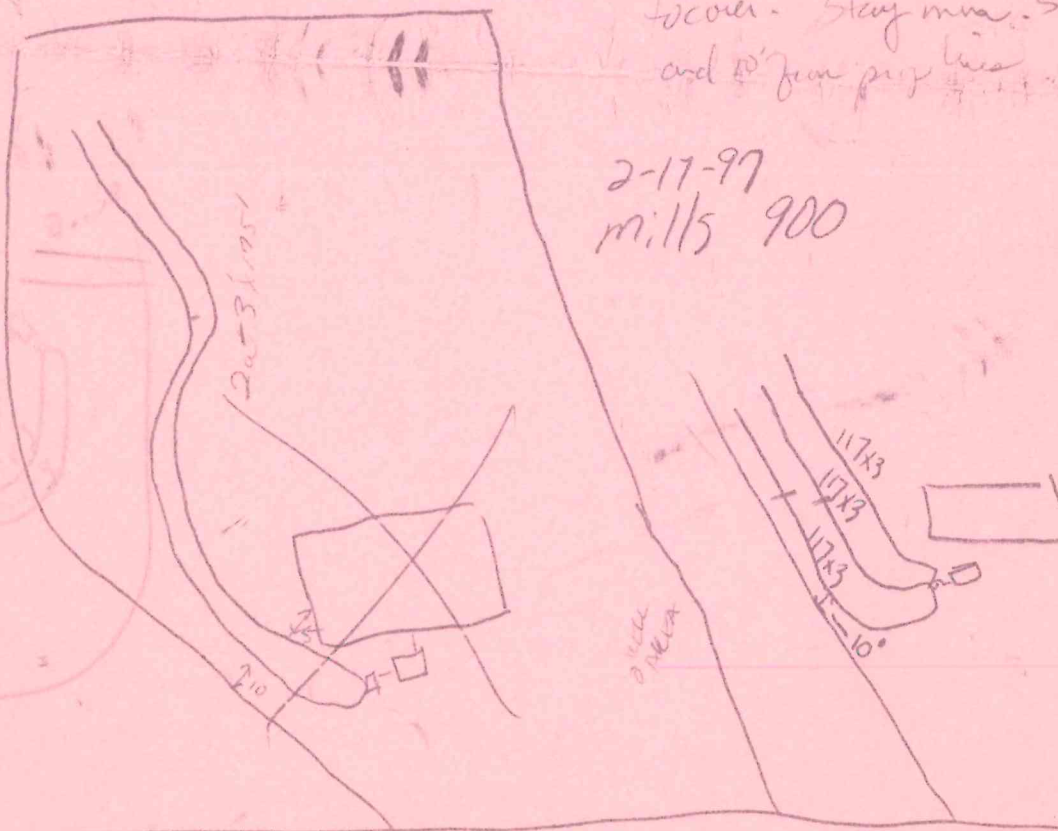

DATE ISSUED 9-29-92

EH SPECIALIST

DATE APPROVED 4/21/97

EH SPECIALIST

PROPERTY DESCRIPTION

 APPLICATION FOR —
 (NOT A PERMIT)

☒ Improvements
 Permit

☐ Zoning
 Permit

☐ Electrical
 Permit

☐ Other

4234I

 REC. # 17952 Proposed Use: SFR

 Attach site plan showing property lines, location of proposed structures
 (including driveways, patios, decks, etc.) and any existing structure.

Owner as on tax records		Mailing Address		Telephone No.	
Applicant <u>Lain Taylor</u>		Mailing Address <u>Rt 5, Box 28, Phg</u>		Telephone No. <u>496-4210</u>	
Tax Map No. <u>F07A0B</u>	Parcel No. <u>0454</u>	Township <u>Lbg</u>	Jurisdiction <u>FC</u>		Zoning <u>A/R</u>
Subdivision <u>Walter Acres</u>		Lot No. <u>B</u>	Section No. <u>W 45</u>	Lot Size <u>1600</u>	Road No. <u>1600</u>
Flood Plain ☐ Yes ☐ No					
Approx. Area to be disturbed		Engineering Firm	Contact	Phone	Street address

Land use indicated (is) (is not) permitted in the zoning district. If permitted, the following minimum zoning requirements must be met, unless the Health Department requires more land area or other qualifications are indicated in the remarks. Franklin County Zoning Ordinance does not supercede any restrictive covenants placed on this property.

Lot area _____ square feet	Front yard depth <u>30</u> ft.	Corner yard depth _____ ft.	Aggregate both sides _____
Lot width _____ feet	Side yard depth <u>10</u> ft.	Rear yard depth <u>25</u> ft.	

Remarks: _____

 Permit No. _____ Planning & Community Development Ln
 Processed by

8/31/92
 Date

Required Information for IMPROVEMENTS PERMIT (Health Department)

Type of Facility (check one and complete) —

☒ Single family dwelling		No. of bedrooms <u>3</u>	No. of bathrooms <u>2</u>
☐ Mobile home		No. of bedrooms _____	No. of bathrooms _____
☐ Multi-family dwelling		No. of units _____	No. of bedrooms per unit _____
☐ Business	Wastewater ☒ Domestic ☐ Industrial		
☐ Other (Specify)			
☐ Existing structure	☐ Renovate	☐ Addition	Estimated Daily Waste Flow gal/day <u>360</u>
Garbage Disposal Unit to be Installed ☐ Yes ☒ No		Dishwasher ☒ Yes ☐ No	Washer ☒ Yes ☐ No
Water Supply Source ☒ Private ☐ Public		☐ Private off-site	
Comment <u>LONG TERM ACCEPTANCE RATE = .35</u> <u>LAYOUT C/M H. GAIL. ETD, IN</u>			

Sanitarian Chris Kaleb

Date

Permit #

I certify that all of the statements made in this application and any attached documents are true, complete and correct to the best of my knowledge and belief and are made in good faith. I understand that false information may be grounds for rejection of this application. Authorized County Representatives are granted right of entry to make evaluations or inspections and to release information upon public request.

Lain Taylor
 Signature of Owner or Authorized Agent

8/31/92
 Date