

J. McLean

919-497-0277

**Franklin County Health Department**  
**Division of Environmental Health**  
**107 Industrial Drive-Suite C**  
**Louisburg, North Carolina 27549**

PAGE 1 OF 2 *McLean*

*(M)* Fred Edmonds  
 8305 Shane Edmonds

*mechanicsville Va*  
 Fax: 919-496-8136 *2311*

Phone: 919-496-8100

**SEPTIC PERMIT**

Permit Number: 5202 Type: E PIN: 2830-73-9243 Date: 11/2/2009  
 Applicant: PINERIDGE CONSTRUCTION INC Owner: NORWOOD & MARGARET WILLIAMS  
 140 MAIN ST 4421 OLD US 64 HWY  
 BUNN, NC 27508 ZEBULON, NC 27597  
 Telephone: (252) 469-9873 Telephone:  
 Subdivision: LAKE ROYALE Lot Number: 1528 Size: 1.000

Physical Address/ Location /Directions 721 SAGAMORE DR

Description: LifeTime \_\_\_\_\_ 5 Year X

TYPE FACIL SFD # EMPLOY 1 # BEDRMS 3 GPD 360 LTAR 49/d  
 TYPE WAT Com TYPE SYS Plat TYPE REP N/A BSMT N BST FX N/A  
 SIZE TANK 1000 SIZE CHB 1000 SIZE NITR 3x225 MTD 30"

COMMENTS: \* House size limited to 3 BDR  
\* Pump to "D" box

Septic Contractors are responsible for notifying the health department for final inspections, between 8:00-9:00 AM on the day of completion, Monday - Friday. Any request for final inspections received afterwards will be scheduled the same day, if possible, or the next workday. Have permit number and owner/applicant's name ready when making the call.

Actions of representatives of state or local agencies engaged in the evaluation and determination of measures required to effect the compliance with the provisions of this permit shall in no way be taken as a guarantee that wastewater disposal systems permitted and approved will function in a satisfactory manner for any given period of time, or that such employees assume any liability for damages, consequential or direct which are caused, or may be caused, by a malfunction of this wastewater treatment and disposal system.

Proper precautions must be taken to assure the proper functioning of the system after it has been covered. Do not run any heavy equipment over the system, as soft earth will allow damage to the tank and lines. Pipe all roof drains away from the septic system site to prevent flooding of the lines from surface water. Terrace the ground to prevent excessive drainage from higher areas adjacent to the system. Do not construct driveways over any part of the septic system unless proper provisions were made when the septic system was constructed. Only grass, not trees or shrubbery, should be cultivated over the lines. All plumbing fixtures should be carefully inspected periodically and any problems repaired immediately. All septic tanks should be pumped off by a permitted pump operator on a regular schedule, not to exceed every five years.

The improvement permit and construction authorization is a site approval, for the future installation of a wastewater treatment and disposal system. Changes in ownership of the site do not affect the validity of this permit. However, any alteration of the site or soil conditions, changes in the location of the proposed facility, changes to the wastewater flow and/or characteristics, or submittal of false information with the application or misrepresentation of the property lines may subject this permit to suspension or revocation.

FOR THIS TO BE A VALID CONSTRUCTION AUTHORIZATION, A LAYOUT SHEET MUST BE ATTACHED

IMPROVEMENT PERMIT DATE 11/10/09 EHS [Signature]CONSTRUCTION AUTHORIZATION DATE 11/10/09 EHS [Signature]Visit [www.franklincountyenvironmentalhealth.com](http://www.franklincountyenvironmentalhealth.com) for permit information and tracking.

*TR Shance*  
*McLean*  
*next lot*  
*one on*  
*sagamore*

## Franklin County Health Department

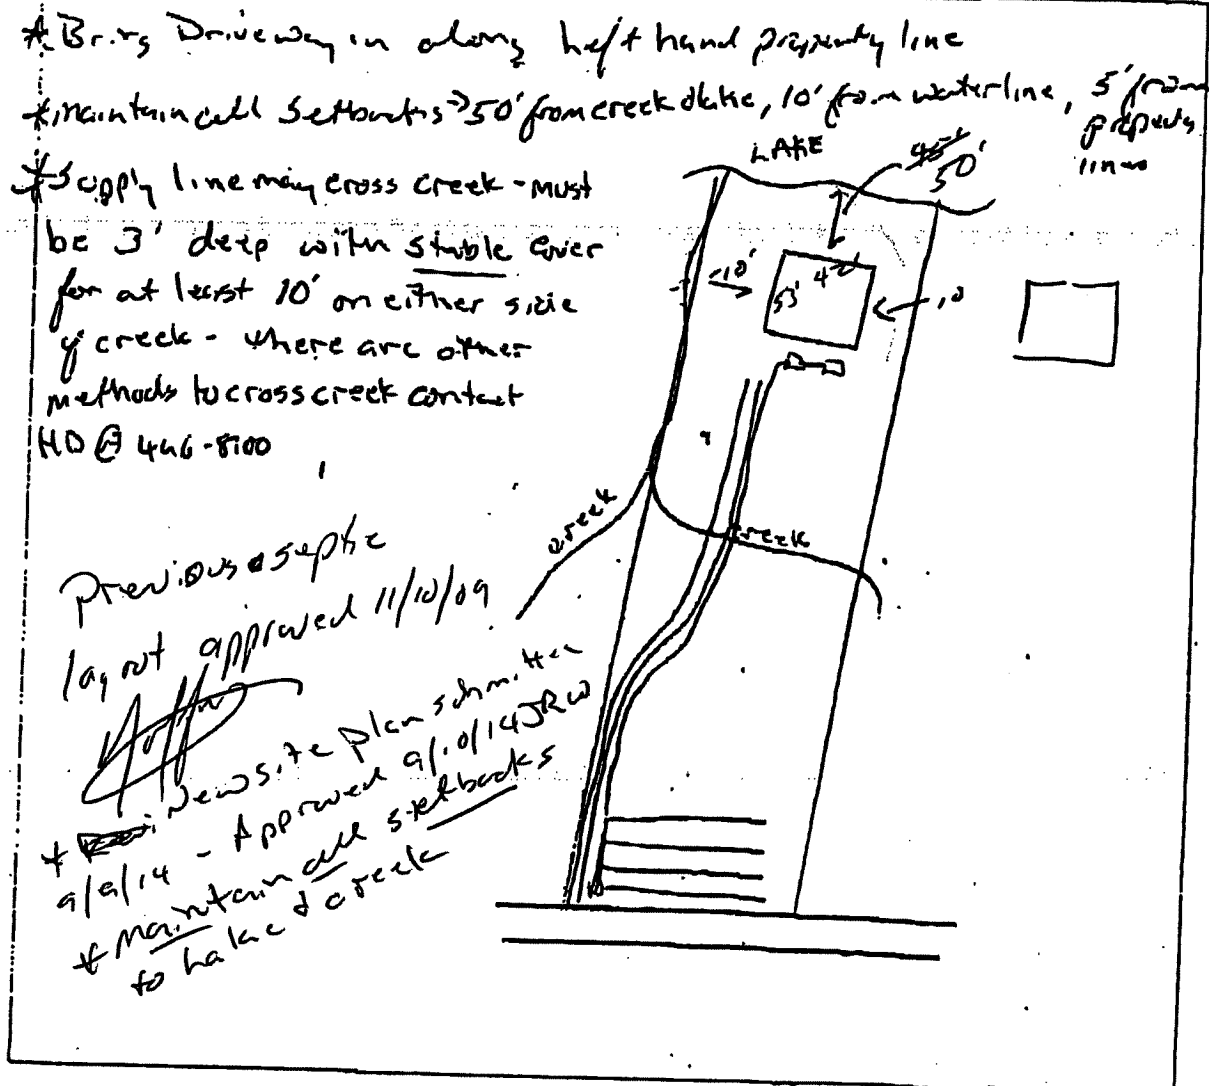
Name: WILLIAMS

Permit Number

952

CONTRACTOR \_\_\_\_\_ TANK MANU \_\_\_\_\_ MANU DATE \_\_\_\_\_

WELL INSTALLED AT TIME OF INSPECTION YES \_\_\_\_\_ NO \_\_\_\_\_

SEPTIC SYSTEM LAYOUT  
(SKETCH SYSTEM LAYOUT HERE)SEPTIC SYSTEM AS-BUILT  
(IF DIFFERENT FROM INITIAL LAYOUT)  
ON REVERSE

septic pump fee \_\_\_\_\_

OPERATIONS PERMIT

DATE \_\_\_\_\_ EHS \_\_\_\_\_