

FRANKLIN COUNTY HEALTH DEPARTMENT

PERMIT NUMBER: 17849C CONST IMPROVE PERMIT	DATE: 20031110	2708-14-2395	SIZE: 42,100
APPLICANT: YOUNG HUGH LEE SR & LINDA 50 FURNEY PEARCE RD ZEBULON NC 27597		OWNER: YOUNG HUGH LEE SR	
TELEPHONE: 269-5058			
COMMENT: DW		DESCRIPTION: 5 YEAR ☒	LIFETIME: ☐
LOCATION / DIRECTIONS: 389 HENRY BAKER RD # 1			
FEE: 225.00		SIGNATURE OR OWNER OR AUTHORIZED AGENT:	

THE ABOVE SIGNATURE INDICATES THAT I HAVE READ, UNDERSTAND, AND AGREE WITH ALL PROVISIONS AND INFORMATION AS OUTLINED ON THE BACK SIDE OF THIS FORM

TOPO <u>PS</u>	TEXTURE <u>PS</u>	STRUCTURE <u>PS</u>	DEPTH <u>PS</u>
R. HOR <u>6</u>	SOIL. WET <u>1</u>	AVAIL. SP <u>65%</u>	OTHER <u>1</u>
MINRL <u>415</u>	OVERALL <u>PS</u>	LTAR <u>35%</u>	
#BEDRMS <u>3</u>	GPD <u>300</u>	DISPOSAL <u>1</u>	TYPE. SYS <u>C</u>
SZ. TANK <u>900</u>	SZ. CHAMB <u>1</u>	NITRIFI <u>7550</u>	TYPE. WAT <u>1</u>
SITE. LOC <u>1</u>	MAX TRENCH DEP <u>30'</u>	TYP. FAC <u>SFD</u>	

REMARKS:

Stay 10' from property lines, 5' from building foundation and 100' from wells.


CONTRACTOR: B71 Johnson

TANK MANUF: DB/600

MANUF DATE: 8/7/03

*House already
served by
sewer
system*

*Infiltrator
system
42 panels*

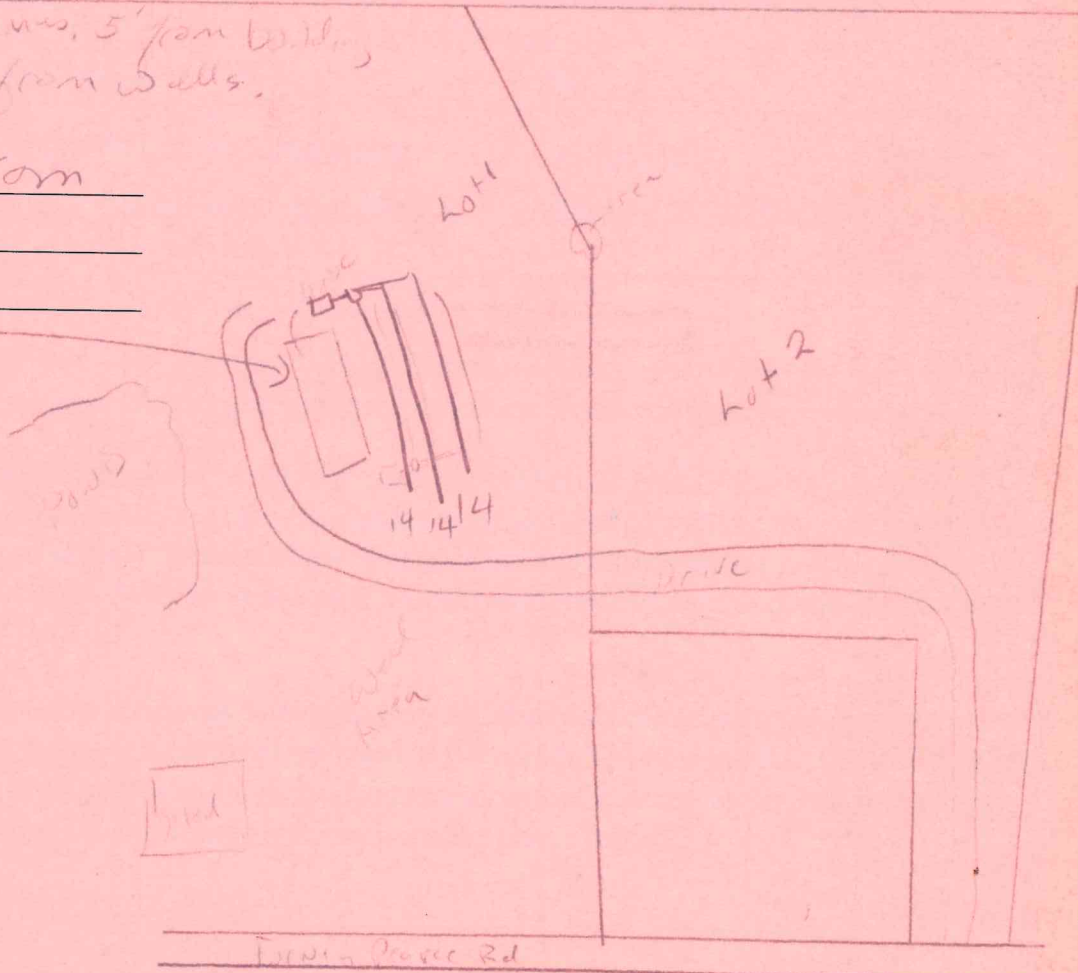

IMPROVEMENT PERMIT DATE: 11/3/03

CONSTRUCTION AUTHORIZATION DATE: 11/3/03

OPERATION PERMIT DATE: 12/3/03

ENV HEALTH SPEC: [Signature]

ENV HEALTH SPEC: [Signature]

ENV HEALTH SPEC: [Signature]