



Repair

File#

PIN#

Property Address: 202 Cardinal Dr.

Applicant Or Owner Name: David Foster

Environmental Health Septic/Well Permit Diagram

BPT
4' x 75' over top old grave
4' ctr

Building permits cannot be issued nor should construction begin without Construction Authorization issuance.

☒ Septic Improvement Permit ☒ Septic Construction Authorization (CA) ☐ CA Reissue** ☐ As Built
☐ Well Construction Authorization ☐ Additional Diagram/Specifications Attached

Diagram Date**: 8-12-24 EHS: Sullivan

**Any previously dated CA diagram is revoked and/or invalid. Confirm this is the valid diagram for the site before beginning any construction.

Revised 8-20-2024

Installation inspections may be scheduled the day before or the day of installation by 9am. Contact the Environmental Health office at 919 496-8100. A revisit fee may apply if installation is not ready for inspection at the time requested.

SEPTIC OPERATIONS PERMITS will be issued after installation is approved, all permit conditions are met, and any outstanding fees are paid. WELL CERTIFICATE OF COMPLETION will be issued after well head approval, all permit conditions are met, and any outstanding fees are paid.

Septic Tank new 1000 Pump Tank na Drain field 3' x 300' + Type System Accepted Max trench depth 30"

Septic Contractor Harris LLC Septic/Pump tank dates 3 lines @ 60', 2 wrapped @ 60'

Well Contractor _____ Well Head Date: _____ PUMP FEE PAID _____ N/A (CIRCLE)

Bedrooms: 3


If Repair ☒

Acreage: 2.13

Parcel ID: 004454

1975 Home

*Drawing not to scale (if large acreage, may be portion)
(If not as built, indicate changes on front or back of sheet.)

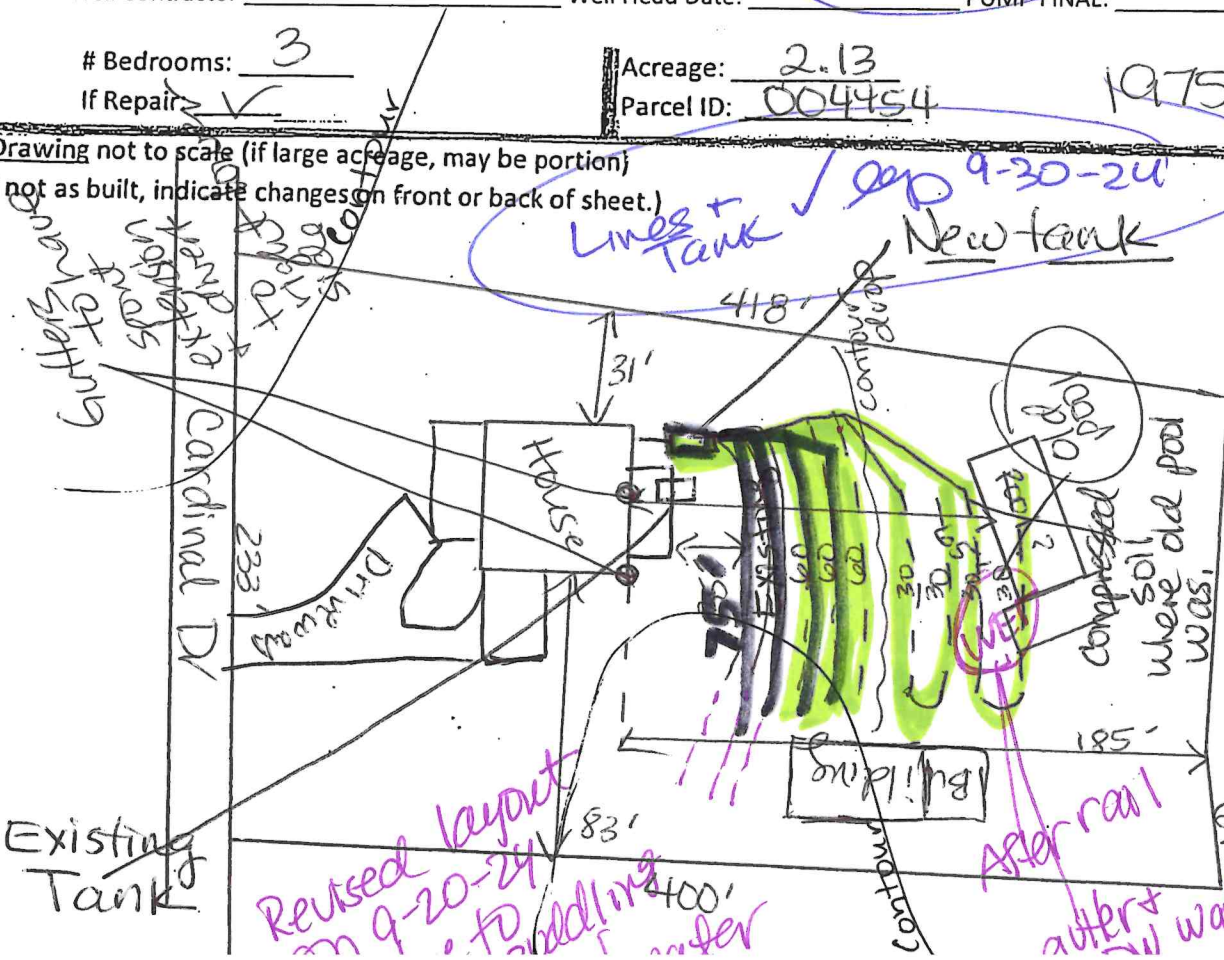

① Locate Lines ✓
② Camera + determine condition May be roots at start of lines + effluent not making it into lines.
Did not

Lori G. Jones

From: Wesley harris <waharrisllc@gmail.com>
Sent: Friday, October 4, 2024 9:14 AM
To: Lori G. Jones
Subject: 202 Cardinal
Attachments: IMG_2684.jpg

Large grey square-im1060 infiltrator tank/polylok pl68 filter- 6 feet from deck corner

Small grey square- 6 hole concrete d box- 22 feet from tank. Schedule 40 4 inch pvc feeding into box

Red lines- 4 75 ft infiltrator ezflow drain lines 30 inch max trench depth. 3rd line 5ft from pool house building.

3 inch schedule 40 feeding drain lines



004270

189

004455

406

3' X 75'
3' X 75'
3' X 75'
3' X 75'

004454

202

478

