

Beard Const Fax - 252-443-4400 49

Dylana.hinson
@allentake.com

PAGE 1 OF 2

**Franklin County Health Department
Environmental Health Section
107 Industrial Drive-Suite C
Louisburg, North Carolina 27549**

Phone: 919-496-8100

Fax: 919-496-8136

Permit Number: 1343 Type: I PIN : 2831-34-9542 Date: 4/1/2005
Applicant: BEARHARP PROPERTIES Owner: MAXINE BROWN
1344 S OLD CARRIAGE RD 12030 SPRINGDALE LAKE D
ROCKY MOUNT, NC 27884 CINCINNATI, OH 45246
Telephone: (252) 883-9551 Telephone:
Subdivision: LAKE ROYALE Lot Number: 533 Size: 1

Physical Address/ Location /Directions STALLION DR & SAGAMORE DR

Description: LifeTime _____ 5 Year X

TYPE FACIL Res # EMPLOY 1 # BEDRMS 2 GPD 240 LTAR .359%
TYPE WAT Pom TYPE SYS Innov or LDR TYPE REP Innov/LDR BSMT N BST FX N/A
SIZE TANK 900 SIZE CHB 1 SIZE NITR 3X175 MTD 36"

COMMENTS 3X175' Innovative system or 10' x 275' LDR
~~5000' 5000' 5000'~~

Septic Contractors are responsible for notifying the health department for final inspections, between 8:00-9:00 AM on the day of completion, Monday - Friday. Any request for final inspections received afterwards will be scheduled the same day, if possible, or the next workday. Have permit number and owner/applicant's name ready when making the call.

Actions of representatives of state or local agencies engaged in the evaluation and determination of measures required to effect the compliance with the provisions of this permit shall in no way be taken as a guarantee that wastewater disposal systems permitted and approved will function in a satisfactory manner for any given period of time, or that such employees assume any liability for damages, consequential or direct which are caused, or may be caused, by a malfunction of this wastewater treatment and disposal system.

Proper precautions must be taken to assure the proper functioning of the system after it has been covered. Do not run any heavy equipment over the system, as soft earth will allow damage to the tank and lines. Pipe all roof drains away from the septic system site to prevent flooding of the lines from surface water. Terrace the ground to prevent excessive drainage from higher areas adjacent to the system. Do not construct driveways over any part of the septic system unless proper provisions were made when the septic system was constructed. Only grass, not trees or shrubbery, should be cultivated over the lines. All plumbing fixtures should be carefully inspected periodically and any problems repaired immediately. All septic tanks should be pumped off by a permitted pump operator on a regular schedule, not to exceed every five years.

The improvement permit and construction authorization is a site approval, for the future installation of a wastewater treatment and disposal system. Changes in ownership of the site do not affect the validity of this permit. However, any alteration of the site or soil conditions, changes in the location of the proposed facility, changes to the wastewater flow and/or characteristics, or submittal of false information with the application or misrepresentation of the property lines may subject this permit to suspension or revocation.

FOR THIS TO BE A VALID CONSTRUCTION AUTHORIZATION, A LAYOUT SHEET MUST BE ATTACHED

IMPROVEMENT PERMIT

DATE

5/19/05

EHS

CONSTRUCTION AUTHORIZATION

DATE

5/19/05

EHS

Franklin County Health Department

Name: BEARHARP PROPE

Permit Number


1343

CONTRACTOR Shirley Flora TANK MANU Mills 1000 MANU DATE 6/14/05

WELL INSTALLED AT TIME OF INSPECTION YES _____ NO _____

SEPTIC SYSTEM LAYOUT (SKETCH SYSTEM LAYOUT HERE)

Suggest using 10" LDP due to steep slope & maximum trench depth requirement

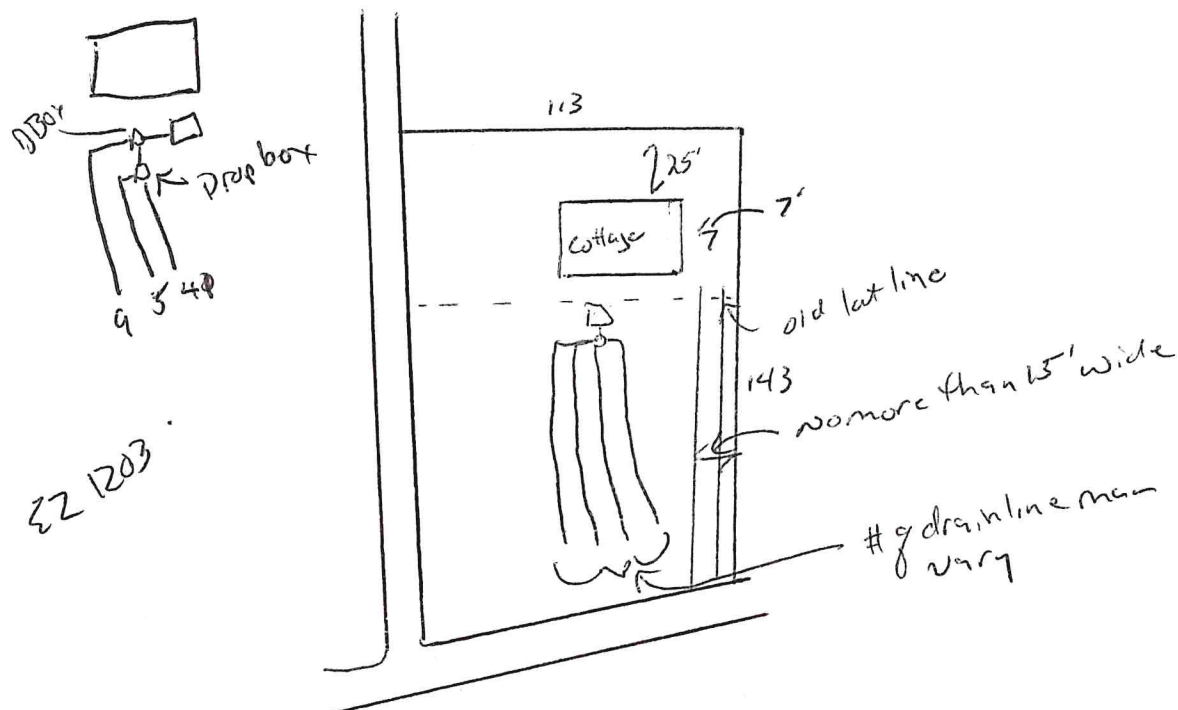

SEPTIC SYSTEM AS-BUILT

(IF DIFFERENT FROM INITIAL LAYOUT)

ON REVERSE

OPERATIONS PERMIT

DATE

10/19/05

EHS