

**IMPROVEMENT PERMIT**

Franklin County Health Department
107 Industrial Drive
Louisburg, NC 27549
Phone: _____

For Office Use Only

*CDP File Number 376907 - 1
County ID Number: _____
Evaluated For: NEW

PERMIT VALID UNTIL: 06/20/2027

***NOTE TO INSPECTIONS DIVISION:** Building Permits cannot be issued with this Improvement Permit.

Applicant: MARK DOWDY
Address: 4912 HERMITAGE DR
City: RALEIGH
State/Zip: NC 27612
Phone #: _____

Property Owner: SHANNON HOMES DESIGN BUILD LLC
Address: 4912 HERMITAGE DR
City: RALEIGH
State/Zip: NC. 27612
Phone #: _____

Property Location & Site Information

Address/Road #: 30 CICIADA DR, NC Subdivision: _____ Phase: NEW Lot: 2

Directions

Structure: SINGLE FAMILY
of Bedrooms: 4
of People: 6
*Water Supply: NEW WELL

System Specifications**Initial System**

*Site Classification: Provisionally Suitable
Design Flow: 480
Soil Application Rate: 0.3000

Minimum Trench Depth: _____ Inches
Maximum Trench Depth: 28 Inches

*System Classification/Description:
TYPE II A. CONV SYSTEM (SINGLE-FAMILY OR 480 GPD OR LESS)
*Proposed System:
25% REDUCTION

Septic Tank: 1000 Gallons
Pump Required: ☐ Yes ☐ No ☒ May Be Required
Pump Tank: _____ Gallons

Repair System Required: ☒ Yes ☐ No ☐ No, but has Available Space**Repair System**

*Site Classification: Provisionally Suitable
Soil Application Rate: 0.300
*System Classification/Description:
TYPE II A. CONV SYSTEM (SINGLE-FAMILY OR 480 GPD OR LESS)
*Proposed System:
25% REDUCTION

Minimum Trench Depth: _____ Inches
Maximum Trench Depth: 28 Inches
Pump Required: ☐ Yes ☐ No ☒ May Be Required
Pump Tank: _____ Gallons

No grading or construction activity is allowed in areas designated for system and repair without approval of Health Department

***Site Modifications**

The issuance of this permit by the Health Department in no way guarantees the issuance of other permits. The permit holder is responsible for checking with appropriate governing bodies in meeting their requirements.

***Permit Conditions**

There is an area of land here, identified on the site sketch, where a prior home resided. This area is to not be used for leach lines, due to soil compression.

The Department and Local Health Department may impose conditions on the issuance and may revoke the permits for failure of the system to satisfy the conditions, the rules, or this article. This permit is subject to revocation if the site plan, plat, or intended use changes (NCGS 130A-335(f)). The person owning or controlling the system location, installing, operation, maintenance, monitoring, reporting, and repair (1938(b)).

Authorized State Agent: Jones, Lori Date of Issue: 06/20/2022

Total Time: (HH:MM)



Hand Drawing



Import Drawing

****Site Plan/Drawing attached.****



Construction Authorization

Franklin County Health Department
107 Industrial Drive
Louisburg, NC 27549
Phone: _____

For Office Use Only

*CDP File Number: 376907 - 1

County ID Number: _____

Evaluated For: NEW

PERMIT VALID UNTIL: 06/20/2027

☐ Open Pump System Sheet

Applicant: MARK DOWDY
Address: 4912 HERMITAGE DR
City: RALEIGH
State/Zip: NC 27612
Phone #: _____

Property Owner: SHANNON HOMES DESIGN BUILD LLC
Address: 4912 HERMITAGE DR
City: RALEIGH
State/Zip: NC 27612
Phone #: _____

Property Location & Site Information

Address/Road #: 30 CICIADA DR, NC Subdivision: _____ Phase: NEW Lot: 2

Directions:

Structure: SINGLE FAMILY 30 CICIADA DR

of Bedrooms: 4

of People: 6

*Water Supply: EXISTING WELL

System Specifications

*Site Classification: Provisionally Suitable Minimum Trench Depth: _____ Inches

Design Flow: 480

Maximum Trench Depth: 28 Inches

Soil Application Rate: 0.3000

Minimum Soil Cover: _____ Inches

*System Classification/Description:

TYPE II A. CONV SYSTEM (SINGLE-FAMILY OR 480 GPD OR LESS)

Maximum Soil Cover: _____ Inches

*Proposed System:

25% REDUCTION

*Distribution Type: GRAVITY - PARALLEL (eq. d-box)

Nitrification Field: _____ Sq. ft.

Septic Tank: 1,000 Gallons

No. Drain Lines: 4

Pump Required: ☐ Yes ☐ No ☒ May Be Required

Total Trench Length: 400 ft. ☐ Inches O.C.

Pump Tank: _____ Gallons

Trench Spacing: _____ - 9 ☒ Feet O.C.

Grease Trap: _____ Gallons

Trench Width: _____ - 3 ☒ Inches

Septic Tank Installer Grade Level Required: ☐ I ☐ II ☐ III ☐ IV

Aggregate Depth: _____ inches

The issuance of this permit by the Health Department in no way guarantees the issuance of other permits. The permit holder is responsible for checking with appropriate governing bodies in meeting their requirements.

*Permit Conditions:

There is an area of land here, identified on the site sketch, where a prior home resided. This area is to not be used for leach lines, due to soil compression. We will try to achieve gravity with 4 lines at 100 feet each. If 5 lines are needed, use manifold rather than dbox.

The Authorization for Wastewater System Construction shall be valid for a period equal to the period of validity of the Improvement Permit and may be issued at the same time the Improvement Permit issued (NCGS 130A-336(b)). If the installation has not been completed during the period of validity of the Construction Permit, the information submitted in the application for a permit or Construction Authorization shall become invalid, and may be suspended or revoked (.1937(g)). The person owning or controlling the system shall be responsible for assuring compliance with the laws, rules, and permit conditions regarding system location, installation, operation, maintenance, monitoring, reporting

Authorized State Agent: Jones, Lori

Date of Issue: 06/20/2022

☒ Hand Drawing

☐ Import Drawing

Site Plan/Drawing attached.

Total Time : (HH:MM) _____

File # 376907 PIN# _____

June 20 9:30

Property Address: 30 Cicada Dr. FrnkApplicant or Owner Name: Mark Dowdy**Environmental Health Septic/Well Permit Diagram**

Lot 2

Building permits cannot be issued nor should construction begin without Construction Authorization issuance.

☒ Septic Improvement Permit ☒ Septic Construction Authorization (CA) ☐ CA Reissue** ☐ As Built
☒ Well Construction Authorization ☐ Additional Diagram/Specifications AttachedDiagram Date**: 6-20-2022 EHS: Gou Jones

**Any previously dated CA diagram is revoked and/or invalid. Confirm this is the valid diagram for the site before beginning any construction.

Installation/grouting inspections may be scheduled the day before, or, the day of installation until 9am by contacting the Environmental Health office at 919 496 8100. A revisit fee may apply if installation is not ready for inspection at the time requested. Septic Operations Permits will be issued after installation is approved, all permits conditions are met, and any outstanding fees are paid. Well Certificate of Completion will be issued after well head approval, all permit conditions are met, and any outstanding fees are paid.

*Try to achieve gravity

Septic Tank 1000 Pump Tank 1000 maybe Drainfield 3'x400' Type System Accepted Max Trench Depth 28"

Septic Contractor _____ Septic/Pump tank dates _____ Pump fee? NO YES pd _____

Well Contractor _____ Well Grout date: _____ or self grout Well Head Date: _____

Bedrooms: 4If Repair: na

Benchmark/Elevation: _____

Tank Mfr: _____

STB: _____ Gallons: _____

Distance from house: _____ ft

Elevation: _____ Filter: _____

Dbox Elevation: _____

Supply Line Length: _____

Line(s):	Feeder (ft)	Line (ft)	Elevation
1			
2			
3			
4			
5			
6			
7			

Product: EZ flow or Chambers / LP

Pump Mfr: _____

STB: _____ Gallons: _____

Alarm: _____ Water Dose: _____

Water to manifold/dbox: _____

If dbox, flow adjusters correct: _____


If manifold, water pressure correct: _____

Dbox location: _____

Acreage: _____

Parcel ID: 048500

*Drawing not to scale (if large acreage, may be portion)
(If not as built, indicate changes on front or back of sheet.)

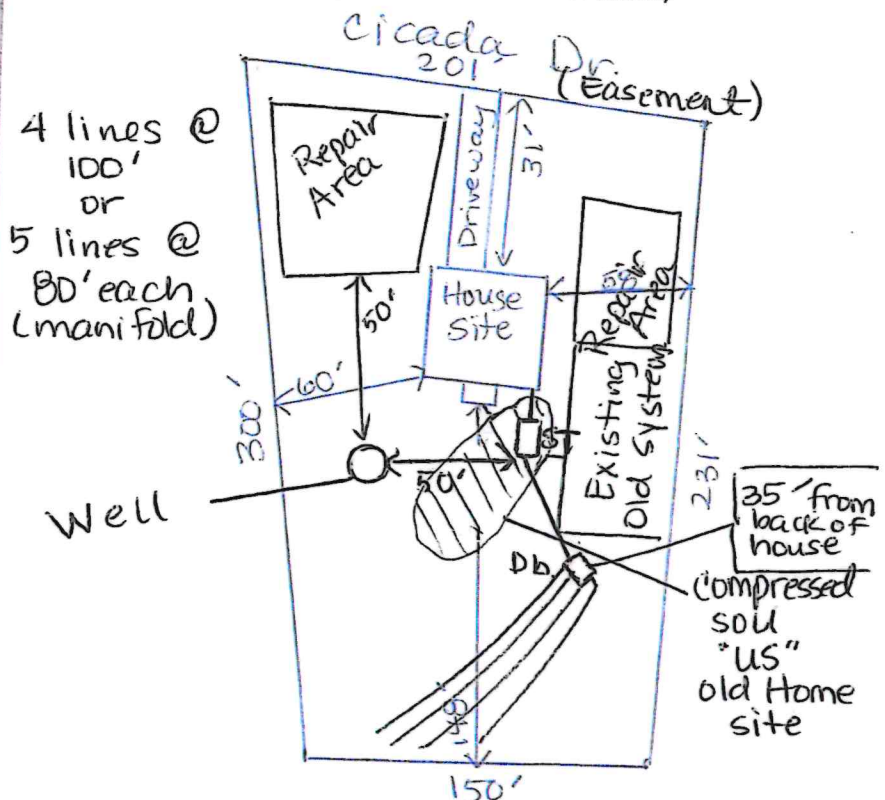

(If not as built indicate changes on front or back of sheet.)



OPERATION PERMIT

Franklin County Health Department
107 Industrial Drive
Louisburg, NC 27549
Phone:

For Office Use Only

*CDP File Number 376907 - 1
County ID Number: _____
Evaluated For: NEW

Property Owner: SHANNON HOMES DESIGN BUILD LLC
Owner Address: 4912 HERMITAGE DR

City: RALEIGH
State/Zip: NC/ 27612
Phone #:
Address: 30 CICADA DR
, NC

Road #:
Township:
Subdivision:
Phase : NEW Lot: 2

Structure: SINGLE FAMILY

of Bedrooms: 4
of People: 6

Water Supply: EXISTING WELL

Saprolite System?: ☐ Yes ☒ No

Pump Required?: ☒ Yes ☐ No

Design Flow: 480

System Classification/Description: TYPE II A. CONV SYSTEM
(SINGLE-FAMILY OR 480 GPD OR LESS)

Installer: DBS

Specific System EZFLOW EZ 1203H-GEO
Installed:

STB: 502

PT: 237

Comments:

Certification #:

Septic Tank Date: 12/08/2022

Pump Tank Date: 12/22/2022

This system has been installed in compliance with applicable NC General Statutes, Rules for Sewage Treatment and Disposal, and all conditions of the Improvement Permit and Construction Authorization.

PERMIT CONDITIONS:

I. Performance: System shall perform in accordance with Rule .1961.

II. Monitoring: As required by Rule .1961.

III. Maintenance: Ground absorption sewage treatment and disposal systems shall be checked, and the contents of the septic tank removed, periodically from all compartments, to ensure proper operation of the system. The contents shall be pumped whenever the solids level is found to be more than 1/3 of the liquid depth in any compartment.

Other:

Subsurface Operator Required: ☐ Yes ☒ No

If yes, see attached sheet for additional operation conditions, maintenance and reporting.

Operation:

Other:

Authorized State Agent: Jones, Lori

Date of Issue: 02/21/2023

Owner/Applicant: _____



>Msg for Pump fee 2-21-23 11:00

File # 376907 PIN# _____

Property Address: 30 Cicada Dr. Frk.

Applicant or Owner Name: Mark Dowdy

*Ammended once lot cleared & better meas.
Environmental Health Septic/Well Permit Diagram

Building permits cannot be issued nor should construction begin without Construction Authorization issuance.
☒ Septic Improvement Permit ☒ Septic Construction Authorization (CA) ☐ CA Reissue** ☐ As Built taken.
☐ Well Construction Authorization ☐ Additional Diagram/Specifications Attached

Diagram Date**: 7-8-2022 EHS: Lori Jones

**Any previously dated CA diagram is revoked and/or invalid. Confirm this is the valid diagram for the site before beginning any construction.

3 wrapped lines

Installation/grouting inspections may be scheduled the day before, or, the day of installation until 9am by contacting the Environmental Health office at 919 496 8100. A revisit fee may apply if installation is not ready for inspection at the time requested. Septic Operations Permits will be issued after installation is approved, all permits conditions are met, and any outstanding fees are paid. Well Certificate of Completion will be issued after well head approval, all permit conditions are met, and any outstanding fees are paid.

Septic Tank 1000 Pump Tank 1000 Drainfield 3'x420' Pump/manifold Accepted Max Trench Depth 28"
Septic Contractor DBS Septic/Pump tank dates 12-8-22/12-22-22 Pump fee? NO YES pd msg on portal
Well Contractor na Well Grout date: _____ or self grout Well Head Date: 2-17-2023

Bedrooms: 4

If Repair: _____

Benchmark/Elevation: _____

Tank Mfr: DBS

STB: 502 Gallons: _____

Distance from house: _____ ft

Elevation: _____ Filter: _____

Dbox Elevation: _____

Supply Line Length: 140'

Line(s):	Feeder (ft)	Line (ft)	Elevation
1		13/12 = 250	
2	4	0.7161	
3		170'	
4			
5			
6			

Product: EZ flow or Chambers / LP

Pump Mfr: Ashland 1-20

STB: 237 Gallons: 1000

Alarm: ☒ Water Dose: ☒

Water to manifold/dbox: ☒

If dbox, flow adjusters correct: _____

If manifold, water pressure correct: _____


Dbox location: SJE Phom's

Acreage: _____

Parcel ID: 048500

Pump Final 2-21-23

*Drawing not to scale (if large acreage, may be portion)
(If not as built, indicate changes on front or back of sheet.)

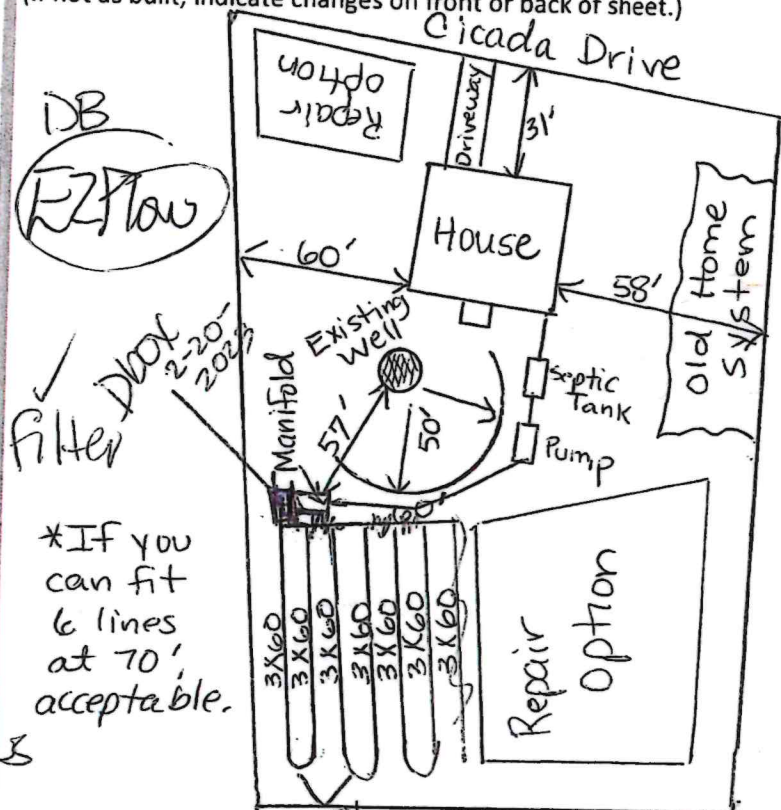

*If you can fit 6 lines at 70', acceptable.

No power

msg on portal 2-20-23
hot 2-20-23