



OPERATION PERMIT

Franklin County Health Department
107 Industrial Drive
Louisburg, NC 27549
Phone:

290 Whistler's Cove

For Office Use Only

*CDP File Number 355681 - 1

County ID Number:

Evaluated For: NEW

Property Owner: FIDELIS CONSTRUCTION INC

Address: PO BOX 550

Road #:

City: YOUNGSVILLE

State/Zip: NC/ 27596

Phone #:

Township:

Subdivision: HUNTSBURG

Phase : NEW

Lot: 34

Structure: SINGLE FAMILY

of Bedrooms: 4

of People: 2

Water Supply: NEW WELL

Saprolite System?: ☐ Yes ☒ No

Pump Required?: ☐ Yes ☒ No

Design Flow: 480

System Classification/Description: TYPE II A. CONV SYSTEM
(SINGLE-FAMILY OR 480 GPD OR LESS)

Installer: TrueWorks

Certification #:

Specific System EZFLOW EZ 1203H-GEO

Installed:

Septic Tank Date: 02/15/2022

STB: 502

Pump Tank Date: _____

PT:

Comments: 2 lines at 200 ft each. 11 ft supply line.

This system has been installed in compliance with applicable NC General Statutes, Rules for Sewage Treatment and Disposal, and all conditions of the Improvement Permit and Construction Authorization.

PERMIT CONDITIONS:

I. Performance: System shall perform in accordance with Rule .1961.

II. Monitoring: As required by Rule .1961.

III. Maintenance: Ground absorption sewage treatment and disposal systems shall be checked, and the contents of the septic tank removed, periodically from all compartments, to ensure proper operation of the system. The contents shall be pumped whenever the solids level is found to be more than 1/3 of the liquid depth in any compartment.

Other:

Subsurface Operator Required: ☐ Yes ☒ No

If yes, see attached sheet for additional operation conditions, maintenance and reporting.

Operation:

Other: 2 lines at 200 ft each. 11 ft supply line.

Authorized State Agent: Jones, Lori

Date of Issue: 03/31/2022

Owner/Applicant: _____

10:30



File # 355681

PIN#

Property Address: 290 Whistler's CV

Applicant or Owner Name: Fidelis Const.

Environmental Health Septic/Well Permit Diagram

Building permits cannot be issued nor should construction begin without Construction Authorization issuance.

☒ Septic Improvement Permit

☒ Septic Construction Authorization (CA)

☐ CA Reissue**

☐ As Built

☒ Well Construction Authorization

☐ Additional Diagram/Specifications Attached

Diagram Date: 9-2-21

EHS: Joel Bendel

**Any previously dated CA diagram is revoked and/or invalid. Confirm this is the valid diagram for the site before beginning any construction.

Installation/grouting inspections may be scheduled the day before, or, the day of installation until 9am by contacting the Environmental Health office at 919 496 8100. A revisit fee may apply if installation is not ready for inspection at the time requested. Septic Operations Permits will be issued after installation is approved, all permits conditions are met, and any outstanding fees are paid. Well Certificate of Completion will be issued after well head approval, all permit conditions are met, and any outstanding fees are paid.

Septic Tank 1000 Pump Tank N/A Drainfield 3'x400' Type System ACC Max Trench Depth 22"

Septic Contractor True Works Septic/Pump tank dates 2-15-22

Well Contractor Felton w/ Upfront Well Grout date: 11-4-2021 ggg Pump fee? Yes ☒

* Refer to attached CCSC Septic Layout *

DB 1000
STB 502

Filters.

2-15-22

2 @ 200' each


11' Supply Line

Dbox

* And Well

Location *

Elev. ✓

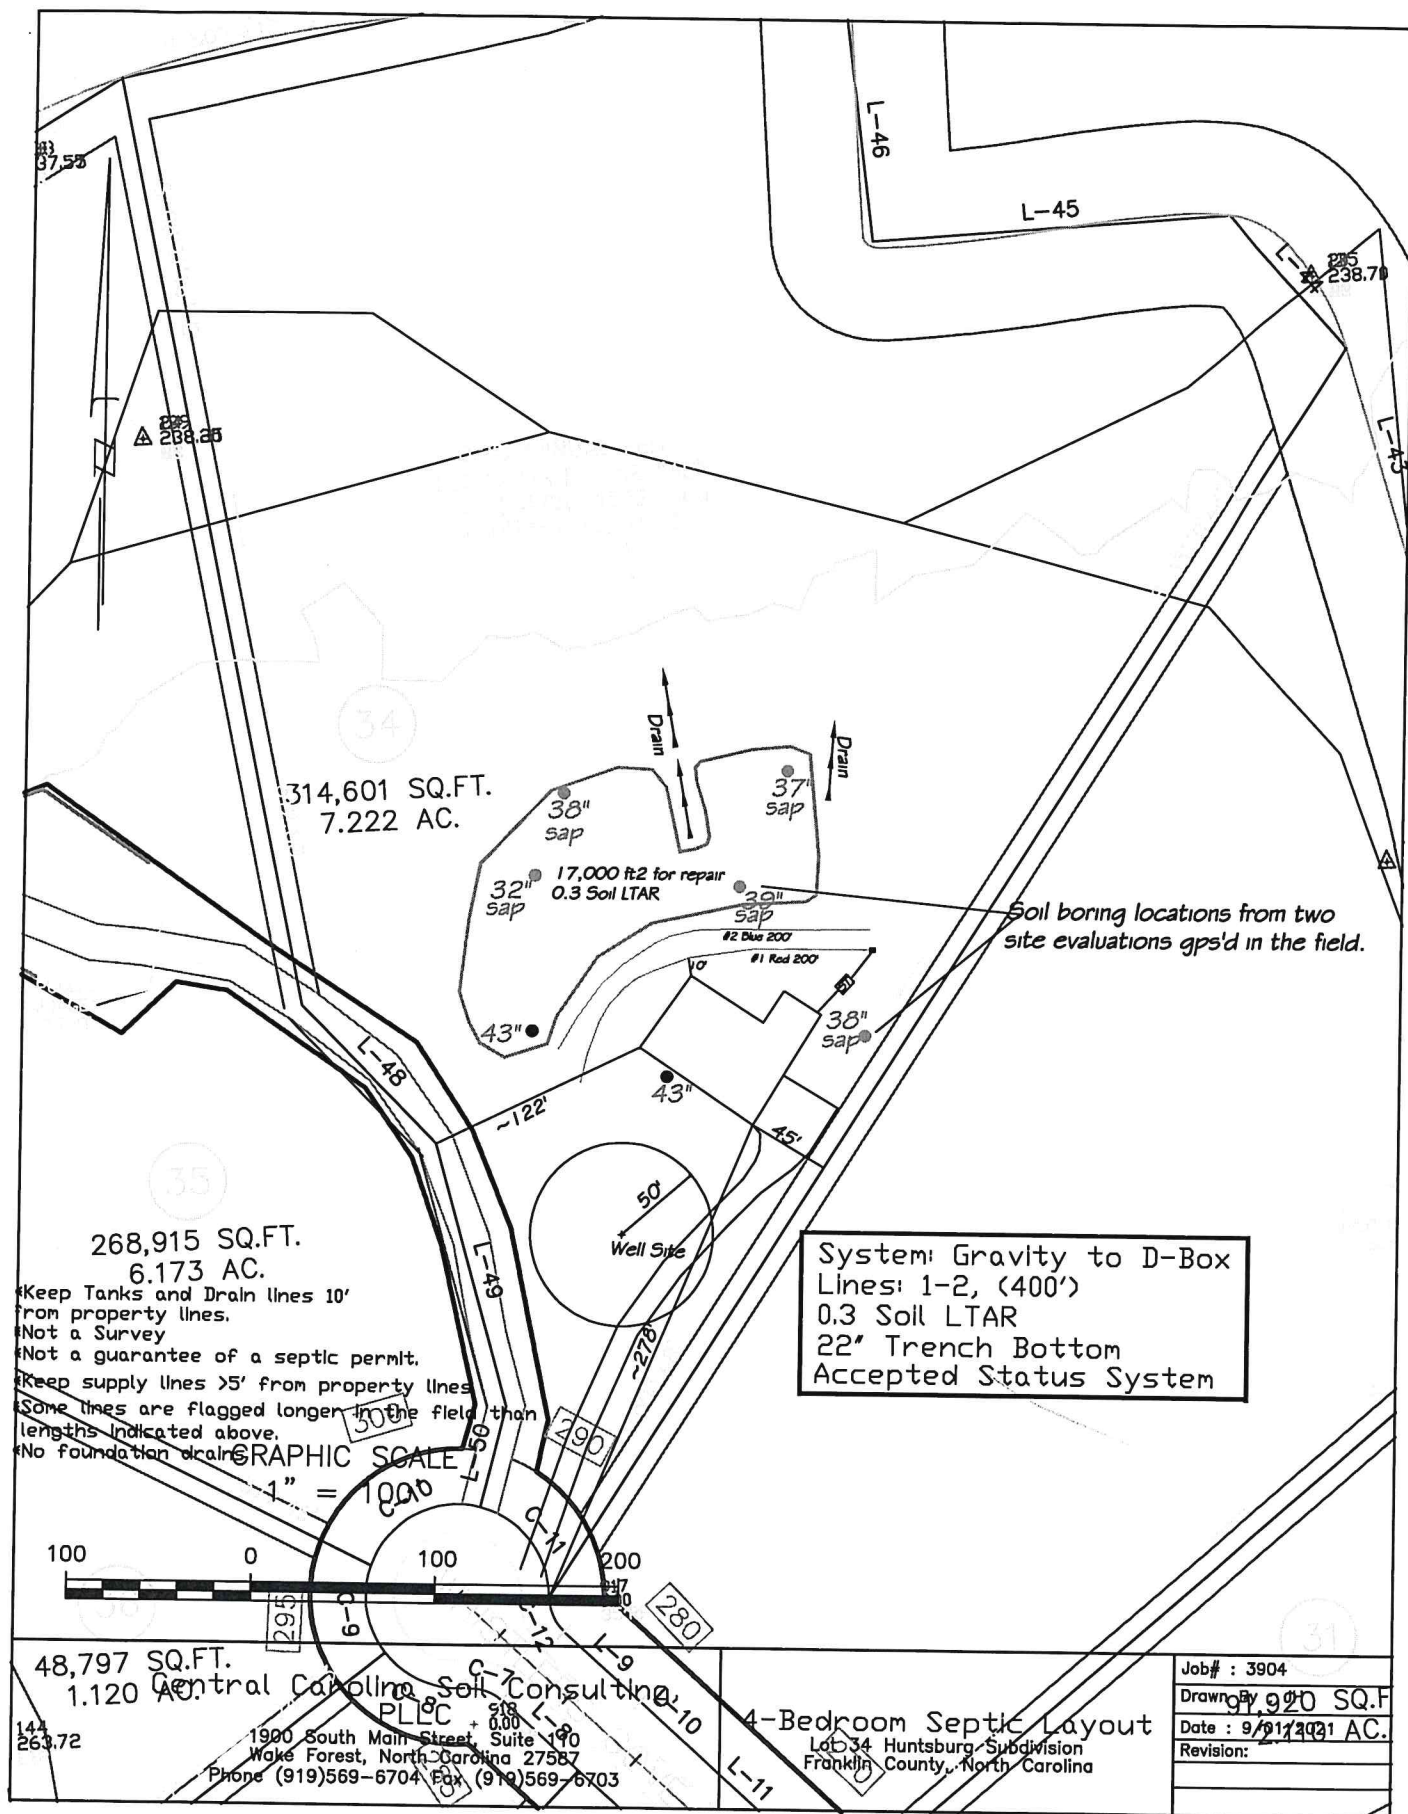

*Keep Tanks and Drain lines 10'
 from property lines.
 *Not a Survey
 *Not a guarantee of a septic permit.
 *Keep supply lines >5' from property lines
 *Some lines are flagged longer in the field than
 lengths indicated above.
 *No foundation drains

System: Gravity to D-Box
 Lines: 1-2, (400')
 0.3 Soil LTAR
 22" Trench Bottom
 Accepted Status System

GRAPHIC SCALE
 1" = 100'

Job# : 3904
Drawn By : 91,920 SQ.F
Date : 9/11/2001
Revision: 1

Central Carolina Soil Consulting
 PLLC
 1900 South Main Street, Suite 190
 Wake Forest, North Carolina 27587
 Phone (919)569-6704 Fax (919)569-6703

4-Bedroom Septic Layout
 Lot 34 Huntsburg Subdivision
 Franklin County, North Carolina