



OPERATION PERMIT

Franklin County Health Department
107 Industrial Drive
Louisburg, NC 27549
Phone:

For Office Use Only

*CDP File Number 382564 - 1
County ID Number: 2847-76-8871
Evaluated For: REPAIR

Property Owner: KYLE RICHARDSON

Address: 352 LEONARD RD

Road #:

City: LOUISBURG

State/Zip: NC/ 27549

Phone #:

Township:

Subdivision:

Phase : NEW

Lot:

Structure: SINGLE FAMILY

of Bedrooms: 3

of People:

Water Supply: EXISTING WELL

Saprolite System?: ☐ Yes ☒ No

Pump Required?: ☐ Yes ☒ No

Design Flow: 360

System Classification/Description: N/A

Installer: DB & Sons

Certification #: 1036

Specific System UNKNOWN

Installed:

Septic Tank Date: 04/25/2022

STB:

Pump Tank Date: _____

PT:

Comments: 1000 gallon septic tank installed. New d-box installed and one long drainline was found and connected.

This system has been installed in compliance with applicable NC General Statutes, Rules for Sewage Treatment and Disposal, and all conditions of the Improvement Permit and Construction Authorization.

PERMIT CONDITIONS:

I. Performance: System shall perform in accordance with Rule .1961.

II. Monitoring: As required by Rule .1961.

III. Maintenance: Ground absorption sewage treatment and disposal systems shall be checked, and the contents of the septic tank removed, periodically from all compartments, to ensure proper operation of the system. The contents shall be pumped whenever the solids level is found to be more than 1/3 of the liquid depth in any compartment.

Other:

Subsurface Operator Required: ☐ Yes ☒ No

If yes, see attached sheet for additional operation conditions, maintenance and reporting.

Operation:

Other: 1000 gallon septic tank installed. New d-box installed and one long drainline was found and connected.

Authorized State Agent: Ennis, Crystal

Date of Issue: 12/07/2022

Owner/Applicant: _____



File # 382564 PIN# 2847-76-8871

Property Address: 352 Leonard Rd.

Applicant or Owner Name: Kyle Richardson

Environmental Health Septic/Well Permit Diagram

Building permits cannot be issued nor should construction begin without Construction Authorization issuance.

☐ Septic Improvement Permit ☒ Septic Construction Authorization (CA) ☐ CA Reissue** ☒ As Built
☐ Well Construction Authorization ☐ Additional Diagram/Specifications Attached

Diagram Date**: 10-12-22 EHS: Cybil E

**Any previously dated CA diagram is revoked and/or invalid. Confirm this is the valid diagram for the site before beginning any construction.


Installation/grouting inspections may be scheduled the day before, or, the day of installation until 9am by contacting the Environmental Health office at 919 496 8100. A revisit fee may apply if installation is not ready for inspection at the time requested. Septic Operations Permits will be issued after installation is approved, all permits conditions are met, and any outstanding fees are paid. Well Certificate of Completion will be issued after well head approval, all permit conditions are met, and any outstanding fees are paid.

Septic Tank 1000 Pump Tank / Drainfield / Type System / Max Trench Depth /

Septic Contractor DBT Sun Septic/Pump tank dates 4-25-22 DB 1000 Pump fee? NO YES pd

Well Contractor / Well Grout date: /

* Drawing not to scale *
* Properly abandon existing ST *
* Install new 1000 gallon ST *

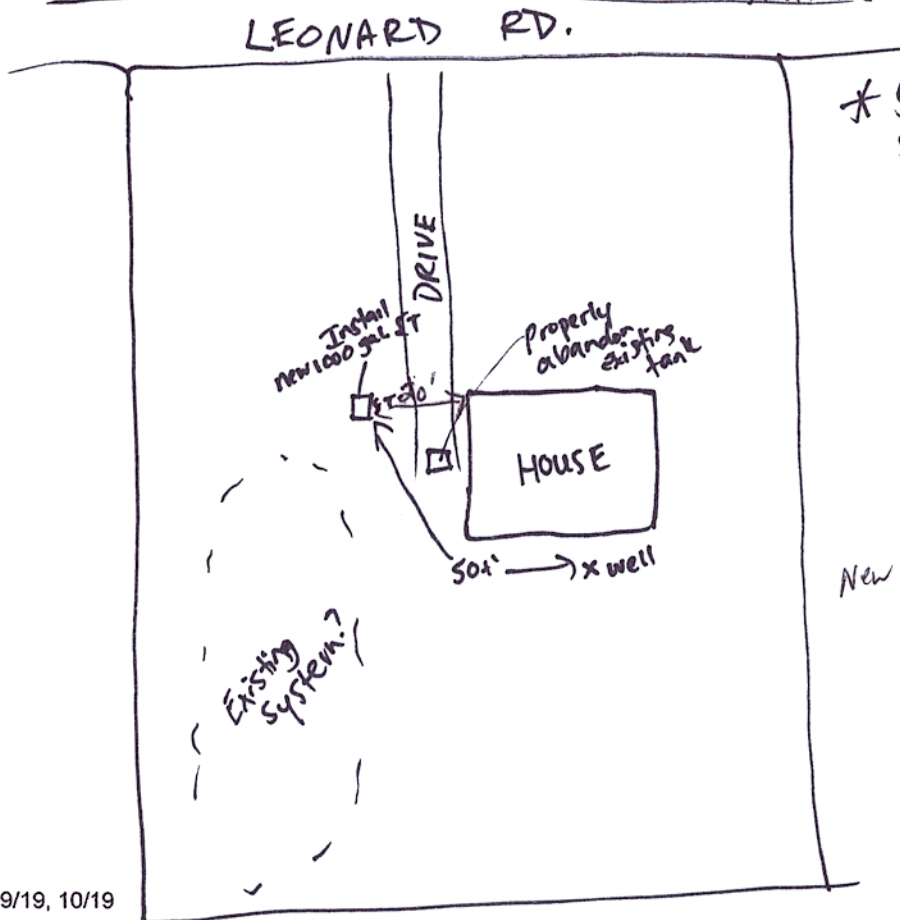

* Sleeve any part of system under driveway *

12-7-22
Cybil E

New 1000 gallon ST & new DB installed.