


FRANKLIN COUNTY HEALTH DEPARTMENT

PERMIT NUMBER: 25731 IMPROVEMENTS PERMIT		DATE: 10.29.90	ELEC26209	SIZE:
APPLICANT: GOWER JERRY		OWNER: MGA PROPERTIES		
TELEPHONE: 266-1880				
COMMENT: SINGLE FAMILY DWELLING				
LOCATION / DIRECTIONS: DEERWOOD #46 SK 1720				
FEE: 25.00 20956		SIGNATURE OF OWNER OR AUTHORIZED AGENT:		
CONFIRMED BY PLANNER: ✓		PLANNER: F.M.	DATE: 7-9-90	

THE ABOVE SIGNATURE INDICATES THAT I HAVE READ, UNDERSTAND, AND AGREE WITH ALL PROVISIONS AND INFORMATION AS OUTLINED ON THE BACK SIDE OF THIS FORM.

#BEDRMS <u>3</u>	DISPOSAL <u>N</u>	OTHER <u>-</u>	TYPE .SYS <u>C</u>
SZ .TANK <u>900</u>	SZ .CHAMB <u>-</u>	NITRIFI <u>350'x3'</u>	OPER .REQ <u>N</u>
SITE .LOC <u>-</u>			

REMARKS: Electrical Permit- This system approved for electrical inspection
Original Permit # 1786 Foxborough Crossing MHP 7-11-86

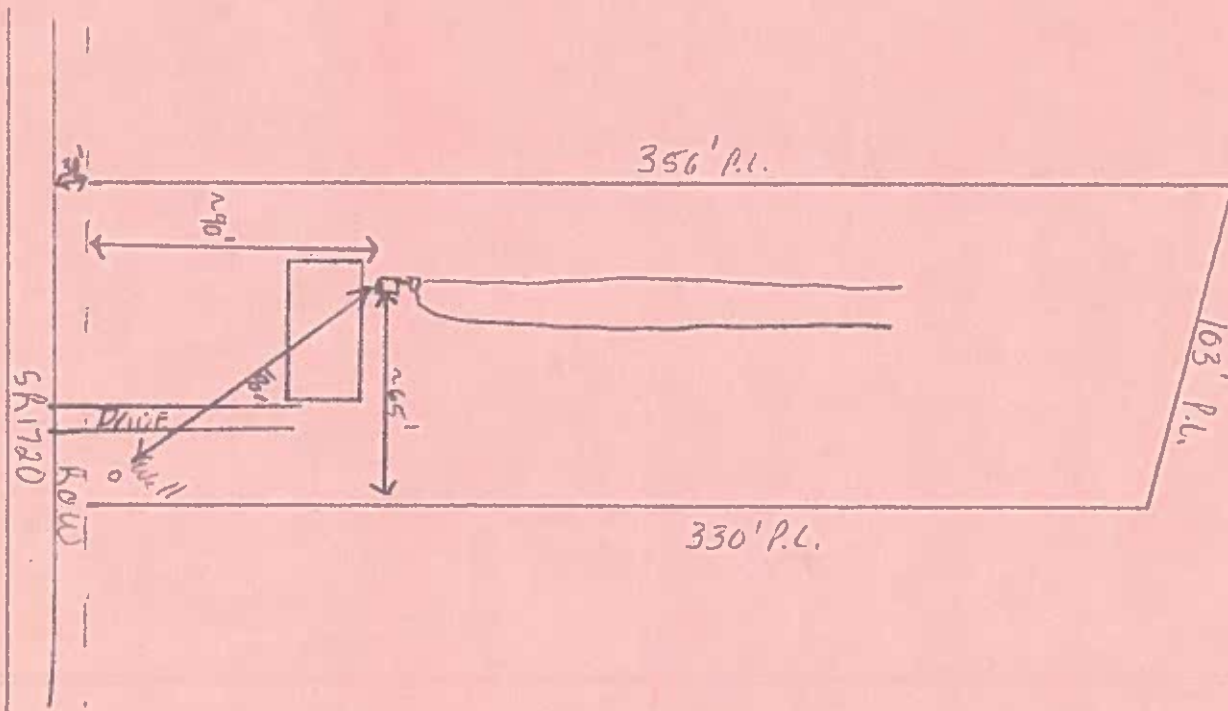

DATE ISSUED _____

EH SPECIALIST _____

DATE APPROVED 5.20.91

EH SPECIALIST Ed Duse/RS

LAWRENCE, C. A. (1910-1911)

FOR ALL INFORMATION CONCERNING THE HEALTH OF THE PEOPLE OF FRANKLIN COUNTY, MASSACHUSETTS, THE HEALTH DEPARTMENT OF FRANKLIN COUNTY, MASSACHUSETTS, HAS THE HONOR TO ADVISE YOU THAT THE FOLLOWING INFORMATION IS AVAILABLE TO THE PUBLIC:

LAWRENCE, C. A. (1910-1911)