

919-845-2066

**Franklin County Health Department
Environmental Health Section
107 Industrial Drive-Suite C
Louisburg, North Carolina 27549**

919-

PAGE 1 OF 2

Phone: 919-496-8100

Fax: 919-496-8136

Permit Number: 1106 Type: I PIN: 1861-47-7243 Date: 1/7/2005

Applicant: DENMARK CONSTRUCTION INC Owner: DENMARK CONSTRUCTION INC
416 US HWY 1 SUITE B 416 US HWY 1 SUITE B
YOUNGSVILLE, NC 27596 YOUNGSVILLE, NC 27596

Telephone: (919) 556-9007 Telephone: (919) 556-9007

Subdivision: RIVERS EDGE Lot Number: 96 Size: 0.920

Physical Address/ Location /Directions 240 OAK GROVE CHURCH RD

Description: LifeTime _____ 5 Year ✓TYPE FACIL Residence # EMPLOY _____ # BEDRMS 4 GPD 480 LTAR 0.24TYPE WAT Priv. TYPE SYS Innov TYPE REP Innov BSMT N/A BST FX N/ASIZE TANK 1000 SIZE CHB _____ SIZE NITR 3'x520' MTD 28"

COMMENTS * Install Innov. SYSTEM along Contour
& IN DRY Conditions
* Do NOT PARK OR Drive OVER SYSTEM

Septic Contractors are responsible for notifying the health department for final inspections, between 8:00-9:00 AM on the day of completion, Monday - Friday. Any request for final inspections received afterwards will be scheduled the same day, if possible, or the next workday. Have permit number and owner/applicant's name ready when making the call.

Actions of representatives of state or local agencies engaged in the evaluation and determination of measures required to effect the compliance with the provisions of this permit shall in no way be taken as a guarantee that wastewater disposal systems permitted and approved will function in a satisfactory manner for any given period of time, or that such employees assume any liability for damages, consequential or direct which are caused, or may be caused, by a malfunction of this wastewater treatment and disposal system.

Proper precautions must be taken to assure the proper functioning of the system after it has been covered. Do not run any heavy equipment over the system, as soft earth will allow damage to the tank and lines. Pipe all roof drains away from the septic system site to prevent flooding of the lines from surface water. Terrace the ground to prevent excessive drainage from higher areas adjacent to the system. Do not construct driveways over any part of the septic system unless proper provisions were made when the septic system was constructed. Only grass, not trees or shrubbery, should be cultivated over the lines. All plumbing fixtures should be carefully inspected periodically and any problems repaired immediately. All septic tanks should be pumped off by a permitted pump operator on a regular schedule, not to exceed every five years.

The improvement permit and construction authorization is a site approval, for the future installation of a wastewater treatment and disposal system. Changes in ownership of the site do not affect the validity of this permit. However, any alteration of the site or soil conditions, changes in the location of the proposed facility, changes to the wastewater flow and/or characteristics, or submittal of false information with the application or misrepresentation of the property lines may subject this permit to suspension or revocation.

**FOR THIS TO BE A VALID CONSTRUCTION AUTHORIZATION, A LAYOUT SHEET MUST BE
ATTACHED**

IMPROVEMENT PERMIT

DATE 1/18/05 EHS

CONSTRUCTION AUTHORIZATION

DATE 1/18/05 EHS

Andy Smith, RS
Andy Smith, RS

Franklin County Health Department

Name: DENMARK CONSTR


Permit Number

1106

CONTRACTOR James Bailey TANK MANU Mills 1000 MANU DATE 5/19/05

WELL INSTALLED AT TIME OF INSPECTION YES ☒ NO ☐

SEPTIC SYSTEM LAYOUT (SKETCH SYSTEM LAYOUT HERE)

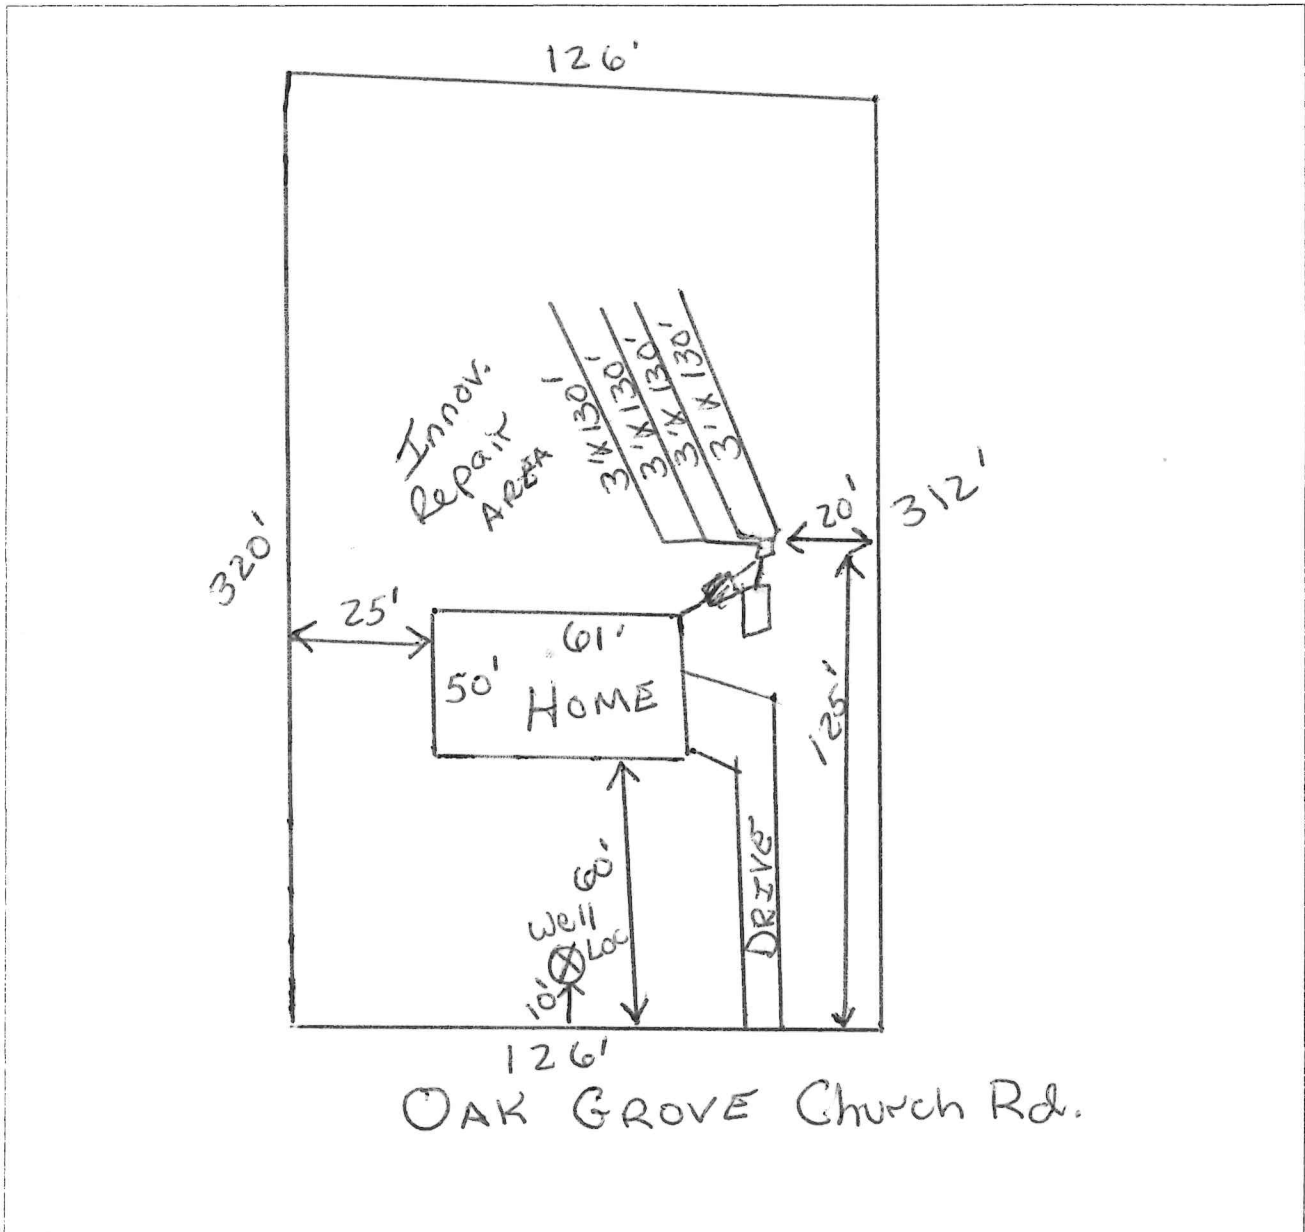

SEPTIC SYSTEM AS-BUILT

(IF DIFFERENT FROM INITIAL LAYOUT)

ON REVERSE

OPERATIONS PERMIT

DATE

7/14/05

EHS

Thad Jensen

APPLICANT DENMARK PROPERTY ID _____
WATER SUPPLY Private well DATE 1/14/05
LOCATION/DIRECTIONS River's edge 96

PROPERTY ID

DATE 1/14/09

LOCATION/DIRECTIONS River's Edge 96

PROFILES

		1	2	3	4	5	6
LANDSCAPE POSITION	1940	R	R				
SLOPE (%)	1940	4-6	4-6				
HORIZON I DEPTH	1943	0-8	0-8				
TEXTURE	1941(a) (1)	CL	CL				
CONSISTENCE	1941	Fi	Fi				
STRUCTURE	1941(a)(2)	SBK	SBK				
CLAY MINEROLOGY	1941(a)(3)	SBRP	SBRP				
HORIZON II DEPTH	1943	8-32	8-32				
TEXTURE	1941(a) (1)	C	C				
CONSISTENCE	1941	Fi	Fi				
STRUCTURE	1941(a)(2)	0, SBK	0, SBK				
CLAY MINEROLOGY	1941(a)(3)	SBRP	SBRP				
HORIZON III DEPTH	1943						
TEXTURE	1941(a) (1)						
CONSISTENCE	1941						
STRUCTURE	1941(a)(2)						
CLAY MINEROLOGY	1941(a)(3)						
HORIZON IV DEPTH	1943						
TEXTURE	1941(a) (1)						
CONSISTENCE	1941						
STRUCTURE	1941(a)(2)						
CLAY MINEROLOGY	1941(a)(3)						
SOIL WETNESS	1941	32"	32"				
RESTRICTIVE HORIZON	1944	732"	732"				
SAPROLITE	1943/1956	732"	732"				
CLASSIFICATION	1948	PS	PS				
LTAR (gpa/ft ²)	1955	0.24	0.24				
OTHER FACTORS (1946)				SITE LTAR (gpa/ft ²)	0.24		
AVAILABLE SPACE (1945)	PS			SYSTEM TYPE	Innov.		
CLASSIFICATION (1948)	PS						
EVALUATED BY:	ANDY S.			OTHERS PRESENT	Kevin		

COUNTY OF FRANKLIN

ENVIRONMENT HEALTH APPLICATION (496-8100)

Permit #: 13767

Permit Type: SEPTIC PERMIT

Date Issued: 01/06/2005

Project Address: 240 OAK GROVE CHURCH ROAD, YOUNGSVILLE NC

Location: 240 OAK GROVE CHURCH ROAD

Size #: 0.920

Subdivision: RIVER'S EDGE

Lot #: 96

Applicant: DEN-MARK CONSTRUCTION, INC
416 US HWY 1, SUITE B
YOUNGSVILLE, NC 27596

Phone: 919-556-9007

Owner: DENMARK CONSTRUCTION
PO BOX 610
YOUNGSVILLE, NC 27596

Phone:

Tax record: 36714

Pin #: 1861-47-7243

Parcel #: D07H00 096

Zoned: R-40

Setbacks Front: 50

Rear: 50

Side: 20

Proposed Use: SFD

of bedrooms: 5

of people: 4

Township: YOUNGSVILLE Public Water/Sewer: PRIVATE

ST Road #:

Desc:

Fees Due: \$225.00

Date Paid: 01/06/2005

* Please complete all sections below*

☐ Yes ☒ No Does this site contain any previously identified jurisdictional wetlands?
☐ Yes ☒ No Is any wastewater, other than domestic, going to be generated?
☐ Yes ☒ No Is the site subject to approval by any other public agency?

*If the answer to any of the above is "yes", applicant must submit supporting documentation.

Please indicate desired system type(s). Systems can be ranked in order of preference.

☒ Conventional ☐ Alternative ☐ Innovative ☐ Modified Conventional
☐ Other ☐ No Preference

Call Environmental Health (919.496.8100) between 8:00 - 9:00 am Monday - Friday in order to schedule an appointment with an environmental health specialist for your lot evaluation. This application for an improvement permit/construction authorization does not constitute approval for zoning, septic or building permits. It will be necessary to meet all guidelines for zoning, septic and building permits prior to construction. The permit is valid for either 60 months or without expiration, depending upon documentation submitted. (complete site plan= 60 months---complete surveyed plat=without expiration.)

I hereby certify that I am the owner, or authorized by the owner to act as his/her legal representation. Furthermore, as legal representative (if applicable) I have advised the owner of my intention to apply for this wastewater treatment and disposal system.

I also certify that all of the statements made in this application and any attached documents are true, complete, and correct, to the best of my knowledge and belief, and are made in good faith. If information in application for improvement permit is falsified, changed or site is altered, then improvement permit and authorization to construct shall become invalid. Authorized county representatives are granted right of entry to make evaluations or inspections, and to release information upon public request.

X

Signature of Owner or Owner's Legal Representative

01/06/2005

Franklin County DRC Application

RESIDENTIAL

Zoning Permit #: 8640



ADDRESS: 240 OAK GROVE CHURCH ROAD
 PARCEL NO.: 1861-47-7243 ZONING: R-40
 SUBDIVISION: RIVER'S EDGE LOT: 96
 ISSUED TO: DEN-MARK CONSTRUCTION, INC
 416 US HWY 1, SUITE B
 YOUNGSVILLE, NC 27596
 PHONE NUMBER: 919-556-9007
 SETBACK: FRONT: 50 RIGHT: 20 LEFT: 20 REAR: 50
 COUNTY WATER: NO FLOODPLAIN: NO
 PERMIT TYPE: ZONING PERMIT
 TYPE OF CONSTRUCTION: SFD
 PERMIT DATE: 01/06/2005 WATERSHED WSII
 TOWNSHIP YNGS EXPIRE DATE: 06/06/2005

It is hereby certified that the above use as shown on the plats and plans submitted with this application conforms with all applicable provisions of the Franklin County Zoning Ordinance. The issuance of this application does not allow the violation of Franklin County Zoning Ordinance or other governing regulations. The applicant is responsible for obtaining a building permit (if required) prior to commencing work on the proposed improvement. A final zoning inspection must be scheduled by the applicant.

NOTES:

I hereby certify that all information I have provided to the Planning Department is true and accurate.

APPLICANT'S SIGNATURE:

UTILITY COMPANY : PROGRESS ENGERY WAKE ELECTRIC OTHER
 NUMBER OF STORIES: 1 1 1/2 2 2 1/2
 SQUARE FOOTAGE: HEATED UNHEATED TOTAL
 BASEMENT: N/A YES NO MANUFACTURED
 FIREPLACE: N/A MASONRY MANUFACTURED
 PLAN SETS: MODULAR SURETY BOND STICKBUILT
 ELECTRICIAN: MECHANICAL:
 PLUMBING:
 COST OF CONSTRUCTION:

NO MORE THAN 2 STRUCTURAL DEVIATIONS OR PLANS MUST BE REDRAWN

DEPARTMENTAL USE ONLY

	INITIALS (IN)	DATE	INITIALS (OUT)	DATE
ZONING	KE	4/6/05		
INITIAL PERMITTING				
ADDRESSING				
PLAN REVIEW				
FIRE REVIEW				
SEPTIC SEWER				
FINAL PERMITTING				

39. ft.
AC