

Franklin County Health Department
Division of Environmental Health
107 Industrial Drive-Suite C
Louisburg, North Carolina 27549

PAGE 1 OF 2

Phone: 919-496-8100

SEPTIC PERMIT

Fax: 919-496-8136

Permit Number: 5248 Type: I PIN: 2831-46-1578 Date: 12/8/2009

Applicant: TONY BREDBERG Owner: KYLE POPE
8101 STONE BRIDGE CT 3801 GLOUCESTER RD
WAKE FOREST, NC 27587 27803

Telephone: (919) 413-4916

Telephone:

Subdivision: LAKE ROYALE

Lot Number: 556C

Size: 1.000

Physical Address/ Location /Directions 1703 SAGAMORE DR

Description: LifeTime _____ 5 Year X

TYPE FACIL Camp # EMPLOY - # BEDRMS - GPD 240 LTAR .49/d
TYPE WAT Com TYPE SYS ProI TYPE REP N/A BSMT N BST FX N/A
SIZE TANK 900 SIZE CHB 1000 SIZE NITR 3x150 MTD 30"

COMMENTS: _____

Septic Contractors are responsible for notifying the health department for final inspections, between 8:00-9:00 AM on the day of completion, Monday - Friday. Any request for final inspections received afterwards will be scheduled the same day, if possible, or the next workday. Have permit number and owner/applicant's name ready when making the call.

Actions of representatives of state or local agencies engaged in the evaluation and determination of measures required to effect the compliance with the provisions of this permit shall in no way be taken as a guarantee that wastewater disposal systems permitted and approved will function in a satisfactory manner for any given period of time, or that such employees assume any liability for damages, consequential or direct which are caused, or may be caused, by a malfunction of this wastewater treatment and disposal system.

Proper precautions must be taken to assure the proper functioning of the system after it has been covered. Do not run any heavy equipment over the system, as soft earth will allow damage to the tank and lines. Pipe all roof drains away from the septic system site to prevent flooding of the lines from surface water. Terrace the ground to prevent excessive drainage from higher areas adjacent to the system. Do not construct driveways over any part of the septic system unless proper provisions were made when the septic system was constructed. Only grass, not trees or shrubbery, should be cultivated over the lines. All plumbing fixtures should be carefully inspected periodically and any problems repaired immediately. All septic tanks should be pumped off by a permitted pump operator on a regular schedule, not to exceed every five years.

The improvement permit and construction authorization is a site approval, for the future installation of a wastewater treatment and disposal system. Changes in ownership of the site do not affect the validity of this permit. However, any alteration of the site or soil conditions, changes in the location of the proposed facility, changes to the wastewater flow and/or characteristics, or submittal of false information with the application or misrepresentation of the property lines may subject this permit to suspension or revocation.

FOR THIS TO BE A VALID CONSTRUCTION AUTHORIZATION, A LAYOUT SHEET MUST BE ATTACHED

IMPROVEMENT PERMIT

DATE 12/10/09

EHS [Signature]

CONSTRUCTION AUTHORIZATION

DATE 12/10/09

EHS [Signature]

Visit www.franklincountyenvironmentalhealth.com for permit information and tracking.

Franklin County Health Department

Name: BREDBERG

Permit Number


5248

CONTRACTOR _____ TANK MANU _____ MANU DATE _____

WELL INSTALLED YES _____ NO _____ SYSTEM CODE _____

SEPTIC SYSTEM LAYOUT (SKETCH SYSTEM LAYOUT HERE)

* Permit Not to Scale
* Camper w/ Addition already in place

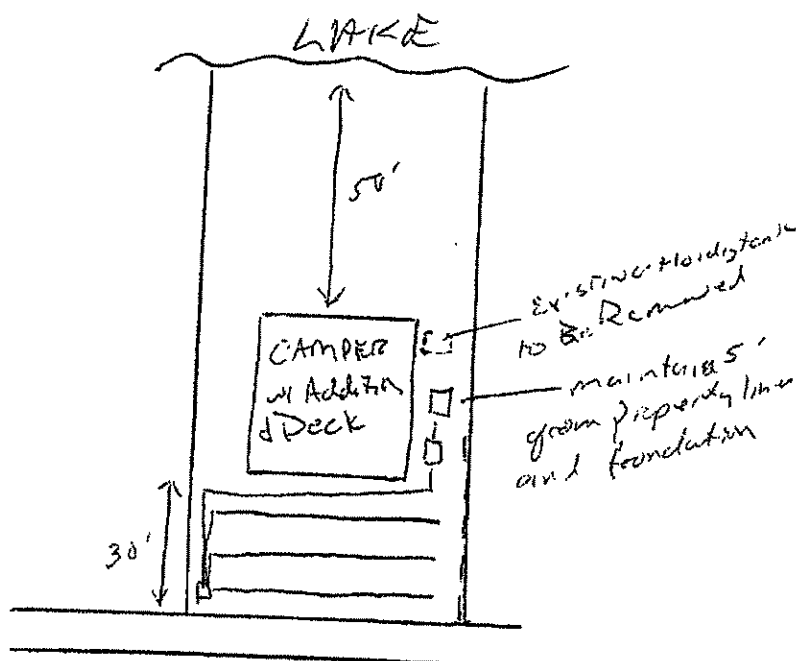

SEPTIC SYSTEM AS-BUILT (IF DIFFERENT FROM INITIAL LAYOUT) ON REVERSE

OPERATIONS PERMIT

DATE _____ EHS _____