



OPERATION PERMIT

Franklin County Health Department
107 Industrial Drive
Louisburg, NC 27549
Phone:

For Office Use Only

*CDP File Number 385494 - 1

County ID Number:

Evaluated For: NEW

Property Owner: PRO COMFORT LLC

Owner Address: 128 WAITERS WAY

City: YOUNGSVILLE

State/Zip: NC/ 27596

Phone #:

Address: 112 WICHITA WAY
LOUISBURG, NC 27549

Road #:

Township:

Subdivision: LOT ROYALE

Phase : NEW Lot:

Structure: SINGLE FAMILY

of Bedrooms: 3

of People: 5

Water Supply: COMMUNITY

Saprolite System?: ☐ Yes ☒ No

Pump Required?: ☒ Yes ☐ No

Design Flow: 360

System Classification/Description: TYPE III B. SYSTEM
W/SINGLE EFFLUENT PUMP

Installer: Busy Beez

Specific System EZFLOW EZ 1203H-GEO

Installed:

STB:

PT:

Comments:

Certification #:

Septic Tank Date: 01/23/2023

Pump Tank Date: 12/19/2022

This system has been installed in compliance with applicable NC General Statutes, Rules for Sewage Treatment and Disposal, and all conditions of the Improvement Permit and Construction Authorization.

PERMIT CONDITIONS:

I. Performance: System shall perform in accordance with Rule .1961.

II. Monitoring: As required by Rule .1961.

III. Maintenance: Ground absorption sewage treatment and disposal systems shall be checked, and the contents of the septic tank removed, periodically from all compartments, to ensure proper operation of the system. The contents shall be pumped whenever the solids level is found to be more than 1/3 of the liquid depth in any compartment.

Other:

Subsurface Operator Required:

☐

Yes

☒

No

If yes, see attached sheet for additional operation conditions, maintenance and reporting.

Operation:

Other:

Authorized State Agent: Leonard, Shad

Date of Issue: 04/03/2023

Owner/Applicant:



File # 385494 PIN# _____

Property Address: 112 Wichita Way

Applicant or Owner Name: Cristian Anton

Environmental Health Septic/Well Permit Diagram

Building permits cannot be issued nor should construction begin without Construction Authorization issuance.

☒ Septic Improvement Permit ☒ Septic Construction Authorization (CA) ☐ CA Reissue** ☒ As Built
☐ Well Construction Authorization ☐ Additional Diagram/Specifications Attached

Diagram Date**: 1-4-23 EHS: Joel Bendel

**Any previously dated CA diagram is revoked and/or invalid. Confirm this is the valid diagram for the site before beginning any construction.

Installation/grouting inspections may be scheduled the day before, or, the day of installation until 9am by contacting the Environmental Health office at 919 496 8100. A revisit fee may apply if installation is not ready for inspection at the time requested. Septic Operations Permits will be issued after installation is approved, all permits conditions are met, and any outstanding fees are paid. Well Certificate of Completion will be issued after well head approval, all permit conditions are met, and any outstanding fees are paid.

Septic Tank 1000 Pump Tank 1000 Drainfield 3'x300' Type System Pump Max Trench Depth 30"
Septic Contractor Busy Bees Septic/Pump tank dates ST DB 1000 1-23-23 Pump fee? NO YES pd 4-1-23 paid
Well Contractor _____ Well Grout date: _____

✓d Pump Man and lowerline 3/19/23 SEL


* Need to pay pump fee

* Refer to attached Plot plan

* Pressure Manifold
* 5-60' lines

* Achieve gravity if possible

✓d Tanks + lines 3-30-23 SEL
House not in place @ time of septic install
3'x60'
3'x60'
3'x60'
3'x60'
10' DST
House Box

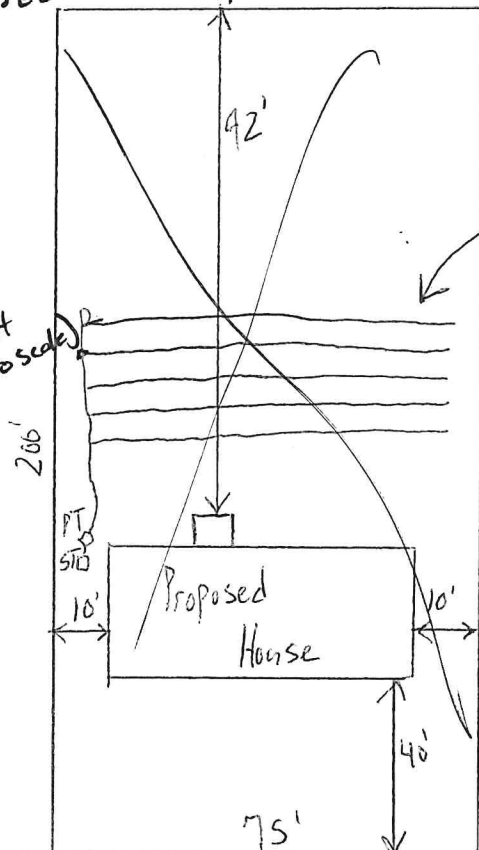

Wichita Way