



OPERATION PERMIT

Franklin County Health Department
107 Industrial Drive
Louisburg, NC 27549
Phone:

For Office Use Only

*CDP File Number 398989 - 1

County ID Number:

Evaluated For: EXISTING

Property Owner: ANDREA TESSIER
Owner Address: 199 BLACK CLOUD DR

City: LOUISBURG
State/Zip: NC/ 27549
Phone #:
Address: 199 BLACK CLOUD DR
LOUISBURG, NC 27549

Road #:
Township:
Subdivision: LOT ROYALE
Phase : NEW Lot:

Structure: OTHER

of Bedrooms: 3

of People: 3

Water Supply: PUBLIC

Saprolite System?: ☐ Yes ☒ No

Pump Required?: ☐ Yes ☒ No

Design Flow: 360

System Classification/Description: TYPE III G. OTHER
NON-CONV. TRENCH SYSTEMS

Installer:

Certification #:

Specific System 25% REDUCTION INNOVATIVE OR ACCEPTED
Installed:

Septic Tank Date: _____

STB:

Pump Tank Date: _____

PT:

Comments:

Approval of Existing septic system for a 3BDR Home

This system has been installed in compliance with applicable NC General Statutes, Rules for Sewage Treatment and Disposal, and all conditions of the Improvement Permit and Construction Authorization.

PERMIT CONDITIONS:

I. Performance: System shall perform in accordance with Rule .1961.

II. Monitoring: As required by Rule .1961.

III. Maintenance: Ground absorption sewage treatment and disposal systems shall be checked, and the contents of the septic tank removed, periodically from all compartments, to ensure proper operation of the system. The contents shall be pumped whenever the solids level is found to be more than 1/3 of the liquid depth in any compartment.

Other:

Subsurface Operator Required: ☐ Yes ☒ No

If yes, see attached sheet for additional operation conditions, maintenance and reporting.

Operation:

Other:

Authorized State Agent: Wood, Jeffrey

Date of Issue: 08/25/2023

Owner/Applicant: _____



File # 398989 PIN# _____

Property Address: 199 Black Cloud Dr

Applicant or Owner Name: Andrea Tessier

Environmental Health Septic/Well Permit Diagram

Building permits cannot be issued nor should construction begin without Construction Authorization issuance.

☐ Septic Improvement Permit ☐ Septic Construction Authorization (CA) ☐ CA Reissue** ☒ As Built
☐ Well Construction Authorization ☐ Additional Diagram/Specifications Attached

Diagram Date**: 8/25/23 EHS: [Signature]

**Any previously dated CA diagram is revoked and/or invalid. Confirm this is the valid diagram for the site before beginning any construction.



Installation/grouting inspections may be scheduled the day before, or, the day of installation until 9am by contacting the Environmental Health office at 919 496 8100. A revisit fee may apply if installation is not ready for inspection at the time requested. Septic Operations Permits will be issued after installation is approved, all permits conditions are met, and any outstanding fees are paid. Well Certificate of Completion will be issued after well head approval, all permit conditions are met, and any outstanding fees are paid.


Septic Tank 1000 Pump Tank — Drainfield 300' Type System Accepted Max Trench Depth —

Septic Contractor _____ Septic/Pump tank dates _____ Pump fee? Yes No

Well Contractor _____ Well Grout date: _____

Expansion permit to increase bedroom count to 3
Current septic system adequate for 3 BDR without addition. ^(New) Repair Area for 3 BDR designated as shown below. Repair will require addition of pump chamber and related components

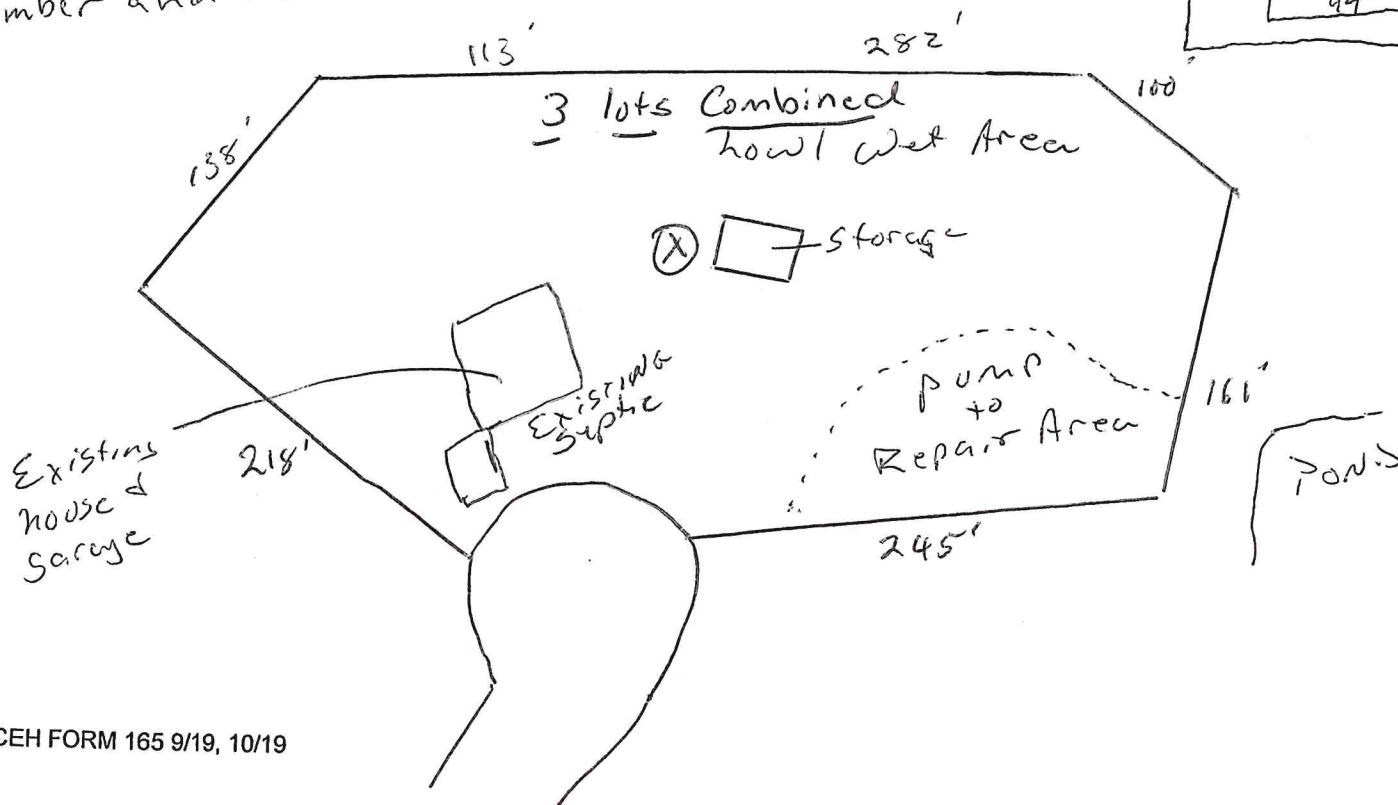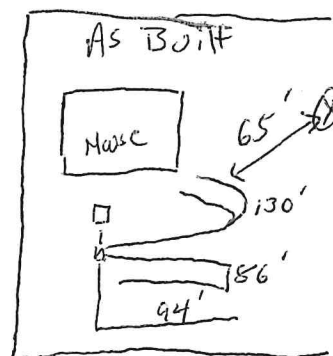

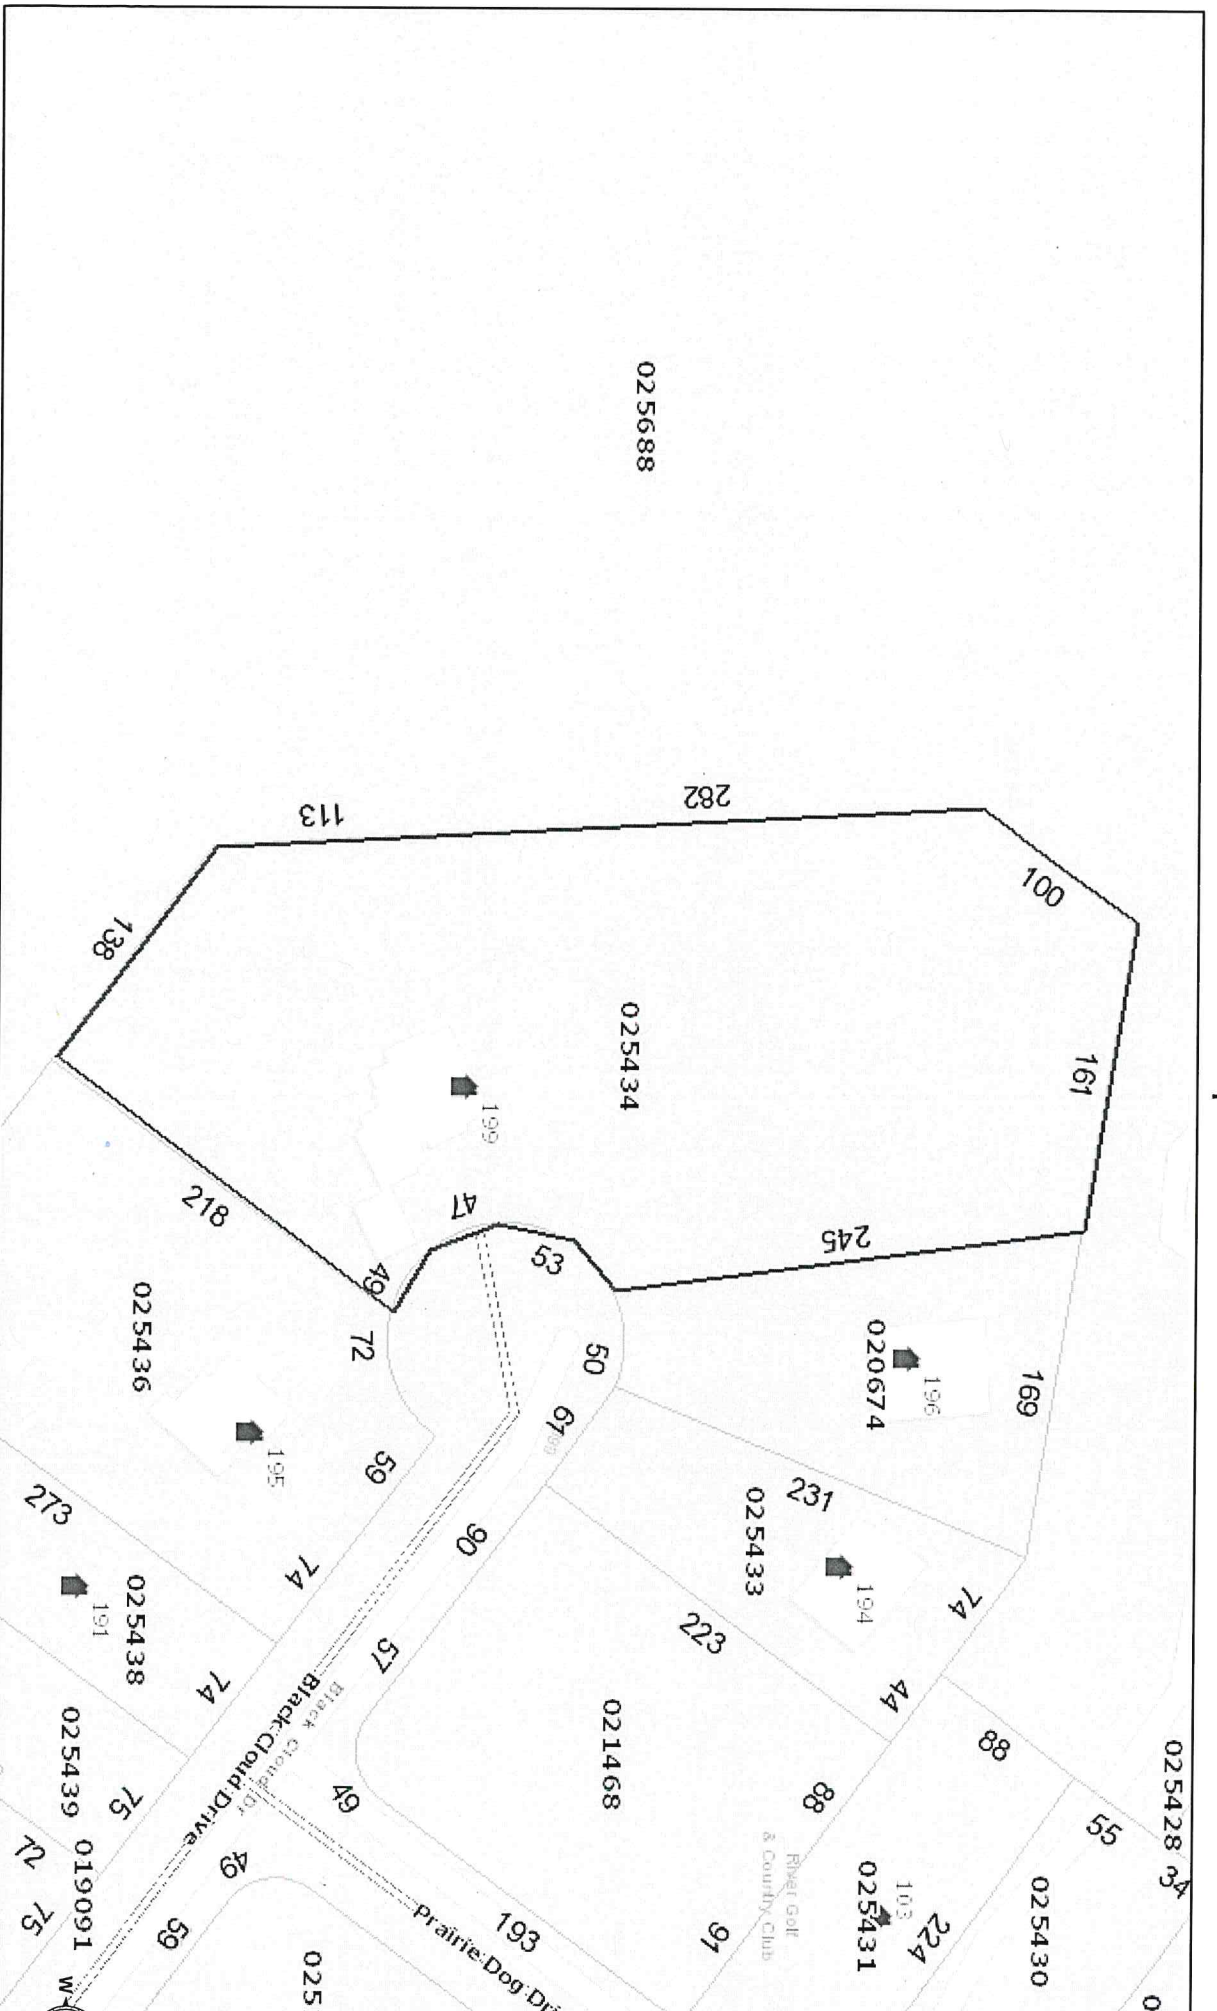

August 25, 2023

WARNING: THIS IS NOT A SURVEY.
This map is prepared for the inventory of real property found within this jurisdiction, and is compiled from recorded deeds, plats, and other public records and data. Users of this map are hereby notified that the aforementioned public primary information sources should be consulted for verification of the information contained on this map. The County and mapping company assume no legal responsibility for the information contained on this map.