



OPERATION PERMIT

Franklin County Health Department
107 Industrial Drive
Louisburg, NC 27549
Phone:

For Office Use Only

*CDP File Number 366337 - 1
County ID Number: 2830-13-7961
Evaluated For: NEW

Property Owner: CANTIERE HOMES INC

Address: 8505 ALDEN LANE

Road #:

City: WAKE FOREST

State/Zip: NC/ 27587

Phone #:

Township:

Subdivision: LAKE ROYALE

Phase : NEW

Lot: 3107

Structure: SINGLE FAMILY

of Bedrooms: 3

of People: 6

Water Supply: N/A

Saprolite System?: ☐ Yes ☒ No

Pump Required?: ☐ Yes ☒ No

Design Flow: 360

System Classification/Description: TYPE II A. CONV SYSTEM
(SINGLE-FAMILY OR 480 GPD OR LESS)

Installer: TruWorks

Specific System: UNKNOWN

Installed:

STB: 1000

PT:

Comments:

Certification #:

Septic Tank Date: 06/30/2022

Pump Tank Date: _____

This system has been installed in compliance with applicable NC General Statutes, Rules for Sewage Treatment and Disposal, and all conditions of the Improvement Permit and Construction Authorization.

PERMIT CONDITIONS:

- I. Performance: System shall perform in accordance with Rule .1961.
- II. Monitoring: As required by Rule .1961.
- III. Maintenance: Ground absorption sewage treatment and disposal systems shall be checked, and the contents of the septic tank removed, periodically from all compartments, to ensure proper operation of the system. The contents shall be pumped whenever the solids level is found to be more than 1/3 of the liquid depth in any compartment.

Other:

Subsurface Operator Required: ☐ Yes ☒ No

If yes, see attached sheet for additional operation conditions, maintenance and reporting.

Operation:

Other:

Authorized State Agent: Bendel, Joel

Date of Issue: 07/22/2022

Owner/Applicant: _____



Franklin County
215 E. Nash St. Louisburg, NC 27549
Phone (919) 496-2281
www.franklincountync.us

Issued to: Cantiere Homes Inc Stacey DiStefano Location: 271 SACRED FIRE RD LOUISBURG , NC 27549

3106337 NEW SEPTIC APPLICATION 2830-13-7961

Application Type: NEW SEPTIC

Application Number: **E-21-943**

Building Type:

Project Type: Single Family Dwelling

of Bedrooms: 3

Parcel ID #: 020827

Date: November 18, 2021

Acreage: 0.46

Zoning: R-30

of People: 6

Subdivision: LOT ROYALE

#3107

bel m h 24
C12

Applicant Information

Applicant Name: Cantiere Homes Inc Stacey DiStefano

Address: 8505 Alden Ln Wake Forest , NC 27587

Phone: 919-285-8986

Email: cantierhomes@gmail.com

Property Owner Information

Owner Name: Cantiere Homes Inc

Address: 8505 Alden Ln Wake Forest , NC 27587

Phone:

Email:

General Contractor Information

Contractor Name: Cantiere Homes, Inc.

Address: 8505 Alden Ln Wake Forest , NC 27587

Phone: (919) 285-8986

Email: Cantierhomes@gmail.com

Zoning

Zoning Permit #: Z-21-1871

Front Setback: 15

Left Setback: 5

County Water: TESI

Right Setback: 5

Rear Setback: 5

Call Environmental Health (919-496-8100) between 8:00 - 9:00 a.m. Monday - Friday in order to schedule an appointment with and environmental Health Specialist for your lot evaluation. This application for an improvement permit/construction authorization and well permit does not constitute approval for zoning, septic, and building permits. It will be necessary to meet all guidelines for zoning, septic, and building permits prior to construction. The application is valid for either 12 months or without expiration, depending upon documentation submitted.

Please contact the Environmental Health Department at 919-496-8100 to determine the status of your application prior to visiting the Planning & Inspections Department to obtain a building permit.

I hereby certify that I am the owner, or authorized by the owner to act as his/her legal representation. Furthermore, as legal representative (if applicable) I have advised the owner of my intention to apply for this wastewater treatment and disposal system and drinking water and well system permit.

I also certify that all of the statements made in this application and any attached documents are true, complete, and correct, to the best of my knowledge and belief, and are made in good faith. If information in this application for these improvements is falsified, changed or site is altered, then improvement permits and authorization to construct these improvements shall become invalid. Authorized county representatives are granted right of entry to make these evaluations or inspections, and to be release information upon public request.

November 18, 2021

11/23/21, 2:21 PM

Stacey Di Stefano

Signature of Owner or Owner's Legal Representative

Expires: November 18, 2022

SURVEY FOR

CANTIERE HOMES

LOTS 3107, LAKE ROYALE

271 SACRED FIRE ROAD

PIN # 2830-13-7961

D.B. 1099, PAGE 199

P.B. 2005, PAGE 402


CYPRESS CREEK TOWNSHIP

FRANKLIN COUNTY, NORTH CAROLINA


SEPTEMBER 16, 2021



SACRED FIRE 50' PRIVATE R/W

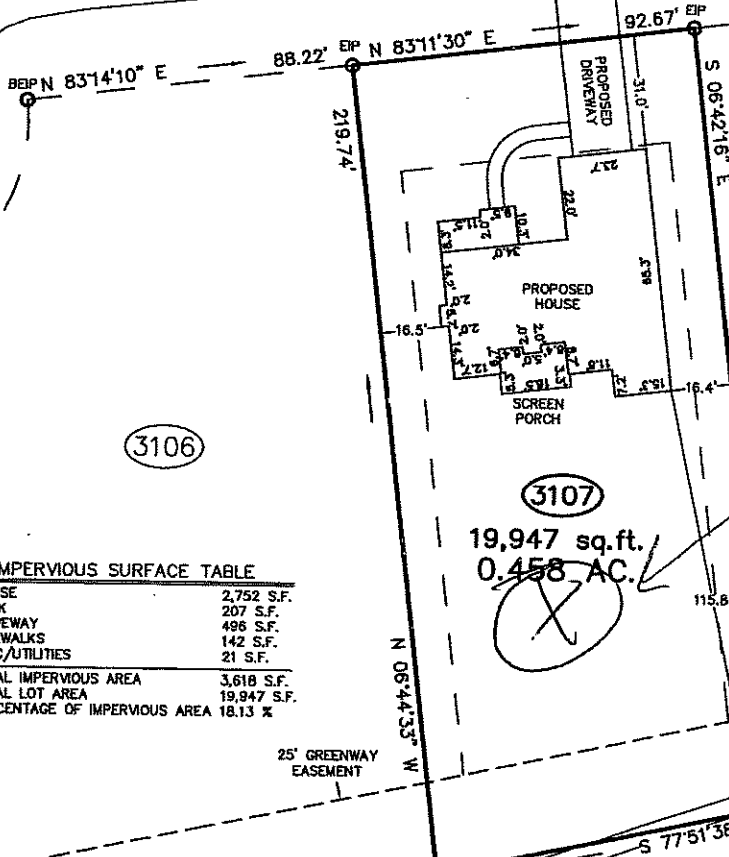

IMPERVIOUS SURFACE TABLE	
HOUSE	2,752 S.F.
DECK	207 S.F.
DRIVEWAY	496 S.F.
SIDEWALKS	142 S.F.
MISC./UTILITIES	21 S.F.
TOTAL IMPERVIOUS AREA	3,618 S.F.
TOTAL LOT AREA	19,947 S.F.
PERCENTAGE OF IMPERVIOUS AREA	18.13 %

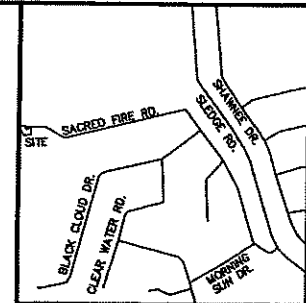

VICINITY MAP

LEGEND:

- EIP - EXISTING IRON PIPE
- EIB - EXISTING IRON BAR
- BEIP - BENT IRON PIPE
- BEIB - BENT IRON BAR
- CM - CONCRETE MONUMENT
- EPK - EXISTING PK NAIL
- SPK - SET PK NAIL
- NIP - NEW IRON PIPE SET
- R/W - RIGHT OF WAY
- CATV - CABLE TV BOX
- EB - ELECTRIC BOX
- TEL - TELEPHONE PEDESTAL
- PP - POWER POLE
- OHL - OVERHEAD LINE
- LP - LIGHT POLE
- WM - WATER METER
- WV - WATER VALVE
- CO - SEWER CLEAN-OUT

LINE TABLE		
LINE	BEARING	DISTANCE
L-1	N 77°57'08" E	60.09'
L-2	N 77°51'38" E	33.42'



CMP


CAWTHORNE, MOSS
& PANCIERA, P.C.

Professional Land Surveyors
C-1525

333 S. White Street
Post Office Box 1253
Wake Forest, N.C. 27588
(919)556-3148

I DECLARE THAT THIS SURVEY COMPLIES WITH THE NORTH CAROLINA STANDARDS OF PRACTICE FOR SURVEYING, (SECTION 1800) FOR CLASS A SURVEYS AND THAT THE CALCULATED RATIO OF PRECISION BEFORE ADJUSTMENTS IS 1:10,000+. FURTHERMORE, PROPERTY CORNERS SHOWN ARE PRIMARY CONTROL MONUMENTATION FOR THE RE-ESTABLISHMENT OF PROPERTY CORNERS IN THE ABSENCE OF GRID/MONUMENTS AND OTHER SUBDIVISION PROPERTY CORNERS. THIS SURVEY IS NOT TO BE RECORDED WITHOUT THE WRITTEN AUTHORIZATION OF THE SURVEYOR.

PROFESSIONAL LAND SURVEYOR L-3835

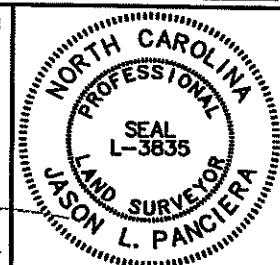



IMPROVEMENT PERMIT

Franklin County Health Department
107 Industrial Drive
Louisburg, NC 27549
Phone: _____

For Office Use Only

*CDP File Number: 366337 - 1
County ID Number: 2830-13-7961
Evaluated For: NEW

PERMIT VALID UNTIL: 12/09/2026

***NOTE TO INSPECTIONS DIVISION:** Building Permits cannot be issued with this Improvement Permit.

Applicant: CANTIERE HOMES INC STACEY DISTEFANO
Address: 8505 ALDEN LANE
City: WAKE FOREST
State/Zip: NC 27587
Phone #: _____

Property Owner: CANTIERE HOMES INC
Address: 8505 ALDEN LANE
City: WAKE FOREST
State/Zip: NC. 27587
Phone #: _____

Property Location & Site Information

Address/Road #: 271 SACRED FIRE RD
Subdivision: LAKE ROYALE Phase: NEW Lot: 3107
Structure: LOUISBURG, NC 27549
Directions
of Bedrooms: 3 271 SACRED FIRE
of People: 6
*Water Supply: N/A

System Specifications

Initial System

*Site Classification:

Design Flow: 360

Soil Application Rate: _____

*System Classification/Description:

TYPE III B. SYSTEM W/SINGLE EFFLUENT PUMP

*Proposed System:

25% REDUCTION

Minimum Trench Depth: _____ Inches

Maximum Trench Depth: 27 Inches

Septic Tank: 1000 Gallons

Pump Required ☐ Yes ☐ No ☒ May Be Required

Pump Tank: 1000 Gallons

Repair System Required: ☒ Yes ☐ No ☐ No, but has Available Space

Repair System

*Site Classification:

Soil Application Rate:

*System Classification/Description:

N/A

*Proposed System:

Minimum Trench Depth: _____ Inches

Maximum Trench Depth: _____ Inches

Pump Required: ☐ Yes ☐ No ☐ May Be Required

Pump Tank: _____ Gallons

No grading or construction activity is allowed in areas designated for system and repair without approval of Health Department

*Site Modifications

The issuance of this permit by the Health Department in no way guarantees the issuance of other permits. The permit holder is responsible for checking with appropriate governing bodies in meeting their requirements.

*Permit Conditions

The Department and Local Health Department may impose conditions on the issuance and may revoke the permits for failure of the system to satisfy the conditions, the rules, or this article. This permit is subject to revocation if the site plan, plat, or intended use changes (NCGS 130A-335(f)). The person owning or controlling the system location, installing, operation, maintenance, monitoring, reporting, and repair (1.1938(b)).

Authorized State Agent: _____

Bendel, Joel

Date of Issue: _____

12/09/2021

Total Time: (HH:MM)

☐ Hand Drawing

☐ Import Drawing

Site Plan/Drawing attached.



Construction Authorization

Franklin County Health Department
107 Industrial Drive
Louisburg, NC 27549
Phone: _____

For Office Use Only

*CDP File Number: 366337 - 1

County ID Number: 2830-13-7961

Evaluated For: NEW

PERMIT VALID UNTIL: 12/09/2026

☐ Open Pump System Sheet

Applicant: CANTIERE HOMES INC STACEY DISTEFANO

Address: 8505 ALDEN LANE

City: WAKE FOREST

State/Zip: NC 27587

Phone #: _____

Property Owner: CANTIERE HOMES INC

Address: 8505 ALDEN LANE

City: WAKE FOREST

State/Zip: NC. 27587

Phone #: _____

Property Location & Site Information

Address/Road #: 271 SACRED FIRE RD
LOUISBURG, NC 27549

Subdivision: LAKE ROYALE Phase: NEW Lot: 3107

Directions:

Structure: SINGLE FAMILY 271 SACRED FIRE

of Bedrooms: 3

of People: 6

*Water Supply: _____

System Specifications

*Site Classification: _____

Minimum Trench Depth: _____ Inches

Design Flow: 360

Maximum Trench Depth: 27 Inches

Soil Application Rate: _____

Minimum Soil Cover: _____ Inches

*System Classification/Description:

TYPE III B. SYSTEM W/SINGLE EFFLUENT PUMP

Maximum Soil Cover: _____ Inches

*Proposed System:

25% REDUCTION

*Distribution Type: PUMP TO GRAVITY

Nitrification Field: _____ Sq. ft.

Septic Tank: 1,000 Gallons

No. Drain Lines: _____

Pump Required: ☐ Yes ☐ No ☒ May Be Required

Total Trench Length: 300 ft.

☐ Inches O.C.

Pump Tank: 1,000 Gallons

☐ Feet O.C.

Trench Spacing: _____ - _____

☐ Inches

Grease Trap: _____ Gallons

Trench Width: _____ - _____

☐ Feet

Aggregate Depth: _____ inches

Septic Tank Installer

Grade Level Required: ☐ I ☐ II ☐ III ☐ IV

The issuance of this permit by the Health Department in no way guarantees the issuance of other permits. The permit holder is responsible for checking with appropriate governing bodies in meeting their requirements.

*Permit Conditions:

The Authorization for Wastewater System Construction shall be valid for a period equal to the period of validity of the Improvement Permit and may be issued at the same time the Improvement Permit issued (NCGS 130A-336(b)). If the installation has not been completed during the period of validity of the Construction Permit, the information submitted in the application for a permit or Construction Authorization shall become invalid, and may be suspended or revoked (.1937(g)). The person owning or controlling the system shall be responsible for assuring compliance with the laws, rules, and permit conditions regarding system location, installation, operation, maintenance, monitoring, reporting

Authorized State Agent: Bendel, Joel

Date of Issue: 12/09/2021

☐ Hand Drawing

☐ Import Drawing

Site Plan/Drawing attached.

Total Time : (HH:MM) _____



File # 366337 PIN# _____

Property Address: 271 Sacred Fire Rd

Applicant or Owner Name: CanHere Homes Inc

Environmental Health Septic/Well Permit Diagram

Building permits cannot be issued nor should construction begin without Construction Authorization Issuance.

☒ Septic Improvement Permit ☒ Septic Construction Authorization (CA) ☐ CA Reissue** ☒ As Built
☐ Well Construction Authorization ☐ Additional Diagram/Specifications Attached


Diagram Date**: 12-9-21 EHS: Joel Bendel

**Any previously dated CA diagram is revoked and/or invalid. Confirm this is the valid diagram for the site before beginning any construction.

Installation/grouting inspections may be scheduled the day before, or, the day of installation until 9am by contacting the Environmental Health office at 919 496 8100. A revisit fee may apply if installation is not ready for inspection at the time requested. Septic Operations Permits will be issued after installation is approved, all permits conditions are met, and any outstanding fees are paid. Well Certificate of Completion will be issued after well head approval, all permit conditions are met, and any outstanding fees are paid.

Septic Tank 1000 Pump Tank 1000 Drainfield 3' x 300' Type System P to Acc Max Trench Depth 27"
Septic Contractor TrueWorlth Septic/Pump tank dates ST 6-30-22 Pump fee? NO ☒ YES ☐ pd
Well Contractor _____ Well Grout date: _____

* Achieve Gravity if possible

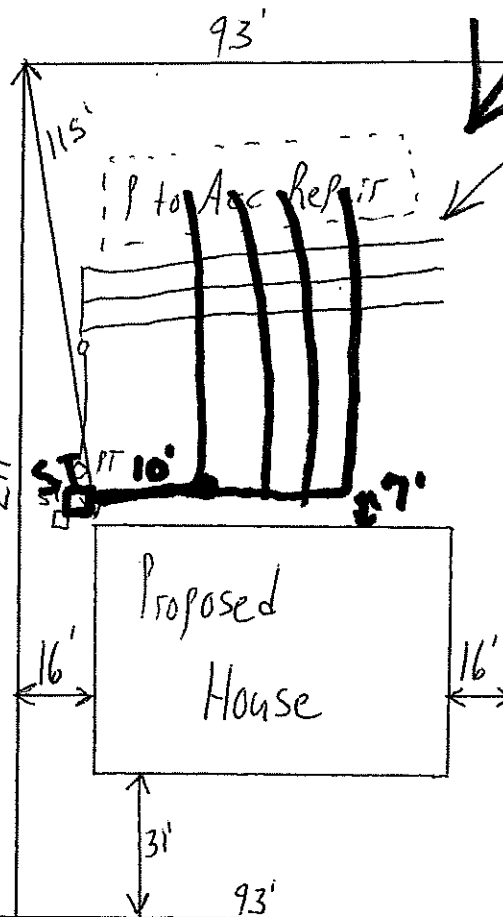

4-75' lines
* Achieve gravity if possible