



OPERATION PERMIT

Franklin County Health Department
107 Industrial Drive
Louisburg, NC 27549
Phone:

For Office Use Only

*CDP File Number 385226 - 1

County ID Number:

Evaluated For: NEW

Property Owner: MICHAEL GENE NATION

Owner Address: 18071 SALTER RD

City: FORT MYERS

State/Zip: FL/ 33917

Phone #:

Address: 139 OSWEGO DR
LOUISBURG, NC 27549

Road #:

Township:

Subdivision: LOT ROYALE

Phase : NEW Lot:

Structure: SINGLE FAMILY

of Bedrooms: 3

of People: 5

Water Supply: COMMUNITY

Saprolite System?: ☐ Yes ☒ No

Pump Required?: ☐ Yes ☒ No

Design Flow: 360

System Classification/Description: TYPE III G. OTHER
NON-CONV. TRENCH SYSTEMS

Installer: *Busy Beez*

Certification #:

Specific System EZFLOW EZ 1203H-GEO

Installed:

Septic Tank Date: 09/20/2023

STB: 646

Pump Tank Date: _____

PT:

Comments:

This system has been installed in compliance with applicable NC General Statutes, Rules for Sewage Treatment and Disposal, and all conditions of the Improvement Permit and Construction Authorization.

PERMIT CONDITIONS:

I. Performance: System shall perform in accordance with Rule .1961.

II. Monitoring: As required by Rule .1961.

III. Maintenance: Ground absorption sewage treatment and disposal systems shall be checked, and the contents of the septic tank removed, periodically from all compartments, to ensure proper operation of the system. The contents shall be pumped whenever the solids level is found to be more than 1/3 of the liquid depth in any compartment.

Other:

Subsurface Operator Required: ☐ Yes ☒ No

If yes, see attached sheet for additional operation conditions, maintenance and reporting.


Operation:

Other:

Authorized State Agent: Leonard, Shad

Date of Issue: 09/20/2023

Owner/Applicant: _____

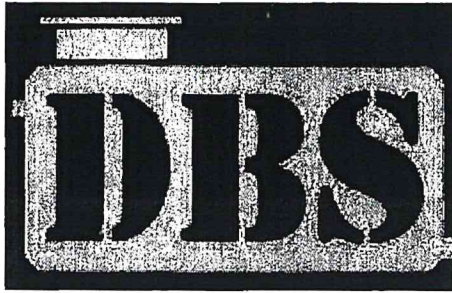

**David Brantley & Sons
Septic Tank Installation
Operation – Maintenance – Pumping**

Date: 9/19/23

RE: 139 Oswego Dr

Septic tank installed at 139 Oswego Dr met the minimum requirements of 3500 psi compressive strength before leaving the manufacturers yard.

Sincerely,

Shane Brantley

Shane Brantley

**37 Pine Ridge Rd Zebulon, NC 27597
Office: 252-478-3721 Fax: 252-478-4644
brantleyoffice@gmail.com**



File # 385226 PIN#

Property Address: 139 Oswego Dr

Applicant or Owner Name: Santiago Aguilar

Environmental Health Septic/Well Permit Diagram

Building permits cannot be issued nor should construction begin without Construction Authorization issuance.

☒ Septic Improvement Permit ☒ Septic Construction Authorization (CA) ☐ CA Reissue** ☒ As Built
☐ Well Construction Authorization ☐ Additional Diagram/Specifications Attached

Diagram Date**: 1-19-23 EHS: Joel Bendel


**Any previously dated CA diagram is revoked and/or invalid. Confirm this is the valid diagram for the site before beginning any construction.

Installation/grouting inspections may be scheduled the day before, or, the day of installation until 9am by contacting the Environmental Health office at 919 496 8100. A revisit fee may apply if installation is not ready for inspection at the time requested. Septic Operations Permits will be issued after installation is approved, all permits conditions are met, and any outstanding fees are paid. Well Certificate of Completion will be issued after well head approval, all permit conditions are met, and any outstanding fees are paid.

Septic Tank 1000 Pump Tank N/A Drainfield 3' x 300' Type System ACC Max Trench Depth 36"

Septic Contractor Busy Beez Septic/Pump tank dates DB 1000 8-31-23 Pump fee? ☒ YES ☐ NO

Well Contractor _____ Well Grout date: STB 6/16 Get letter from manufacturer

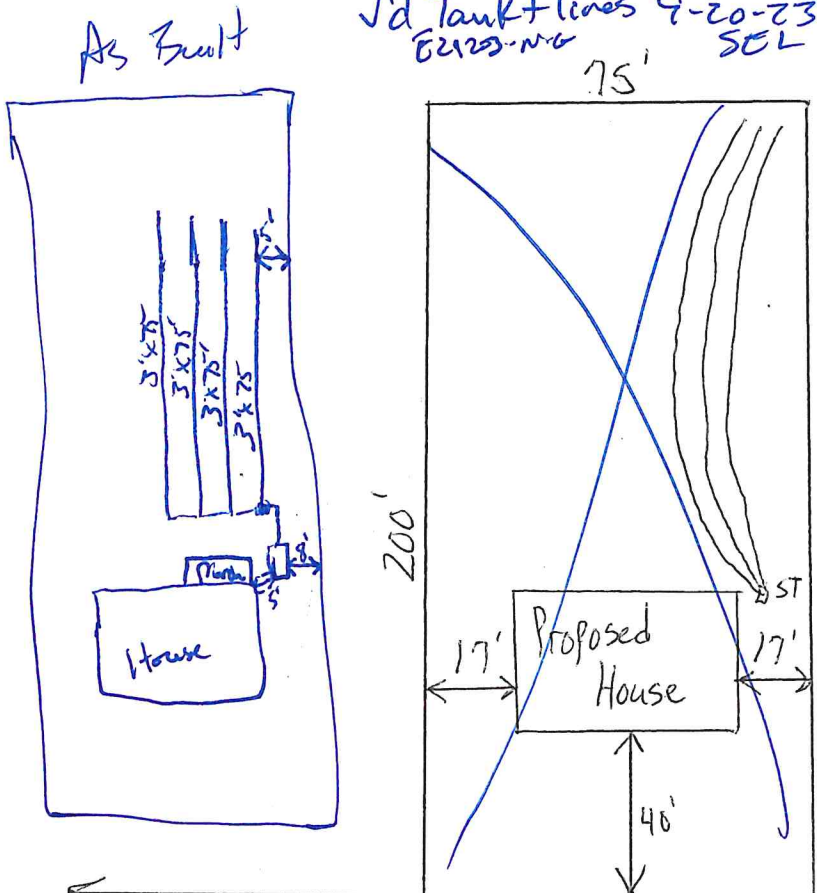

* keep lines to right → as much as possible

* 3-100' lines

OSWEGO DR.