

FRANKLIN COUNTY HEALTH DEPARTMENT

PERMIT NUMBER: 15839C	DATE: 20011012	1052 97 9158	SIZE: 0.470A
APPLICANT: CONST IMPROVE PERMIT 20011012		OWNER: STALLINGS MARGARET &	
DENMARK PO BOX 610 YOUNGSVILLE NC 27596			
TELEPHONE: 556-9007			
COMMENT: SFD		DESCRIPTION: 5 YEAR ☒	LIFETIME: ☐
LOCATION / DIRECTIONS: PIGEON POINT #51 - 105 BEAVER RIDGE DR			
FEE: 175.00		SIGNATURE OR OWNER OR AUTHORIZED AGENT:	

THE ABOVE SIGNATURE INDICATES THAT I HAVE READ, UNDERSTAND, AND AGREE WITH ALL PROVISIONS AND INFORMATION AS OUTLINED ON THE BACK SIDE OF THIS FORM

TOPO <u>PS</u>	TEXTURE <u>PS</u>	STRUCTURE <u>PS</u>	DEPTH <u>PS</u>
R. HOR <u>S</u>	SOIL. WET <u>S</u>	AVAIL. SP <u>PS</u>	OTHER _____
MINRL <u>PS</u>	OVERALL <u>PS</u>	LTAR <u>0.35</u>	
#BEDRMS <u>3</u>	GPD <u>360</u>	DISPOSAL <u>N/A</u>	TYPE. SYS <u>Pressure</u>
SZ. TANK <u>1000gal</u>	SZ. CHAMB <u>1000gal</u>	NITRIFI <u>3'x350'</u>	TYPE. WAT <u>Publ</u>
SITE. LOC _____	MAX TRENCH DEP _____	TYP. FAC <u>SFD</u>	

REMARKS: * Drawing Not to Scale

* Install Approved Pump System (Pressure Manifold)


CONTRACTOR: James Bailey

TANK MANUF: Mills

MANUF DATE: ST-61902, PT-82-02

Install Lines along Contour (System May be changed to Conv. if Gravity Flow can be achieved!)

May be Possible Pending exact home location

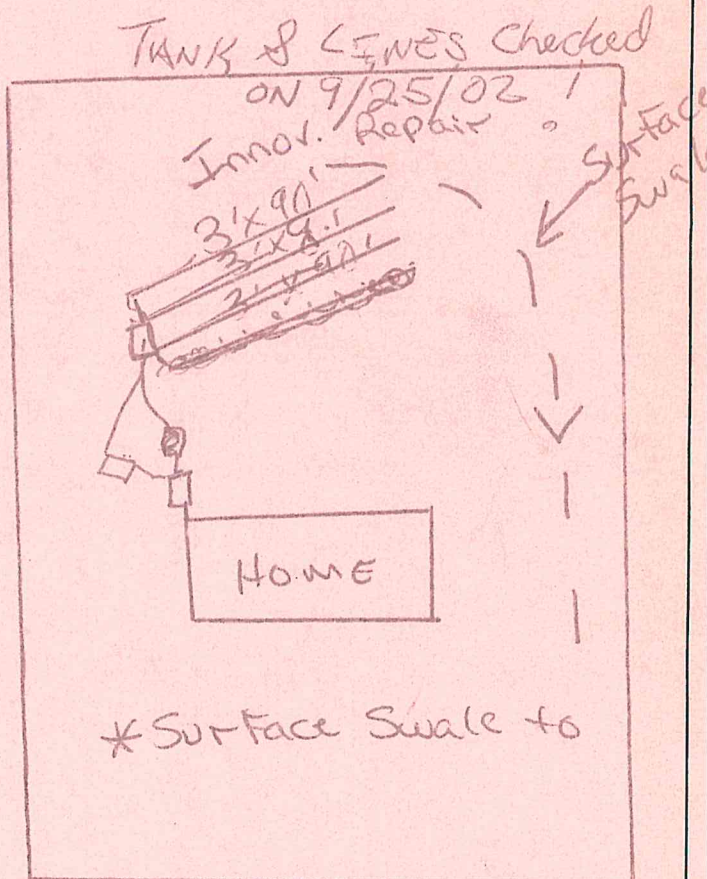

* Surface Swale to

Beaver Ridge Dr.

IMPROVEMENT PERMIT DATE: 10-15-01

CONSTRUCTION AUTHORIZATION DATE: 10-15-01

OPERATION PERMIT DATE: 11/18/02

ENV HEALTH SPEC: Andy Smith PS

ENV HEALTH SPEC: Andy Smith PS

ENV HEALTH SPEC: Andy Smith PS

COUNTY OF FRANKLIN

ENVIRONMENT HEALTH APPLICATION (496-8100)

Permit #: **5408**

Permit Type: **SEPTIC PERMIT**

Date Issued: **10/05/2001**

Project Address: **105 BEAVER RIDGE DR.,**

Location: **105 BEAVER RIDGE DR.**

Subdivision: **PIGEON POINT (WATER)**

15839C

Lot #: **51**

Size #: **0.470**

Applicant: **DENMARK:**

Post Office Box 610

Youngsville, NC 27596

Phone: **919-556-9007**

Contractor: **DENMARK**

Post Office Box 610

Youngsville, NC 27596

Phone: **919-556-9007**

Proposed Use: **SFD**

Work:

Desc:

Bldg Cost: **\$0** Fees Due: **\$175.00** Date Paid: **10/05/2001**

Zoned: **AR** Setbacks Front: **30** Rear **25** Side **10**

Tax record: **34990** Pin #: **1853-97-9158** Parcel #: **D05F00 051**

Township: **YOUNGSVILL** Public Water/Sewer: **COUNTY** ST Road #:

Special Conditions/Property Owner: **STALLINGS MARGRET &**

of bedrooms: **3** # of people: **3** Approved for Issuance by:

I certify that all the statements made in this application and any attached documents are true, complete and correct to the best of my knowledge and belief and are made in good faith. I understand that false information may be grounds for rejection of this application. Authorized county representatives are granted right of entry to make evaluations or inspections and to release information upon public request.

Call Environment Health (496-8100) between 8:00 AM and 9:00 AM Monday thru Friday to schedule an appointment with the environment health specialist to evaluate your lot. He/She will show you where to locate the well and septic system, in relation to the desired dwelling location and any property lines. If approved, an improvements permit will be issued. After the septic tank has been installed and approved, the Sanitarian will issue a certification of completion.

[Signature] Fees Are Nonrefundable

(Signature of Contractor, Authorized Agent or Owner)

10/5/01

Date

5408

Franklin County Zoning Permit

FRANKLIN COUNTY

Franklin County, North Carolina

Planning Department

215 E Nash Street, Louisburg, North Carolina 27549

496-2909

Zoning Permit Number: 1152



ADDRESS: 105 BEAVER RIDGE DR.

PARCEL NO.: 1853-97-9158

ZONING: AR

SUBDIVISION: PIGEON POINT (WATER) LOT: 51

ISSUED TO: DENMARK CONSTRUCTION

P O BOX 610

YOUNGSVILLE NC 27596

SETBACK: FRONT: 30 RIGHT: 10 LEFT: 10 REAR: 25

COUNTY WATER: COUNTY FLOODPLAIN: NO

PERMIT TYPE: ZONING PERMIT

DETAILS: SINGLE FAMILY DWELLING

PERMIT DATE: 10/04/2001

WATERSHED NO

FEE: \$0.00

TOWNSHIP YNGS

EXPIRE DATE: 04/04/2002

It is hereby certified that the above use as shown on the plats and plans submitted with the application conforms with all applicable provisions of the Franklin County Zoning Ordinance. The issuance of this Permit does not allow the violation of Franklin County Zoning Ordinances or other governing Regulations.

The applicant is responsible for obtaining a building permit (if required) prior to commencing work on the proposed improvement. A final zoning inspection must be scheduled by the applicant.

APPROVED BY:

DATE:




Zoning Inspector

10/04/2001



RIDGE DRIVE - NEW TYPE III ROAD - 50'

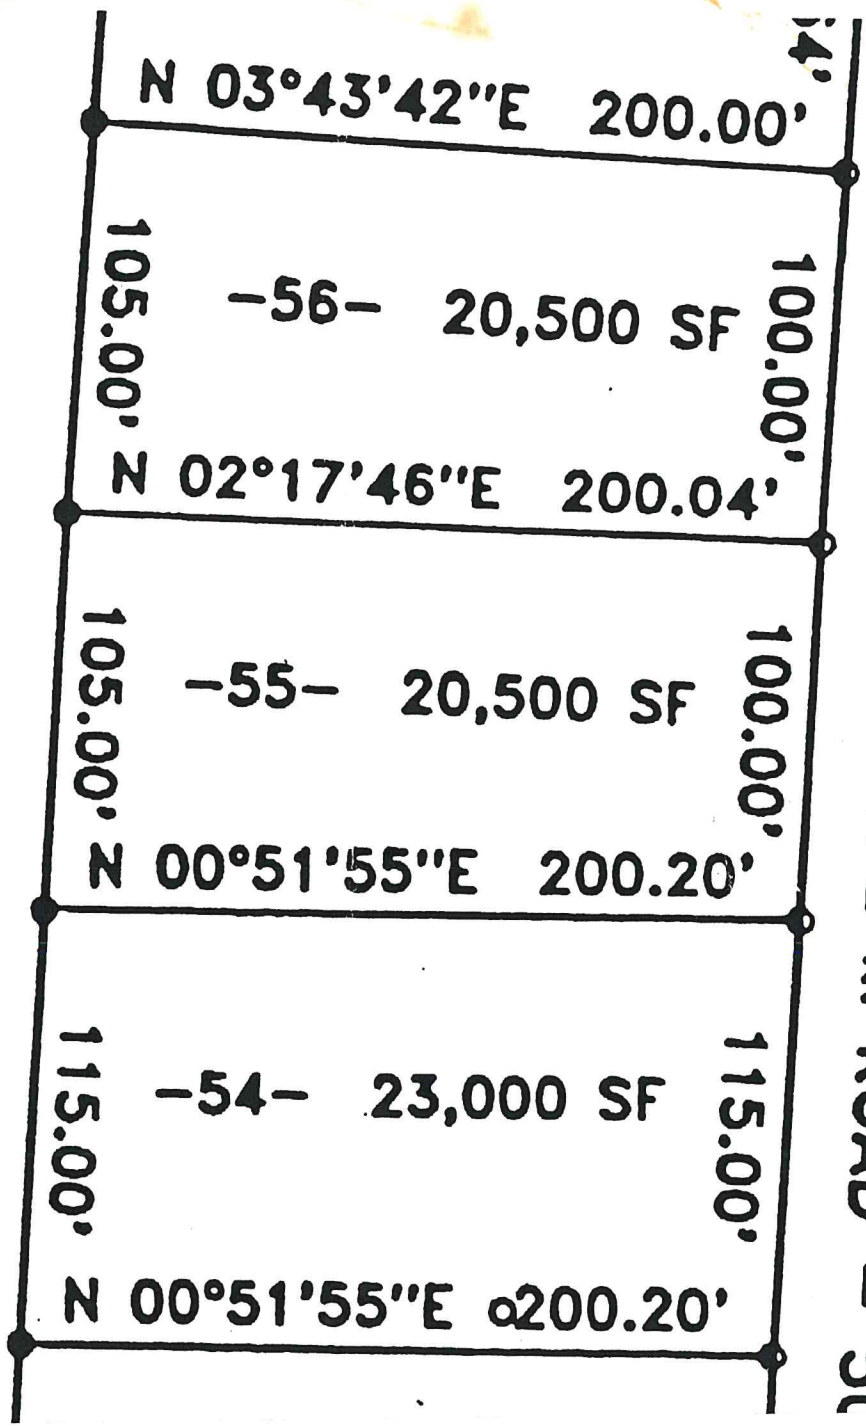

PIGTON POINT - PHASE I AND F