



File # 353928 PIN# 2826-38-4018

Property Address: 380 Perdues Rd

Applicant or Owner Name: Dylan Moore

Environmental Health Septic/Well Permit Diagram

Building permits cannot be issued nor should construction begin without Construction Authorization issuance.


☒ Septic Improvement Permit ☒ Septic Construction Authorization (CA) ☐ CA Reissue** ☒ As Built
☒ Well Construction Authorization ☐ Additional Diagram/Specifications Attached

Diagram Date**: 3-15-21 EHS: Shad Ferrell

**Any previously dated CA diagram is revoked and/or invalid. Confirm this is the valid diagram for the site before beginning any construction.

Installation/grouting inspections may be scheduled the day before, or, the day of installation until 9am by contacting the Environmental Health office at 919 496 8100. A revisit fee may apply if installation is not ready for inspection at the time requested. Septic Operations Permits will be issued after installation is approved, all permits conditions are met, and any outstanding fees are paid. Well Certificate of Completion will be issued after well head approval, all permit conditions are met, and any outstanding fees are paid.

Septic Tank 1000 Pump Tank _____ Drainfield 3'x400' Type System Accepted Max Trench Depth 30"-36"
Septic Contractor David Bentley Septic/Pump tank dates 10/24/21 Pump fee? Yes No _____
Well Contractor _____ Well Grout date: DOB 1000

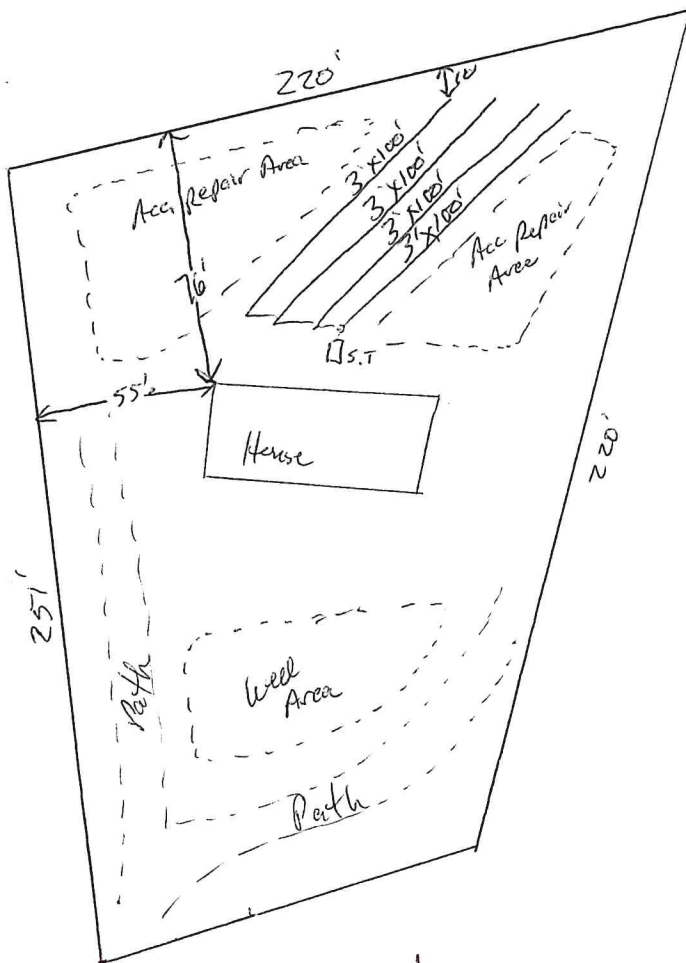

- Drawing not to scale
- Maintain proper setbacks
- Install drainlines on contour
- Layout may vary slightly
- Install drainlines @ 30"-36"

