

FRANKLIN COUNTY HEALTH DEPARTMENT

PERMIT NUMBER: <u>16028C</u>		DATE: <u>11-30-01</u>		SIZE: <u>1.060A</u>	
APPLICANT: <u>Y HOME BUILDERS GARY</u> <u>1662 FERN HOLLOW DR</u> <u>FRANKLINTON NC 27525</u>			OWNER: <u>GETOWN WOODS</u> <u>919-226-2129</u>		
TELEPHONE: <u>SPD</u>			DESCRIPTION: 5 YEAR ☒		LIFETIME: ☐
LOCATION / DIRECTIONS: <u>GEORGETOWN WOODS #51 - 150 GEORGETOWN WOODS DR</u>					
FEE: <u>175.00</u>			SIGNATURE OR OWNER OR AUTHORIZED AGENT:		

THE ABOVE SIGNATURE INDICATES THAT I HAVE READ, UNDERSTAND, AND AGREE WITH ALL PROVISIONS AND INFORMATION AS OUTLINED ON THE BACK SIDE OF THIS FORM


TOPO <u>PS</u>	TEXTURE <u>PS</u>	STRUCTURE <u>PS</u>	DEPTH <u>PS</u>
R. HOR <u>PS</u>	SOIL. WET <u>S</u>	AVAIL. SP <u>PS</u>	OTHER <u>PS</u>
MINRL <u>PS</u>	OVERALL <u>PS</u>	LTAR <u>0.35</u>	
#BEDRMS <u>4</u>	GPD <u>480</u>	DISPOSAL	TYPE. SYS <u>Conv</u>
SZ. TANK <u>1000gal</u>	SZ. CHAMB	NITRIFI <u>3'x450'</u>	TYPE. WAT <u>Publ</u>
SITE. LOC	MAX TRENCH DEP <u>24"</u>	TYP. FAC <u>SED</u>	

REMARKS: *Drawing Not to Scale

* TANK Location & System Layout May Vary Slightly!

CONTRACTOR: Triangle Pump & Tank
 TANK MANUF: E/11/05 1000gal
 MANUF DATE: 7/25/02

* Install System In Dry Conditions & Lines along Contour

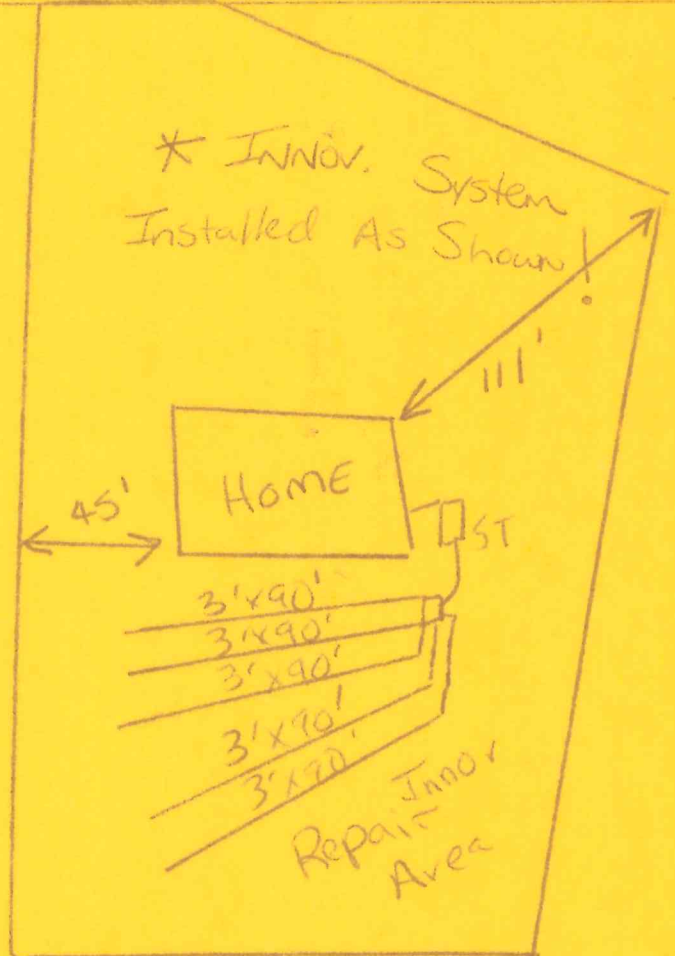

Georgetown Woods Dr.

IMPROVEMENT PERMIT DATE: 11-30-01

CONSTRUCTION AUTHORIZATION DATE: 11-30-01

OPERATION PERMIT DATE: 9/24/02

ENV HEALTH SPEC: Andy Smith
 ENV HEALTH SPEC: Andy Smith
 ENV HEALTH SPEC: Andy Smith

COUNTY OF FRANKLIN

ENVIRONMENT HEALTH APPLICATION (496-8100)

Permit #: **5814**

Permit Type: **SEPTIC PERMIT**

Date Issued: **11/27/2001**

Project Address: **150 GEORGETOWN WOODS DR.,**

Location: **150 GEORGETOWN WOODS DR.**

Subdivision: **GEORGETOWN WOODS**

Lot #: **51**

Size #: **1.060**

Applicant: **SHIPLEY HOME BUILDERS: SHIPLEY**
1662 FERN HOLLOW DRIVE
FRANKLINTON, NC 27525

Phone: **919-226-2129**

Contractor: **SHIPLEY HOME BUILDERS**
1662 FERN HOLLOW DRIVE
FRANKLINTON, NC 27525

Phone: **919-226-2129**


Proposed Use: **SFD**

Work:

Desc:

Bldg Cost: \$0	Fees Due: \$175.00	Date Paid: 11/27/2001
Zoned: CLUS	Setbacks Front: 30	Rear 25 Side 10
Tax record: 34493	Pin #: 1833-86-2356	Parcel #: B05D00 051
Township: YOUNGSVILL	Public Water/Sewer: COUNTY	ST Road #:
Special Conditions/Property Owner: GEORGETOWN WOODS		
# of bedrooms: 3	# of people: 3	Approved for Issuance by:
I certify that all the statements made in this application and any attached documents are true, complete and correct to the best of my knowledge and belief and are made in good faith. I understand that false information may be grounds for rejection of this application. Authorized county representatives are granted right of entry to make evaluations or inspections and to release information upon public request.		

Call Environment Health (496-8100) between 8:00 AM and 9:00 AM Monday thru Friday to schedule an appointment with the environment health specialist to evaluate your lot. He/She will show you where to locate the well and septic system, in relation to the desired dwelling location and any property lines. If approved, an improvements permit will be issued. After the septic tank has been installed and approved, the Sanitarian will issue a certification of completion

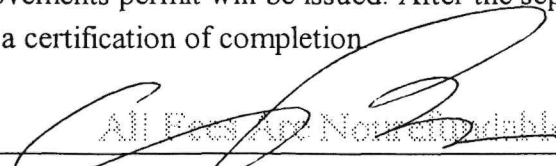
 (Signature of Contractor, Authorized Agent or Owner)

11/27/01
 Date

Franklin County Zoning Permit



FRANKLIN COUNTY

Franklin County, North Carolina

Planning Department

215 E Nash Street, Louisburg, North Carolina 27549

496-2909

Zoning Permit Number: 1345

ADDRESS: 150 GEORGETOWN WOODS DR.

PARCEL NO.: 1833-86-2356

ZONING: CLUS

SUBDIVISION: GEORGETOWN WOODS LOT: 51

ISSUED TO: SHIPLEY & BASS HOMES

1662 FERN HOLLOW DR

FRANKLINTON NC 27525

SETBACK: FRONT: 30 RIGHT: 10 LEFT: 10 REAR: 25

COUNTY WATER: NO FLOODPLAIN: NO

PERMIT TYPE: ZONING PERMIT

DETAILS: SINGLE FAMILY DWELLING

PERMIT DATE: 11/27/2001 WATERSHED NO

FEE: \$0.00 TOWNSHIP YNGS EXPIRE DATE: 05/27/2002

It is hereby certified that the above use as shown on the plats and plans submitted with the application conforms with all applicable provisions of the Franklin County Zoning Ordinance. The issuance of this Permit does not allow the violation of Franklin County Zoning Ordinances or other governing Regulations.

The applicant is responsible for obtaining a building permit (if required) prior to commencing work on the proposed improvement. A final zoning inspection must be scheduled by the applicant.

APPROVED BY:



Zoning Inspector

DATE:

11/27/2001

Owner

Shipley & Bass Homes

1662 Fern Hollow Dr

Franklinton NC 27525

919-528-6646

Lot # 51

Georgetown Woods Sub

Map Book 2001

Page # 118


(51)

46,090 sq.ft.

1.058 AC.

House 60'x60'

Scale 1"=50'

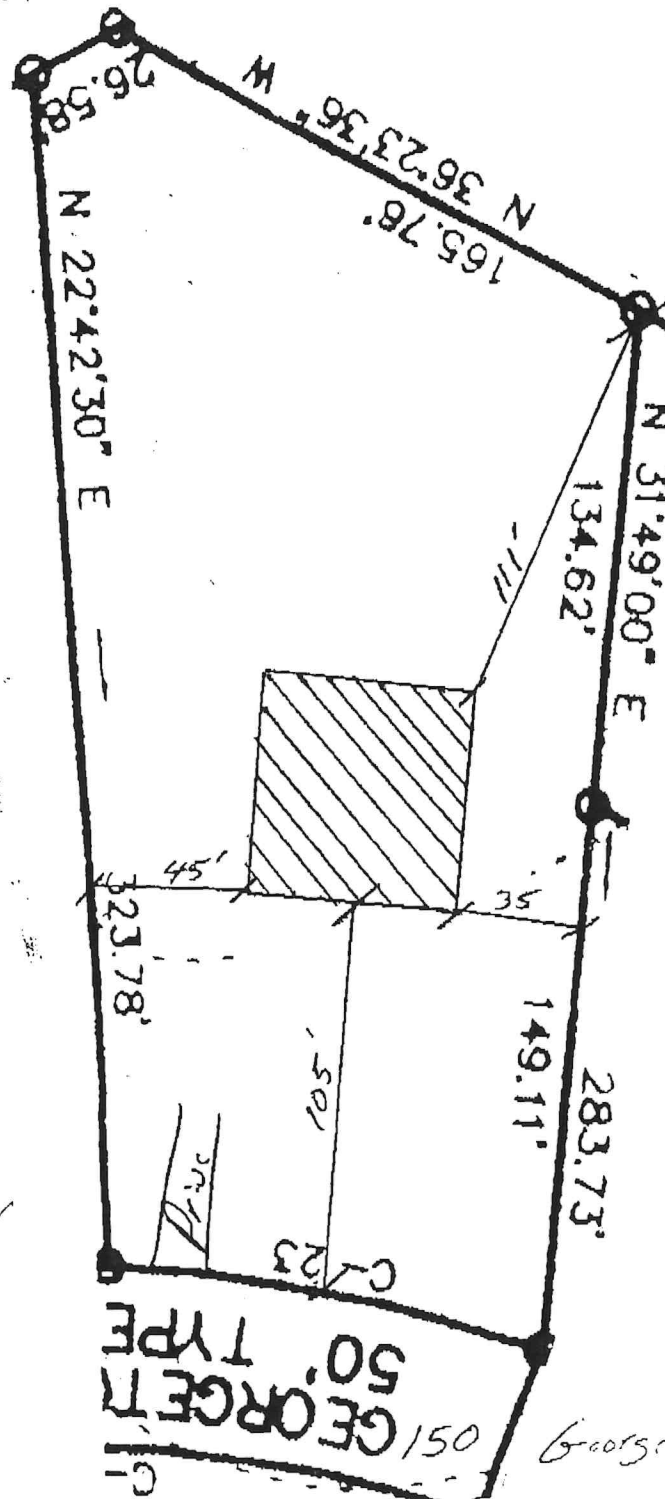

Georgetown Woods Dr