

**Franklin County Health Department
Division of Environmental Health
107 Industrial Drive-Suite C
Louisburg, North Carolina 27549**

PAGE 1 OF 2

Phone: 919-496-8100

SEPTIC PERMIT

Fax: 919-496-8136

Permit Number: 6435 Type: I PIN : 2830-53-4568 Date: 6/14/2012

Applicant: NORMAN & CATHERINE SEIFERT Owner: NORMAN & CATHERINE SEIFERT
453 MANNING RD 453 MANNING RD
SUFFOLK, VA 23434 SUFFOLK, VA 23434

Telephone: Telephone:

Subdivision: LAKE ROYALE Lot Number: 3332 Size: 0.490

Physical Address/ Location /Directions 109 RUSTLER RD

Description: LifeTime _____ 5 Year X

TYPE FACIL SFD # EMPLOY 1 # BEDRMS 3 GPD 360 LTAR 3 3/4
TYPE WAT PGM TYPE SYS A TYPE REP P10A BSMT N BST FX NA
SIZE TANK 900 SIZE CHB 1 SIZE NTR 3x300 MTD 30'

COMMENTS: 300' Accepted drainline

Septic Contractors are responsible for notifying the health department for final inspections, between 8:00-9:00 AM on the day of completion, Monday - Friday. Any request for final inspections received afterwards will be scheduled the same day, if possible, or the next workday. Have permit number and owner/applicant's name ready when making the call.

Actions of representatives of state or local agencies engaged in the evaluation and determination of measures required to effect the compliance with the provisions of this permit shall in no way be taken as a guarantee that wastewater disposal systems permitted and approved will function in a satisfactory manner for any given period of time, or that such employees assume any liability for damages, consequential or direct which are caused, or may be caused, by a malfunction of this wastewater treatment and disposal system.

Proper precautions must be taken to assure the proper functioning of the system after it has been covered. Do not run any heavy equipment over the system, as soft earth will allow damage to the tank and lines. Pipe all roof drains away from the septic system site to prevent flooding of the lines from surface water. Terrace the ground to prevent excessive drainage from higher areas adjacent to the system. Do not construct driveways over any part of the septic system unless proper provisions were made when the septic system was constructed. Only grass, not trees or shrubbery, should be cultivated over the lines. All plumbing fixtures should be carefully inspected periodically and any problems repaired immediately. All septic tanks should be pumped off by a permitted pump operator on a regular schedule, not to exceed every five years.

The improvement permit and construction authorization is a site approval, for the future installation of a wastewater treatment and disposal system. Changes in ownership of the site do not affect the validity of this permit. However, any alteration of the site or soil conditions, changes in the location of the proposed facility, changes to the wastewater flow and/or characteristics, or submittal of false information with the application or misrepresentation of the property lines may subject this permit to suspension or revocation.

FOR THIS TO BE A VALID CONSTRUCTION AUTHORIZATION, A LAYOUT SHEET MUST BE ATTACHED

IMPROVEMENT PERMIT DATE 6/25/12 EHS [Signature]
CONSTRUCTION AUTHORIZATION DATE 6/25/12 EHS [Signature]

Visit www.franklincountyenvironmentalhealth.com for permit information and tracking.

Franklin County Health Department

Name: SEIFERT


Permit Number

6435

CONTRACTOR David Beatty TANK MANU Dt 31000 MANU DATE 7/19/12

WELL INSTALLED YES ☐ NO ☐ SYSTEM CODE E21203

SEPTIC SYSTEM LAYOUT (SKETCH SYSTEM LAYOUT HERE)

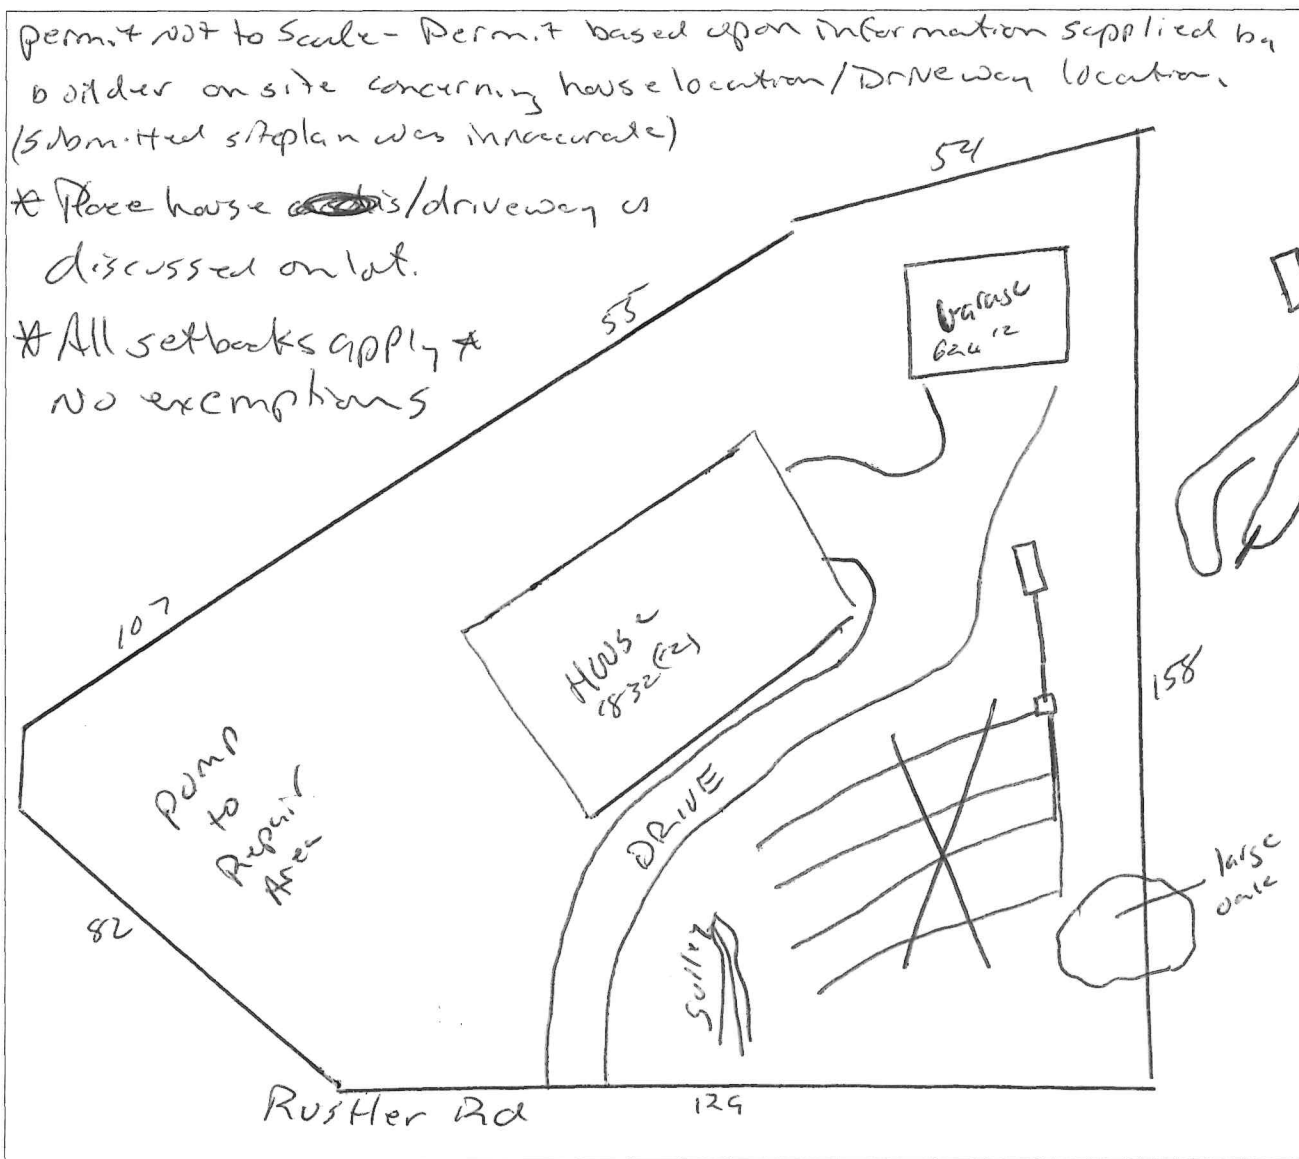

SEPTIC SYSTEM AS-BUILT

(IF DIFFERENT FROM INITIAL LAYOUT)

ON REVERSE

OPERATIONS PERMIT

DATE

11/20/12

EHS

[Signature]

COUNTY OF FRANKLIN

ENVIRONMENT HEALTH APPLICATION (496-8100)

Permit #: 31841

Permit Type: SEPTIC PERMIT

Date Issued: 06/14/2012

Project Address: 109 RUSTLER RD, LOUISBURG NC 27549

Location: 109 RUSTLER RD

Size #: 0.490

Subdivision: LAKE ROYALE

Lot #: 3332

Applicant: SEIFERT NORMAN H & CATHERINE S
453 MANNING RD
SUFFOLK VA 23434

Phone:

Owner Name: SEIFERT NORMAN H & CATHERINE S

Phone:

Owners Address: 453 MANNING RD

SUFFOLK VA 23434

Tax record: 25491

Pin #: 2830-53-4568

Parcel #: LR1602 3332

Zoned: R-1

Setbacks Front: 30

Rear: 25

Side: 10

Proposed Use: SFD

of bedrooms: 3

of people: 3

Township: CYPRESS

Public Water/Sewer: TESI (LK ROY)

ST Road #:

Desc:

Fees Due: \$325.00

Date Paid: 06/14/2012

* Please complete all sections below *

- ☐ Yes ☒ No Does this site contain any previously identified jurisdictional wetlands?
☐ Yes ☒ No Is any wastewater, other than domestic, going to be generated?
☐ Yes ☒ No Is the site subject to approval by any other public agency?

*If the answer to any of the above is "yes", applicant must submit supporting documentation.

Please indicate desired system type(s). Systems can be ranked in order of preference.

☐ Conventional ☐ Accepted ☐ Modified Conventional ☐ Alternative
☐ Other ☒ No Preference

Call Environmental Health (919.496.8100) between 8:00 - 9:00 am Monday - Friday in order to schedule an appointment with an environmental health specialist for your lot evaluation. This application for an improvement permit/construction authorization and well permit does not constitute approval for zoning, septic or building permits. It will be necessary to meet all guidelines for zoning, septic and building permits prior to construction. The permit is valid for either 60 months or without expiration, depending upon documentation submitted. (complete site plan= 60 months---complete surveyed plat=without expiration.)

Please contact the Environmental Health Department at 919.496.8100 or visit their website at www.franklincountyenvironmentalhealth.com to determine the status of your application prior to visiting the Planning & Inspections Department to obtain a building permit.

I hereby certify that I am the owner, or authorized by the owner to act as his/her legal representation. Furthermore, as legal representative (if applicable) I have advised the owner of my intention to apply for this wastewater treatment and disposal system and drinking water and well system permit.

I also certify that all of the statements made in this application and any attached documents are true, complete, and correct, to the best of my knowledge and belief, and are made in good faith. If information in this application for these improvements is falsified, changed or site is altered, then improvement permits and authorization to construct these improvements shall become invalid. Authorized county representatives are granted right of entry to make these evaluations or inspections, and to release information upon public request.

X

06/14/2012

Print & Signature of Owner or Owner's Legal Representative

Franklin County Development Permi

RESIDENTIAL

Zoning Permit #: 16674



ADDRESS: 109 RUSTLER RD
 PARCEL NO.: 2830-53-4568 ZONING: R-1
 SUBDIVISION: LAKE ROYALE LOT: 3332
 ISSUED TO: SEIFERT NORMAN H & CATHERINE S
 9007 LAKE ROYALE
 LOUISBURG NC 27549
 PHONE NUMBER: 252-478-9900
 SETBACK: FRONT: 30 RIGHT: 10 LEFT: 10 REAR: 25
 COUNTY WATER: TESI FLOODPLAIN: NO MISC FEE:
 PERMIT TYPE: ZONING PERMIT
 TYPE OF CONSTRUCTION: SFD - NEW SEPTIC
 PERMIT DATE: 06/14/2012 WATERSHED NO
 TOWNSHIP CYP EXPIRE DATE: 12/14/2012

It is hereby certified that the above use as shown on the plats and plans submitted with this application conforms with all applicable provisions of the Franklin County Zoning Ordinance. The issuance of this application does not allow the violation of Franklin County Zoning Ordinance or other governing regulations. The applicant is responsible for obtaining a building permit (if required) prior to commencing work on the proposed improvement. A final zoning inspection must be scheduled by the applicant.

NOTES:

I hereby certify that all information I have provided to the Planning Department is true and accurate.

APPLICANTS SIGNATURE:

[Signature]

UTILITY COMPANY: PROGRESS ENERGY WAKE ELECTRIC OTHER

NUMBER OF STORIES: 1 _____ 1 1/2 _____ 2 _____ 2 1/2 _____
 SQUARE FOOTAGE: HEATED _____ UNHEATED _____ TOTAL _____
 BASEMENT: YES _____ NO _____
 FIREPLACE: NO _____ MASONRY _____ MANUFACTURED _____
 PLAN SETS: MODULAR _____ STICKBUILT _____

NAME OF:

ELECTRICIAN: _____ MECHANICAL: _____

PLUMBING: _____

COST OF CONSTRUCTION: _____

NO MORE THAN 2 STRUCTURAL DEVIATIONS OR PLANS MUST BE REDRAWN

DEPARTMENTAL USE ONLY

	INITIALS (IN)	DATE	INITIALS (OUT)	DATE
ZONING	<i>[Signature]</i>	6/14/12		
INITIAL PERMITTING				
ADDRESSING				
PLAN REVIEW				
FIRE REVIEW				
SEPTIC/SEWER				
FINAL PERMITTING				

LOT 3354

RUSTLER RD

RUSTLER RD

(1017.1 MIN)

CONCRETE

129

FIELD
←

150

019282

019282

019904

54


210

004778

022998

200

10' SIDE + REAR SETBACK
25' REAR SETBACK @ HOUSE

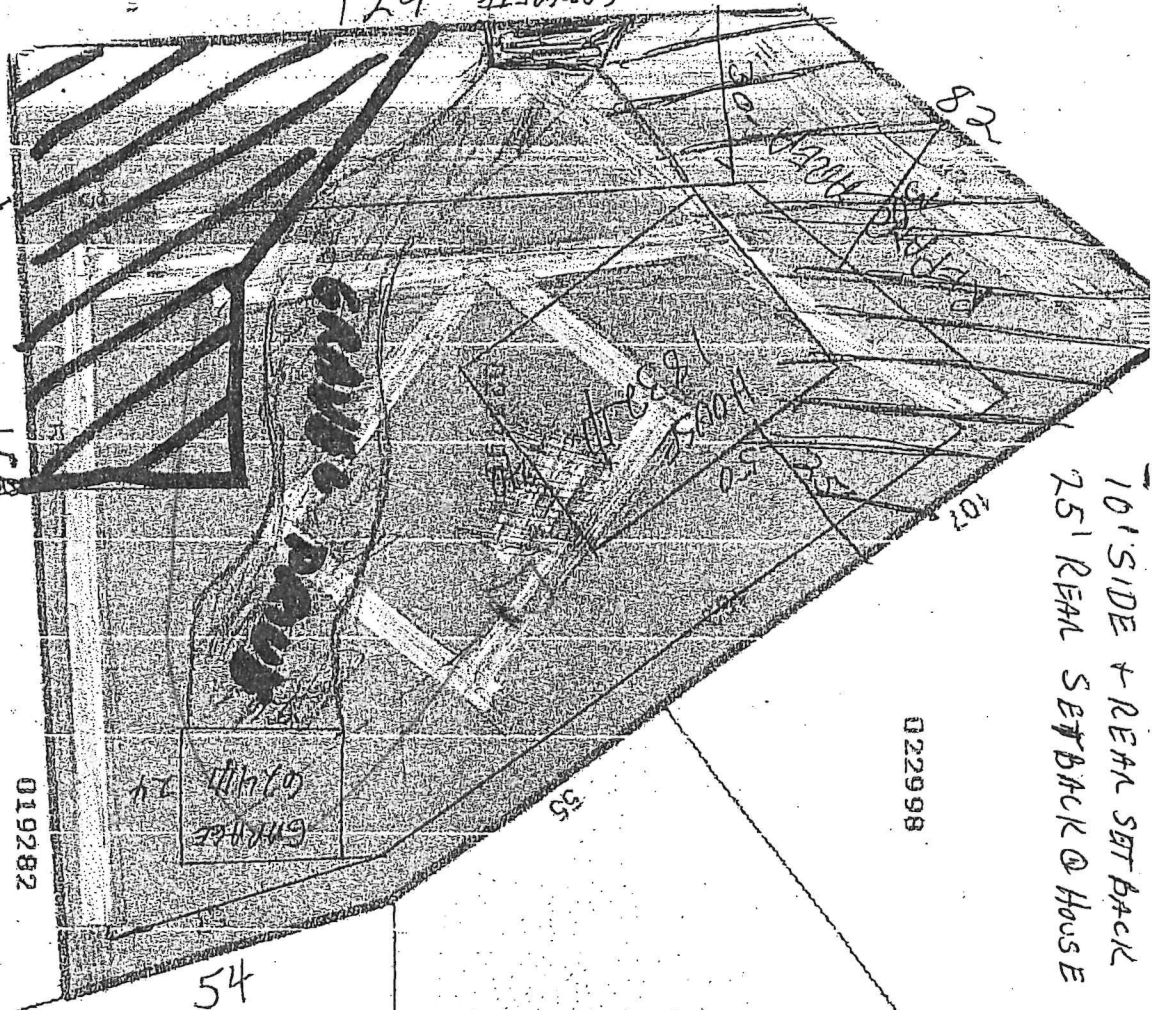

APPLICANT Norman Se. Park
WATER SUPPLY Com
LOCATION/DIRECTIONS Lake Road

LOCATION/DIRECTIONS Lake Royale 333212

PROFILES

		1	2	3	4	5	6
LANDSCAPE POSITION	1940	SS					
SLOPE (%)	1940						
HORIZON I DEPTH	1943	0-4					
TEXTURE	1941(a) (1)	S, Z					
CONSISTENCE	1941						
STRUCTURE	1941(a)(2)	/					
CLAY MINEROLOGY	1941(a)(3)						
HORIZON II DEPTH	1943	4-44					
TEXTURE	1941(a) (1)	C					
CONSISTENCE	1941	F, S, P					
STRUCTURE	1941(a)(2)	FBK					
CLAY MINEROLOGY	1941(a)(3)	SEP					
HORIZON III DEPTH	1943						
TEXTURE	1941(a) (1)						
CONSISTENCE	1941						
STRUCTURE	1941(a)(2)						
CLAY MINEROLOGY	1941(a)(3)						
HORIZON IV DEPTH	1943						
TEXTURE	1941(a) (1)						
CONSISTENCE	1941						
STRUCTURE	1941(a)(2)						
CLAY MINEROLOGY	1941(a)(3)						
SOIL WETNESS	1941	-					
RESTRICTIVE HORIZON	1944	-					
SAPROLITE	1943/1956	-					
CLASSIFICATION	1948	PS					
LTAR (gpd/ft ²)	1955	.35					
OTHER FACTORS (1946)	1951		SITE LTAR (gpd/ft ²) .35				
AVAILABLE SPACE (1945)	1951	SYSTEM TYPE A					
CLASSIFICATION (1948)	PS	OTHERS PRESENT none					
EVALUATED BY:	TW						