

FRANKLIN COUNTY HEALTH DEPARTMENT


Lot 38
KEIGHLEY

PERMIT NUMBER: 12760C	CONST IMPROVE PERMIT	DATE: 05.27.99	31380	SIZE: .92A
APPLICANT: KIRTS CUSTOM HOMES 7716 NICKLEWAITE CT WAKE FOREST NC 27587 TELEPHONE: COMMENT: 556-4177		OWNER: KIRTS DARREN & CECELIA		
LOCATION / DIRECTIONS: KEIGHLEY FOREST #38		DESCRIPTION: 5 YEAR ☒		LIFETIME: ☐
FEE: 125.00 11837		SIGNATURE OR OWNER OR AUTHORIZED AGENT:		

THE ABOVE SIGNATURE INDICATES THAT I HAVE READ, UNDERSTAND, AND AGREE WITH ALL PROVISIONS AND INFORMATION AS OUTLINED ON THE BACK SIDE OF THIS FORM

TOPO	TEXTURE PS	STRUCTURE PS	DEPTH PS
R. HOR S	SOIL. WET S	AVAIL. SP S	OTHER /
MINRL /	OVERALL PS	LTAR .35	
#BEDRMS 3	GPD 360	DISPOSAL /	TYPE. SYS Sh. Conv.
SZ. TANK 900	SZ. CHAMB /	NITRIFI 34400	TYPE. WAT Private
SITE. LOC	MAX TRENCH DEP 30	TYP. FAC SFD	

REMARKS: 100' from well, 10' from prop. lines, 5' from foundation, Run Lines w/ contour

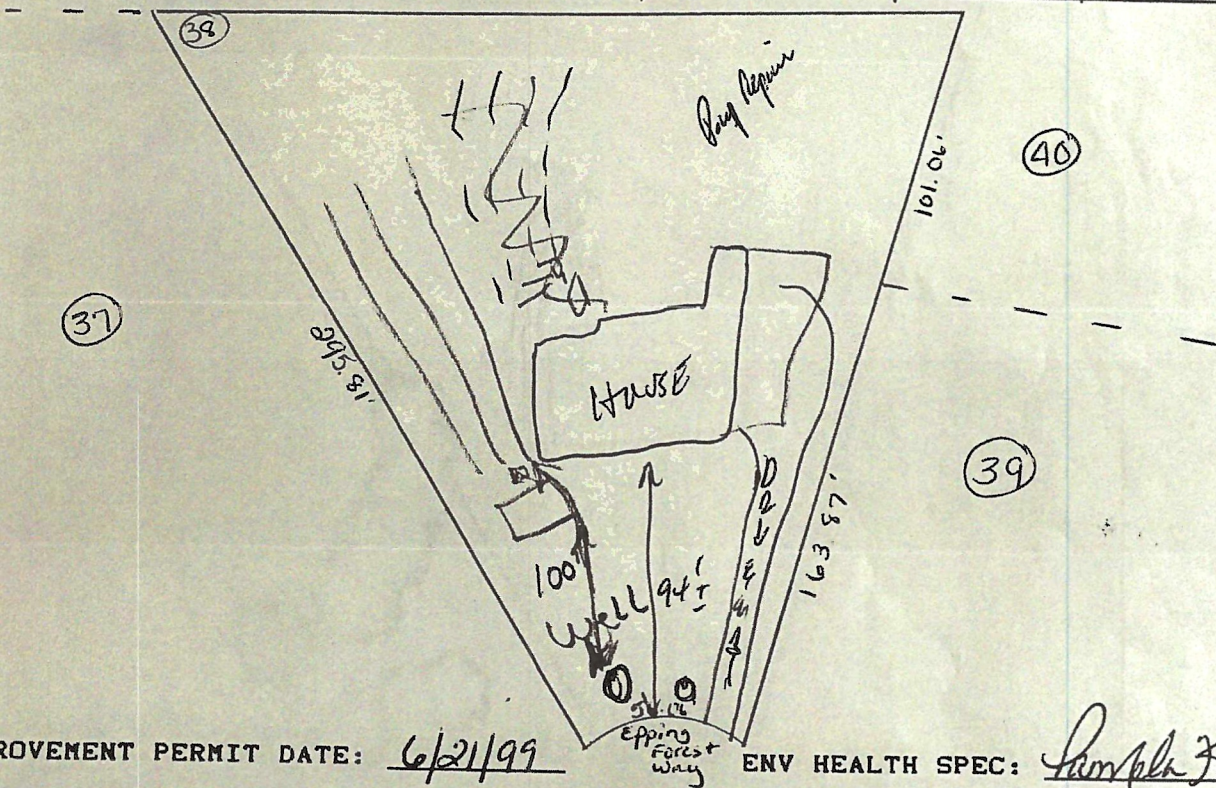

IMPROVEMENT PERMIT DATE: 6/21/99

ENV HEALTH SPEC: Samuel F. Graybeal

CONSTRUCTION AUTHORIZATION DATE: 6-30-99

ENV HEALTH SPEC: Chris Bell

OPERATION PERMIT DATE: 10/28/99

ENV HEALTH SPEC: Debra Funder